

— WORK ORDERED BY —
DALE ALBRECHT
W8407 LAKE SHORE ROAD
SHARON WI, 53585

FARRIS, HANSEN & ASSOCIATES, INC.
ENGINEERING — ARCHITECTURE — SURVEYING
7 RIDGWAY COURT P.O. BOX 437
ELKHORN, WISCONSIN 53121
OFFICE: (262) 723-2088 FAX: (262) 723-5886

REVISIONS
08/23/17-SB
ORIGINAL DRAFT
01/22/2018 - LB
AS BUILT

PROJECT NO.
9708
DATE
08/22/17
SHEET NO.
1 OF 1

PLAT OF SURVEY — AS BUILT


PART OF THE SW 1/4 OF THE NE 1/4 OF
SECTION 19, TOWN 4 NORTH, RANGE 17 EAST,
WALWORTH COUNTY, WISCONSIN

LOT 2
C.S.M. 183

ZIMMERMAN ROAD
{66' WIDE R.O.W.}

STATE TRUNK HIGHWAY "20"
{VARIABLE WIDTH R.O.W.}

AS BUILT
RESIDENCE


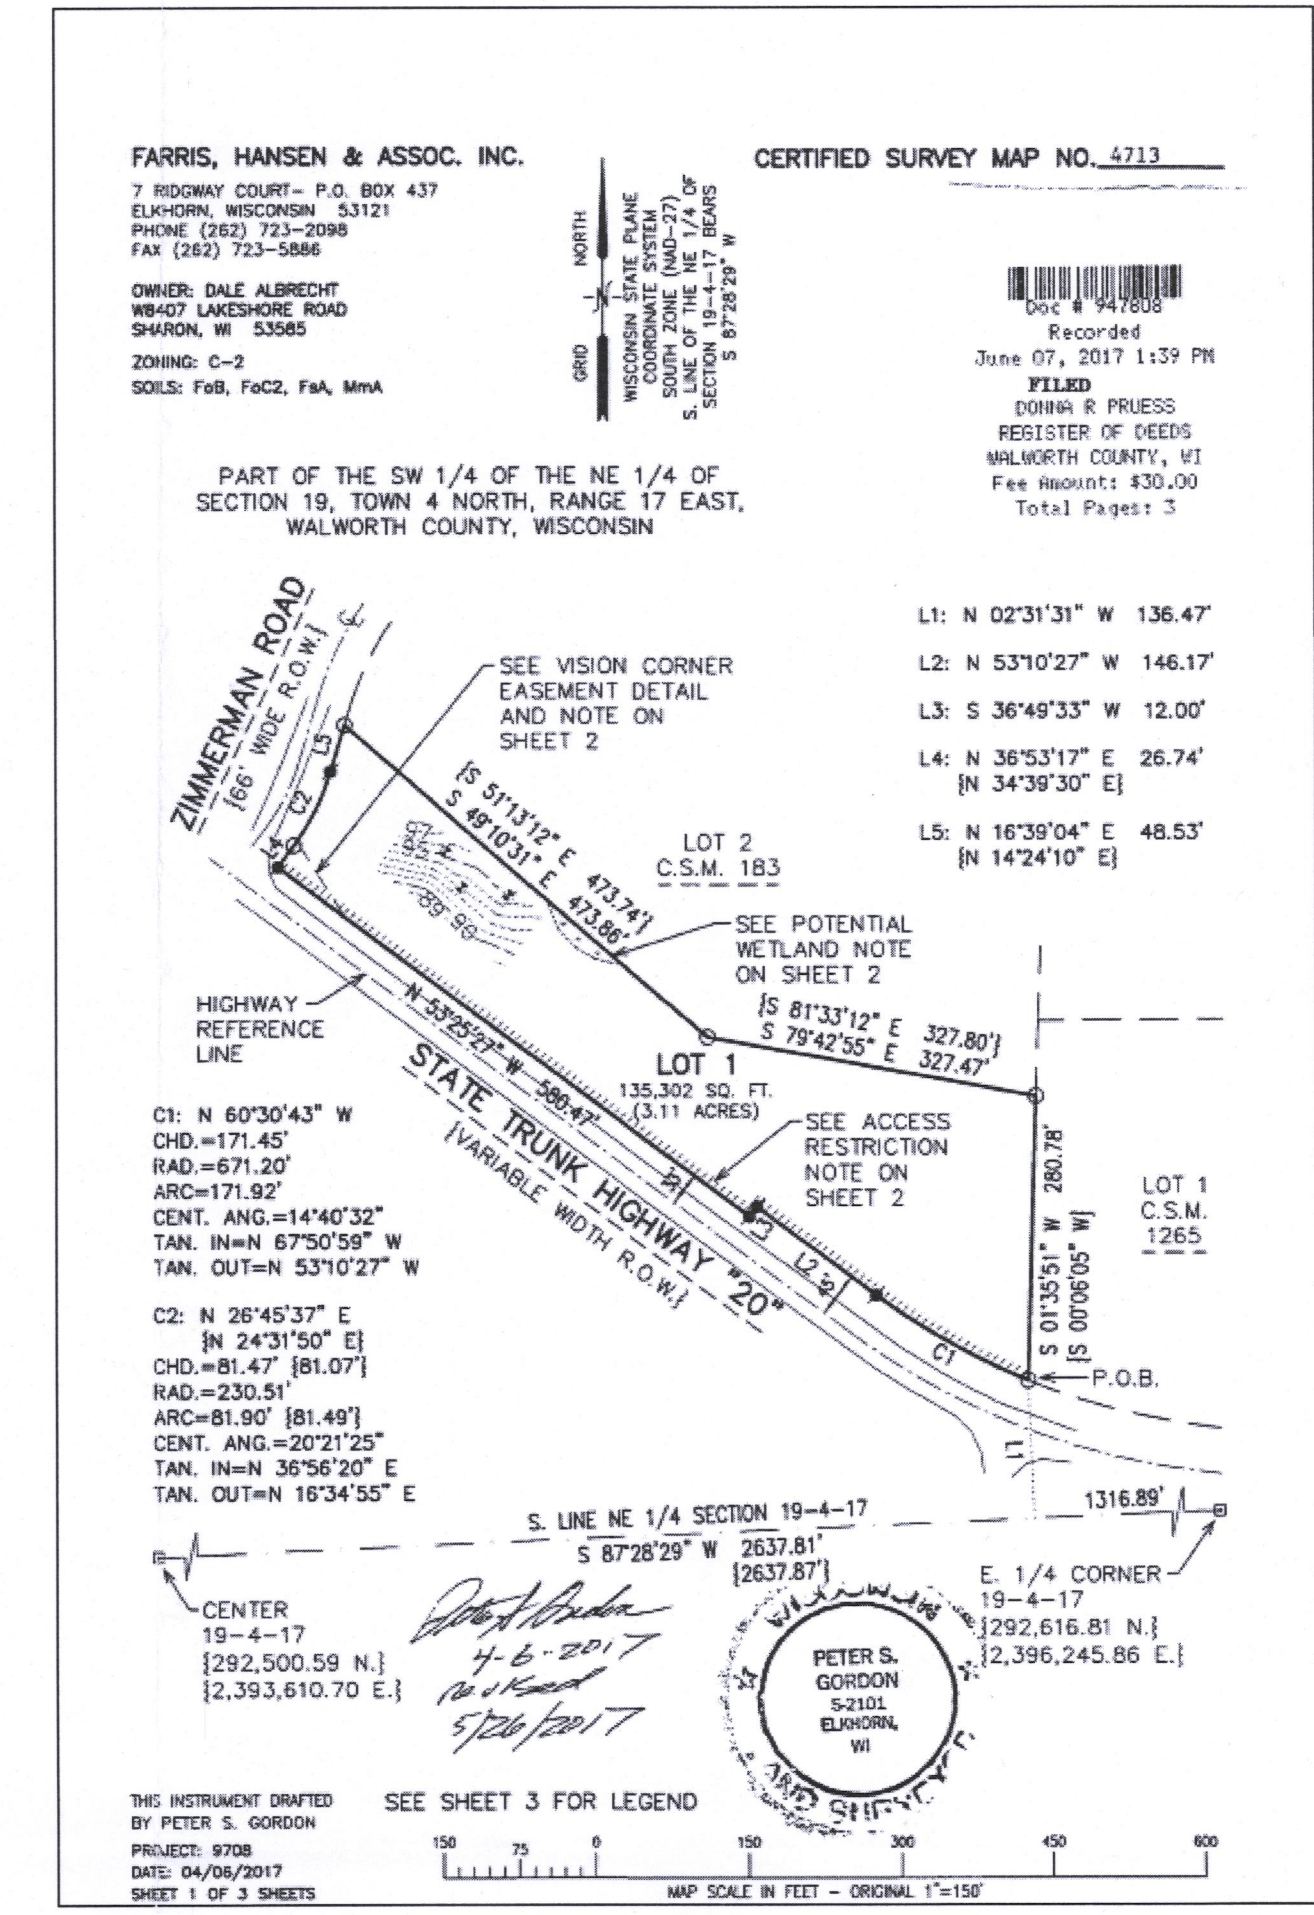


NOTE: COPIES OF THIS MAP TO WHICH THE FOLLOWING CERTIFICATE WILL APPLY SHOW
THE SURVEYOR'S ORIGINAL SEAL AND SIGNATURE IN RED INK. COPIES BY ANY OTHER
MEANS MAY HAVE ALTERATIONS WHICH DO NOT REPRESENT THE SURVEYOR'S WORK
PRODUCT.

I HEREBY CERTIFY THAT THE ABOVE DESCRIBED PROPERTY HAS BEEN SURVEYED
UNDER MY DIRECTION AND THAT THE ABOVE MAP IS A TRUE REPRESENTATION
THEREOF AND SHOWS THE SIZE AND LOCATION OF THE PROPERTY AND ITS EXTERIOR
BOUNDARIES. THIS SURVEY IS MADE FOR THE USE OF THE PRESENT OWNERS OF THE
PROPERTY, AND ALSO THOSE WHO PURCHASE, MORTGAGE, OR GUARANTEE THE TITLE
THERETO WITHIN ONE YEAR FROM THE DATE HEREOF.

DATED: 01/22/2018

BRIAN M. CARLSON P.L.S. 2039

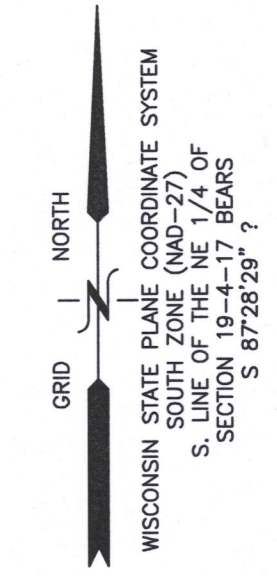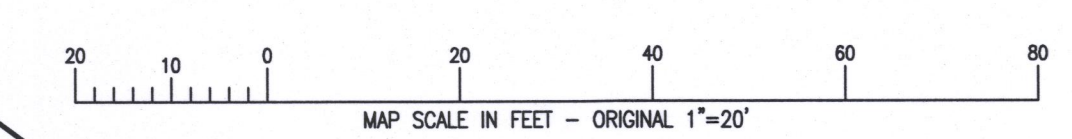

X:\Projects\9708\ACAD\9708.DWG