



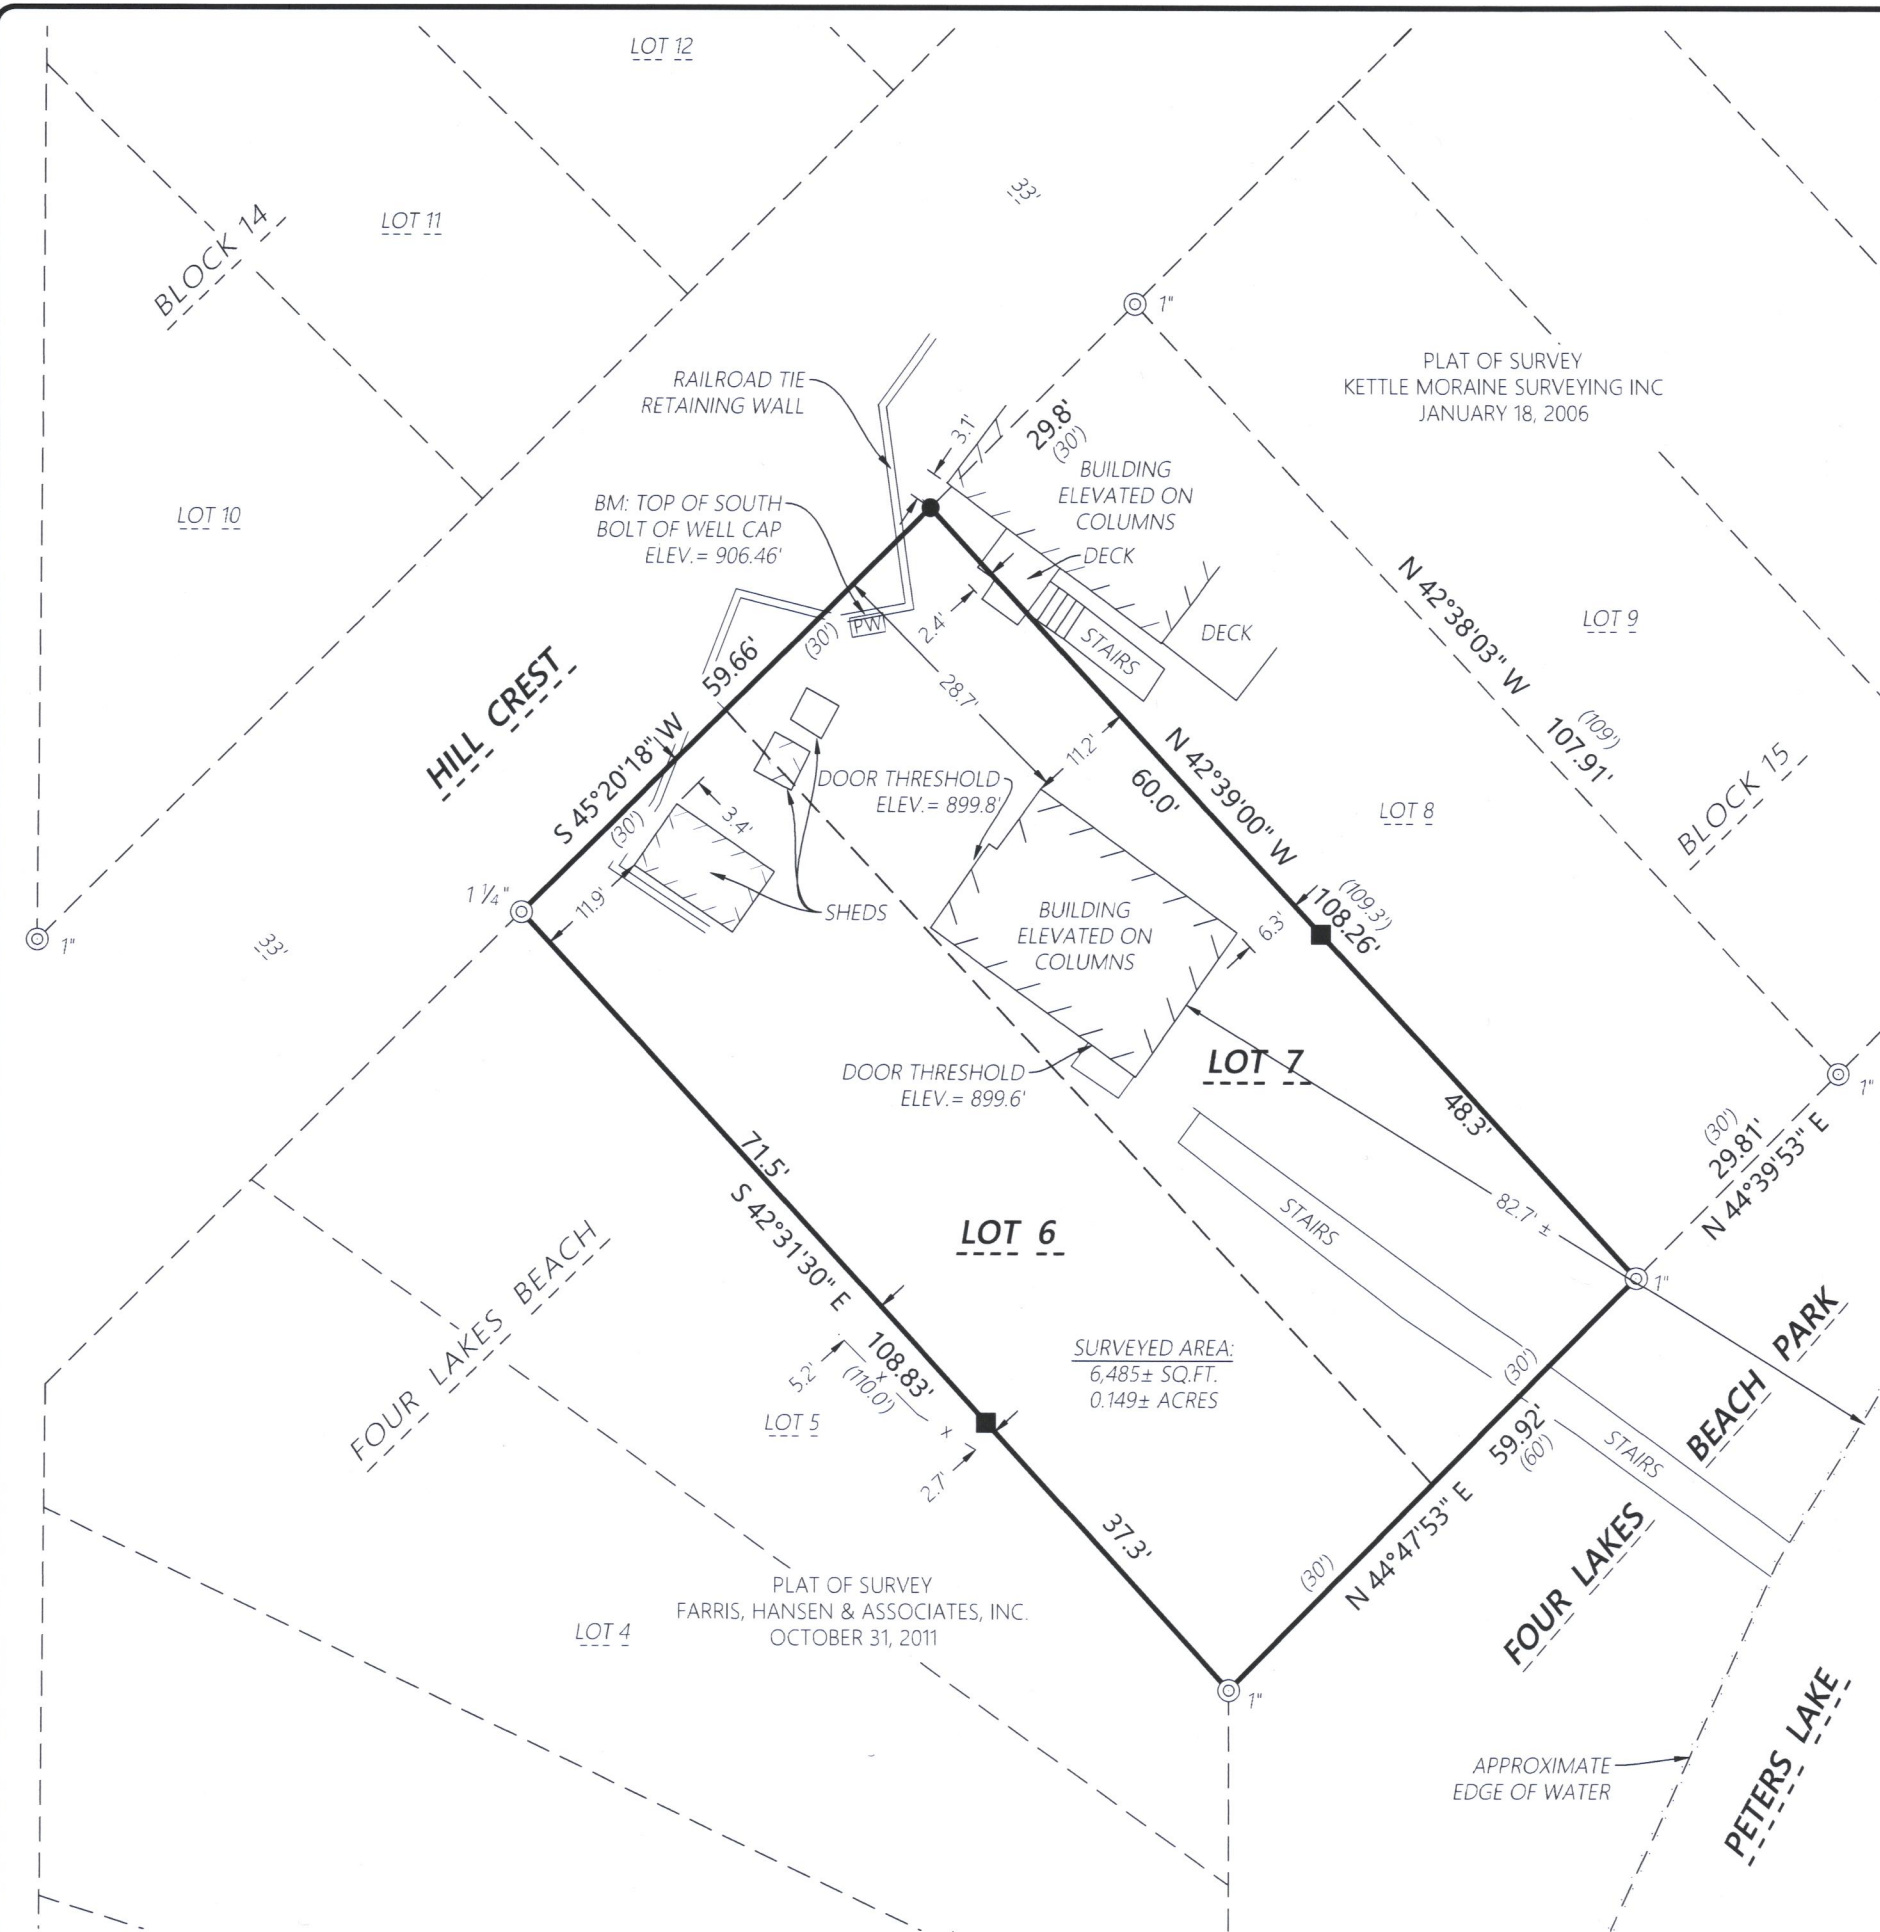


PLAT OF SURVEY
OF LOTS 6 & 7, BLOCK 15, FOUR LAKES BEACH, BEING
PART OF THE SW 1/4 OF THE SW 1/4 OF SECTION 8,
T. 4 N., R. 17 E., OF THE 4TH P.M., TOWN OF TROY,
WALWORTH COUNTY, WISCONSIN.

- MONUMENT KEY**
- Iron Rebar Set
3/4" x 24" (1.5 Lbs./Ft.)
 - ⊙ 3/4" Iron Rebar Found
 - ⊙ Iron Pipe Found
 - Wooden Lath Set on Line
 - (XXX.XX) Record Information

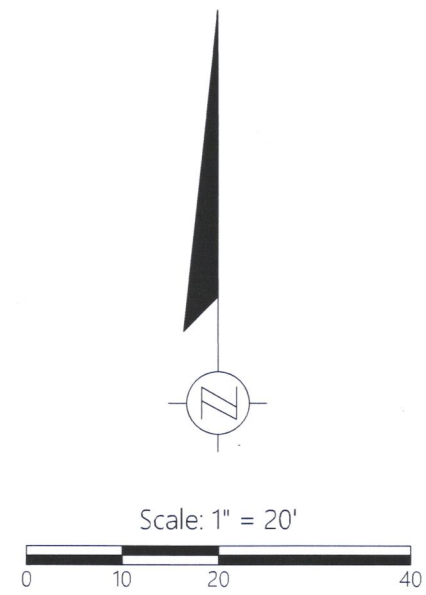

DISTANCE UNITS BASED ON THE UNITED STATES SURVEY FOOT
BEARINGS BASED ON THE WISCONSIN COORDINATE REFERENCE
SYSTEM, WALWORTH ZONE. THE SOUTHWESTERLY LINE OF LOT 6
BEARING S 42°31'30" E
VERTICAL DATUM BASED ON NAVD-88 (2012)
STARTING BENCHMARK: PARO

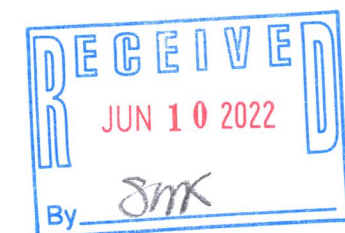

Kristin J Belongia

Kristin J. Belongia, P.L.S.
Wisconsin Professional Land Surveyor S-2943

State of Wisconsin } ss
County of Walworth }

If the surveyor's signature is not red in color,
the plan is a copy that should be assumed to
contain unauthorized alterations.
The certification contained on this document
shall not apply to any copies.

I hereby certify that I have supervised the survey of the property described above and to the best
my knowledge and belief, the plat drawn hereon complies with Chapter A-E 7 of the State of
Wisconsin Administrative Code, Minimum Standards for Property Surveys and correctly
represents said survey and its location.
Given under my hand and seal this 14th day of February, 2022 at Elkhorn, Wisconsin.
Last day of field work : February 7th, 2022



Batterman
engineers surveyors planners
2857 Bartells Drive
Beloit, Wisconsin 53511
608.365.4464

PLAT OF SURVEY

FOR THE EXCLUSIVE USE OF:
JEFF POIROIR
1632 Rushmore Drive
Waukesha, WI 53186

ORDER NO: 34205
BOOK: SEE FILE
FIELD CREW: DGM
DRAWN BY: DGM
DATE: 2/12/22

LFL-42

417-1149