


RONALD H. ZIMMERMAN
REGISTERED LAND SURVEYOR

Douglas Hay

PLAT OF SURVEY

FOR

WAUKESHA SAVINGS & LOAN

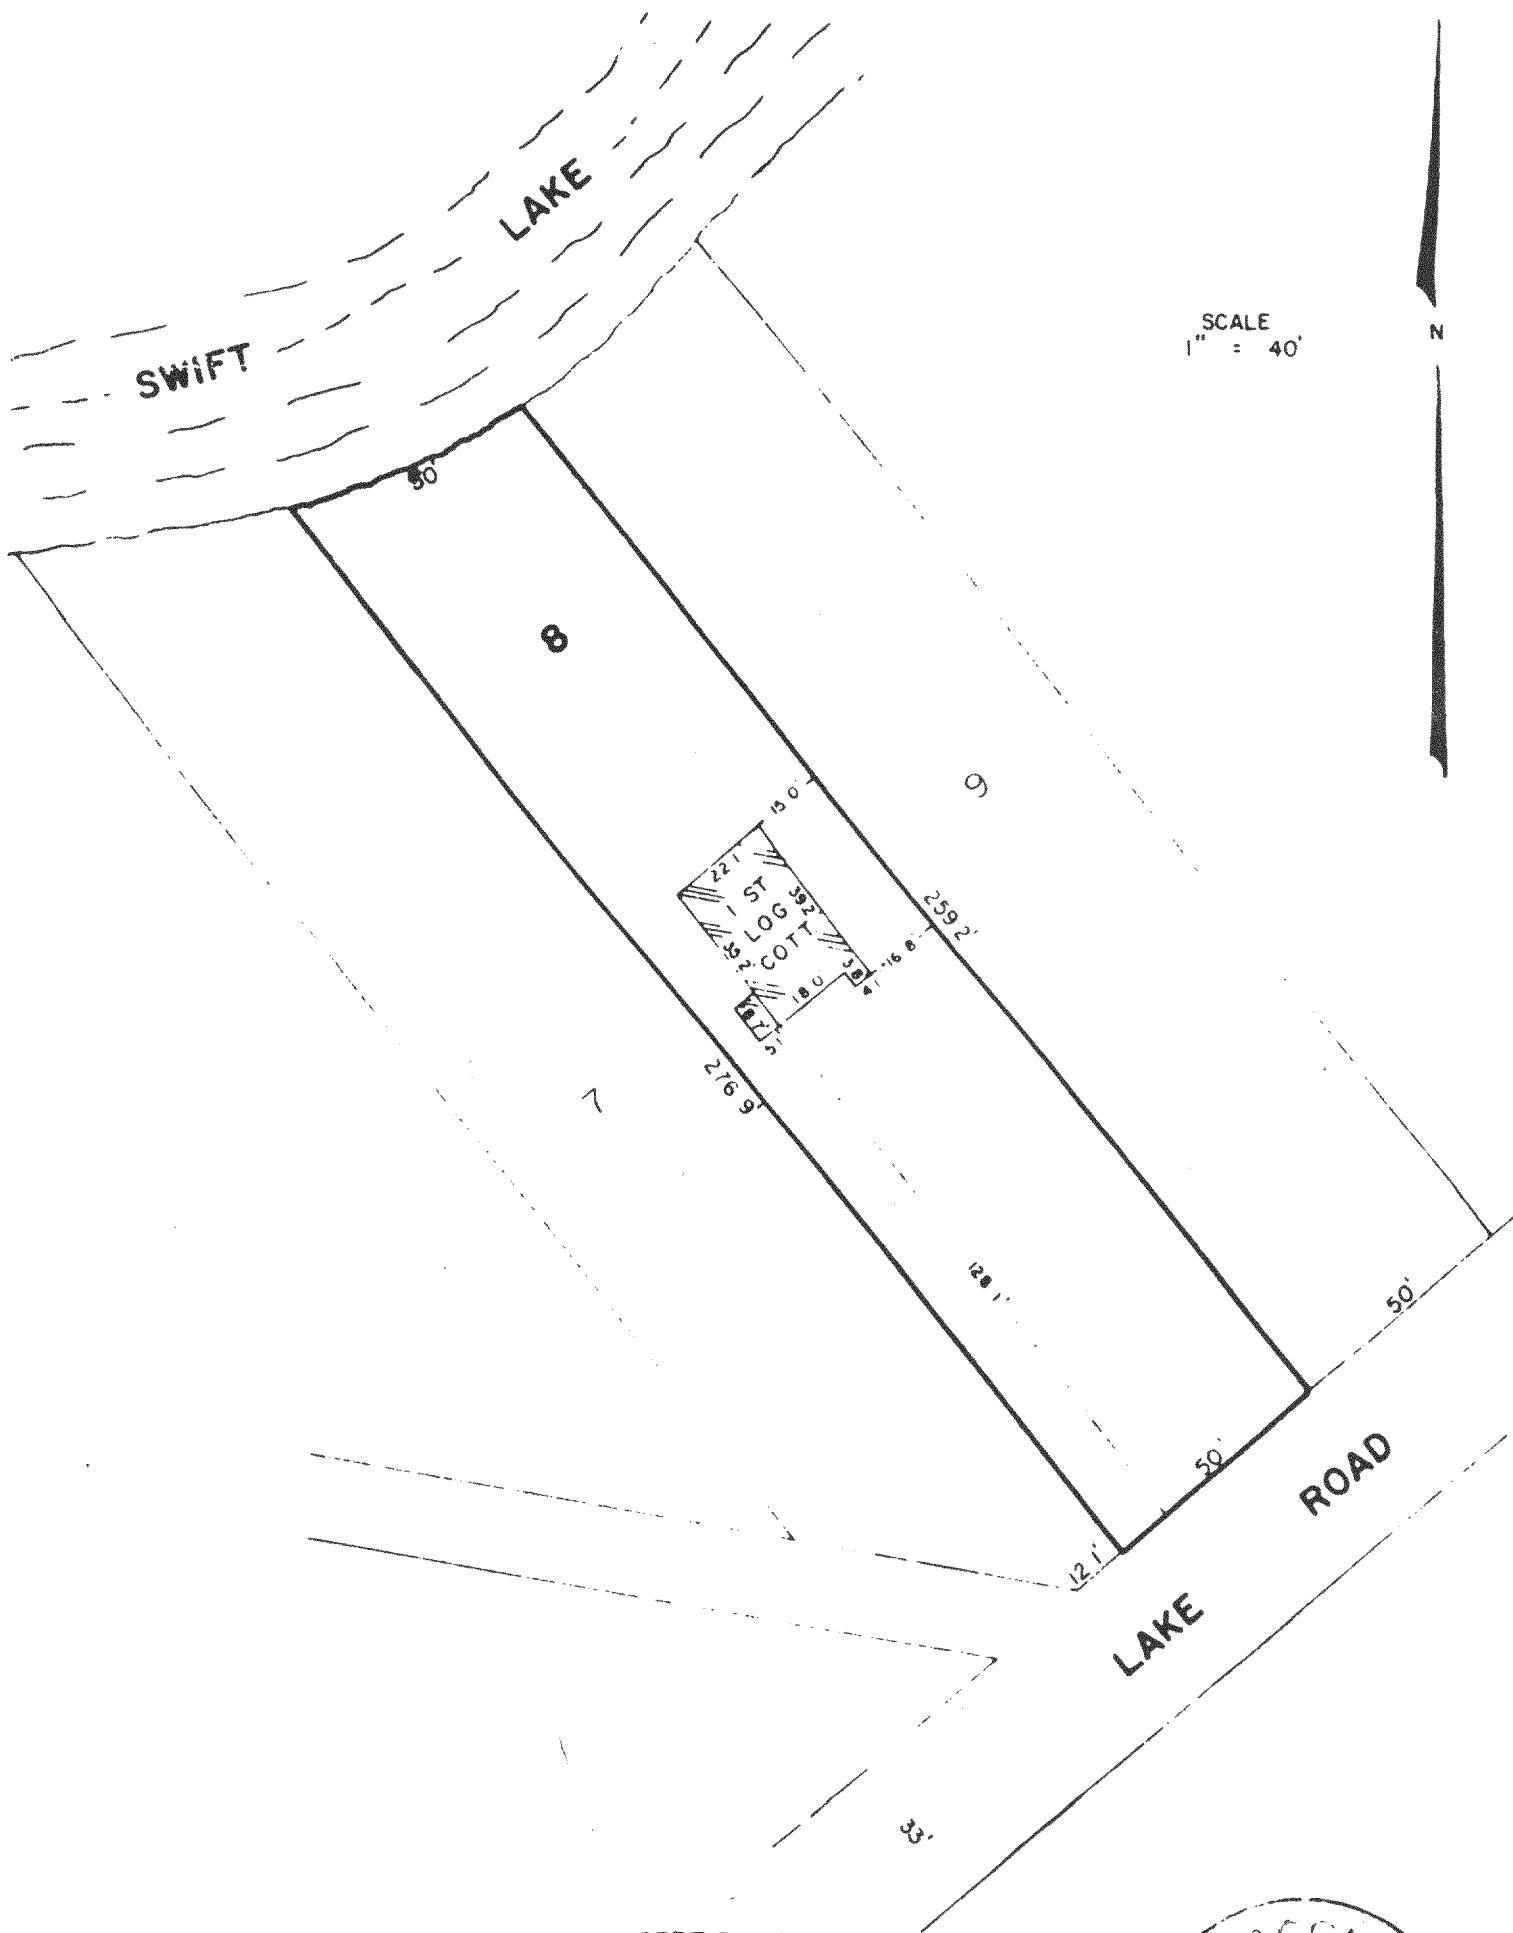

STATE OF WISCONSIN
COUNTY OF WAUKESHA

CERTIFICATION

I, RONALD H. ZIMMERMAN, REGISTERED LAND SURVEYOR, DO HEREBY CERTIFY THAT I HAVE MADE A SURVEY
OF LOT 8, BLK 2, SWIFT LAKE SUBD, TOWN OF TROY, WALWORTH COUNTY
AND THE EXISTING BUILDING AND IMPROVEMENTS LOCATED THEREON AND THAT THE PLAT HERewith DRAWN
IS A CORRECT REPRESENTATION OF SAID SURVEY

LSL-13

15

1972



417-207