




HAROLD H. KOLB
REGISTERED PROFESSIONAL LAND SURVEYOR
LAKE GENEVA, WISCONSIN

BEFORE ME, the undersigned authority, on this day personally appeared HAROLD H. KOLB, known to me to be the person whose name is subscribed to the foregoing instrument, and acknowledged to me that he executed the same for the purposes and consideration therein expressed.

Given under my hand and seal of office this 17th day of June, 1975.

NOTARY PUBLIC IN AND FOR THE STATE OF WISCONSIN

SURVEYED ALONG EXISTING FENCE

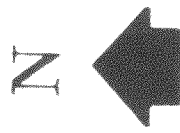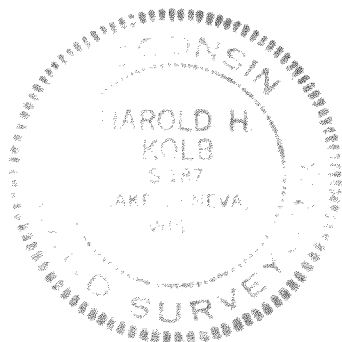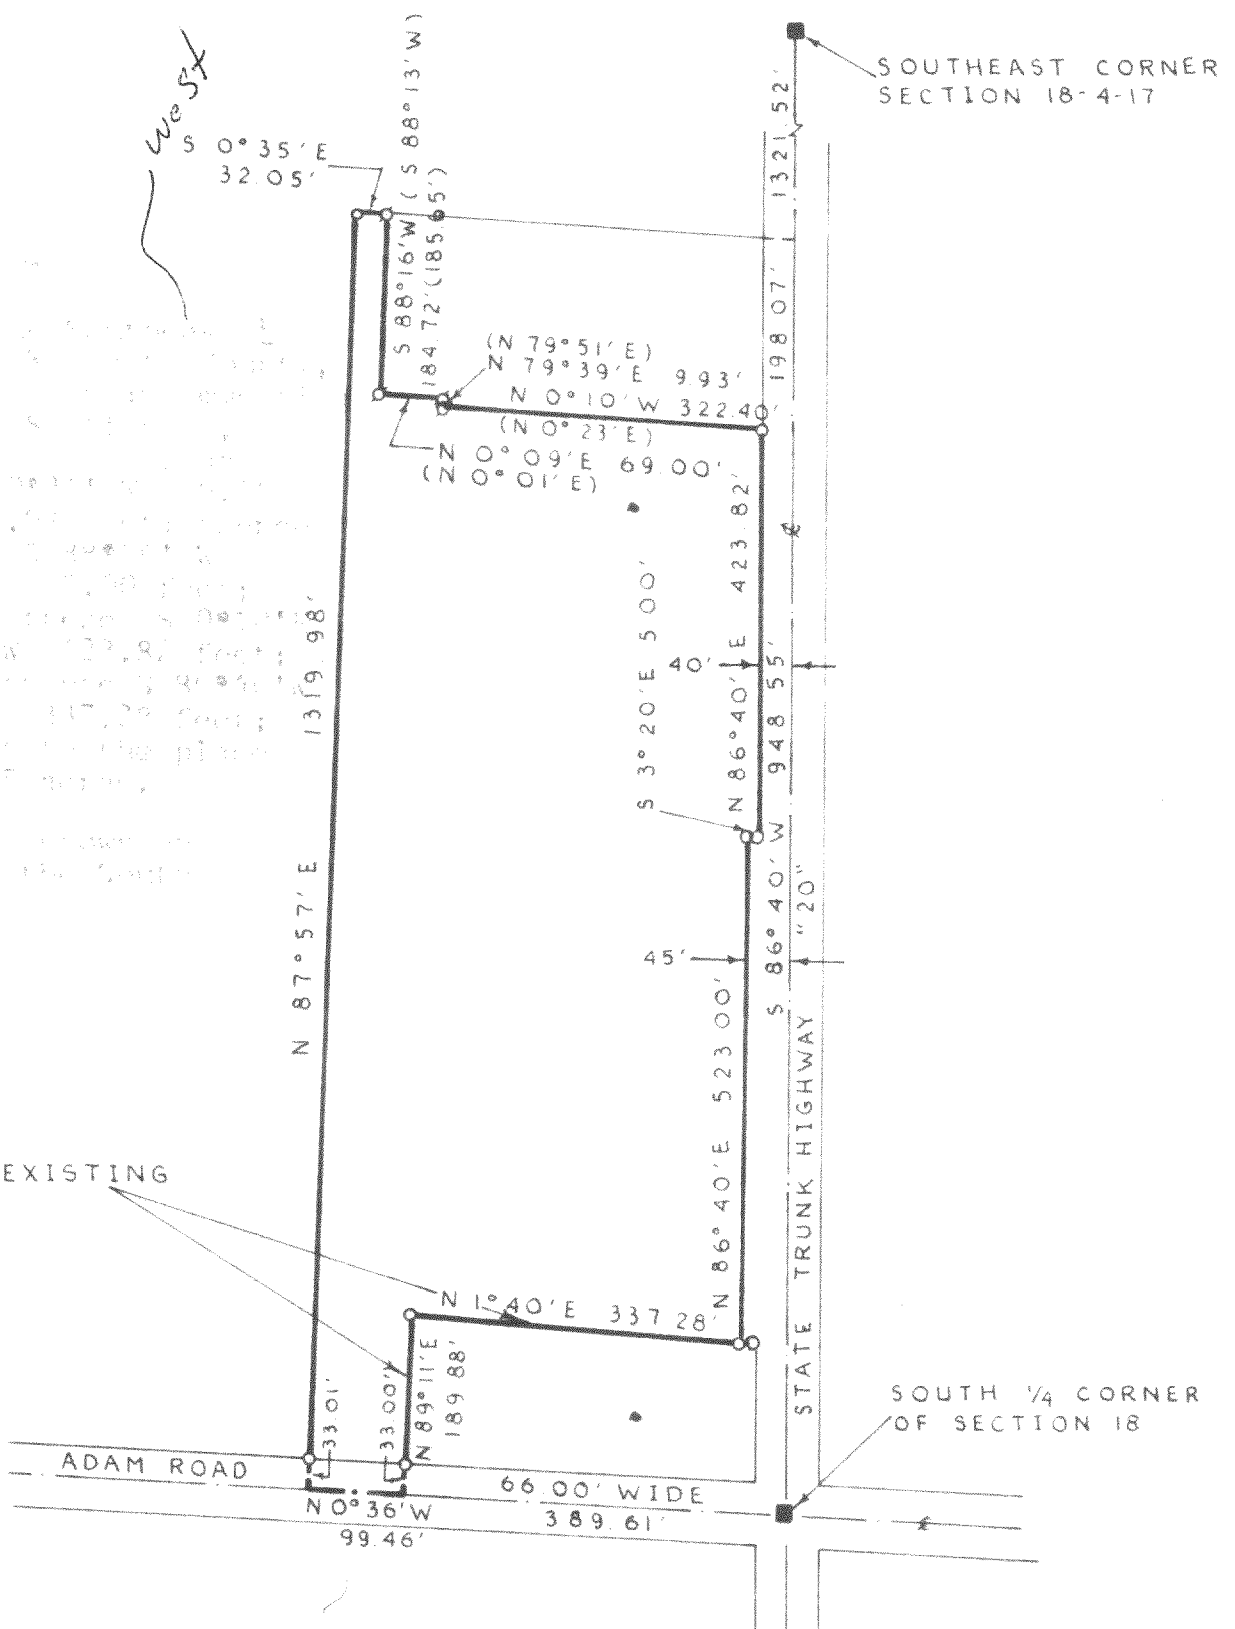

SCALE: 1" = 200'

- LEGEND**
- Ø - IRON PIPE FOUND
 - O - IRON PIPE PLACED
 - - CONCRETE MONUMENT
 - X - SPIKE
 - () - PLATTED DISTANCE

I, HAROLD H. KOLB, DO HEREBY CERTIFY THAT I HAVE SURVEYED THE PROPERTY HEREON DESCRIBED ACCORDING TO THE OFFICIAL RECORDS, AND THAT THE PLAT HEREON IS A CORRECT REPRESENTATION OF THE LOT LINES.

Harold H. Kolb
HAROLD H. KOLB
WISCONSIN REGISTERED LAND SURVEYOR, S-187
DATE June 17, 1975

T-18-7B

417-26