


MAP AND LEGAL DESCRIPTION FOR PROPOSED LOT LINE ADJUSTMENT

LOCATED IN THE NE 1/4 OF THE SW 1/4 OF
SECTION 19, TOWN 4 NORTH, RANGE 17 EAST,
WALWORTH COUNTY, WISCONSIN

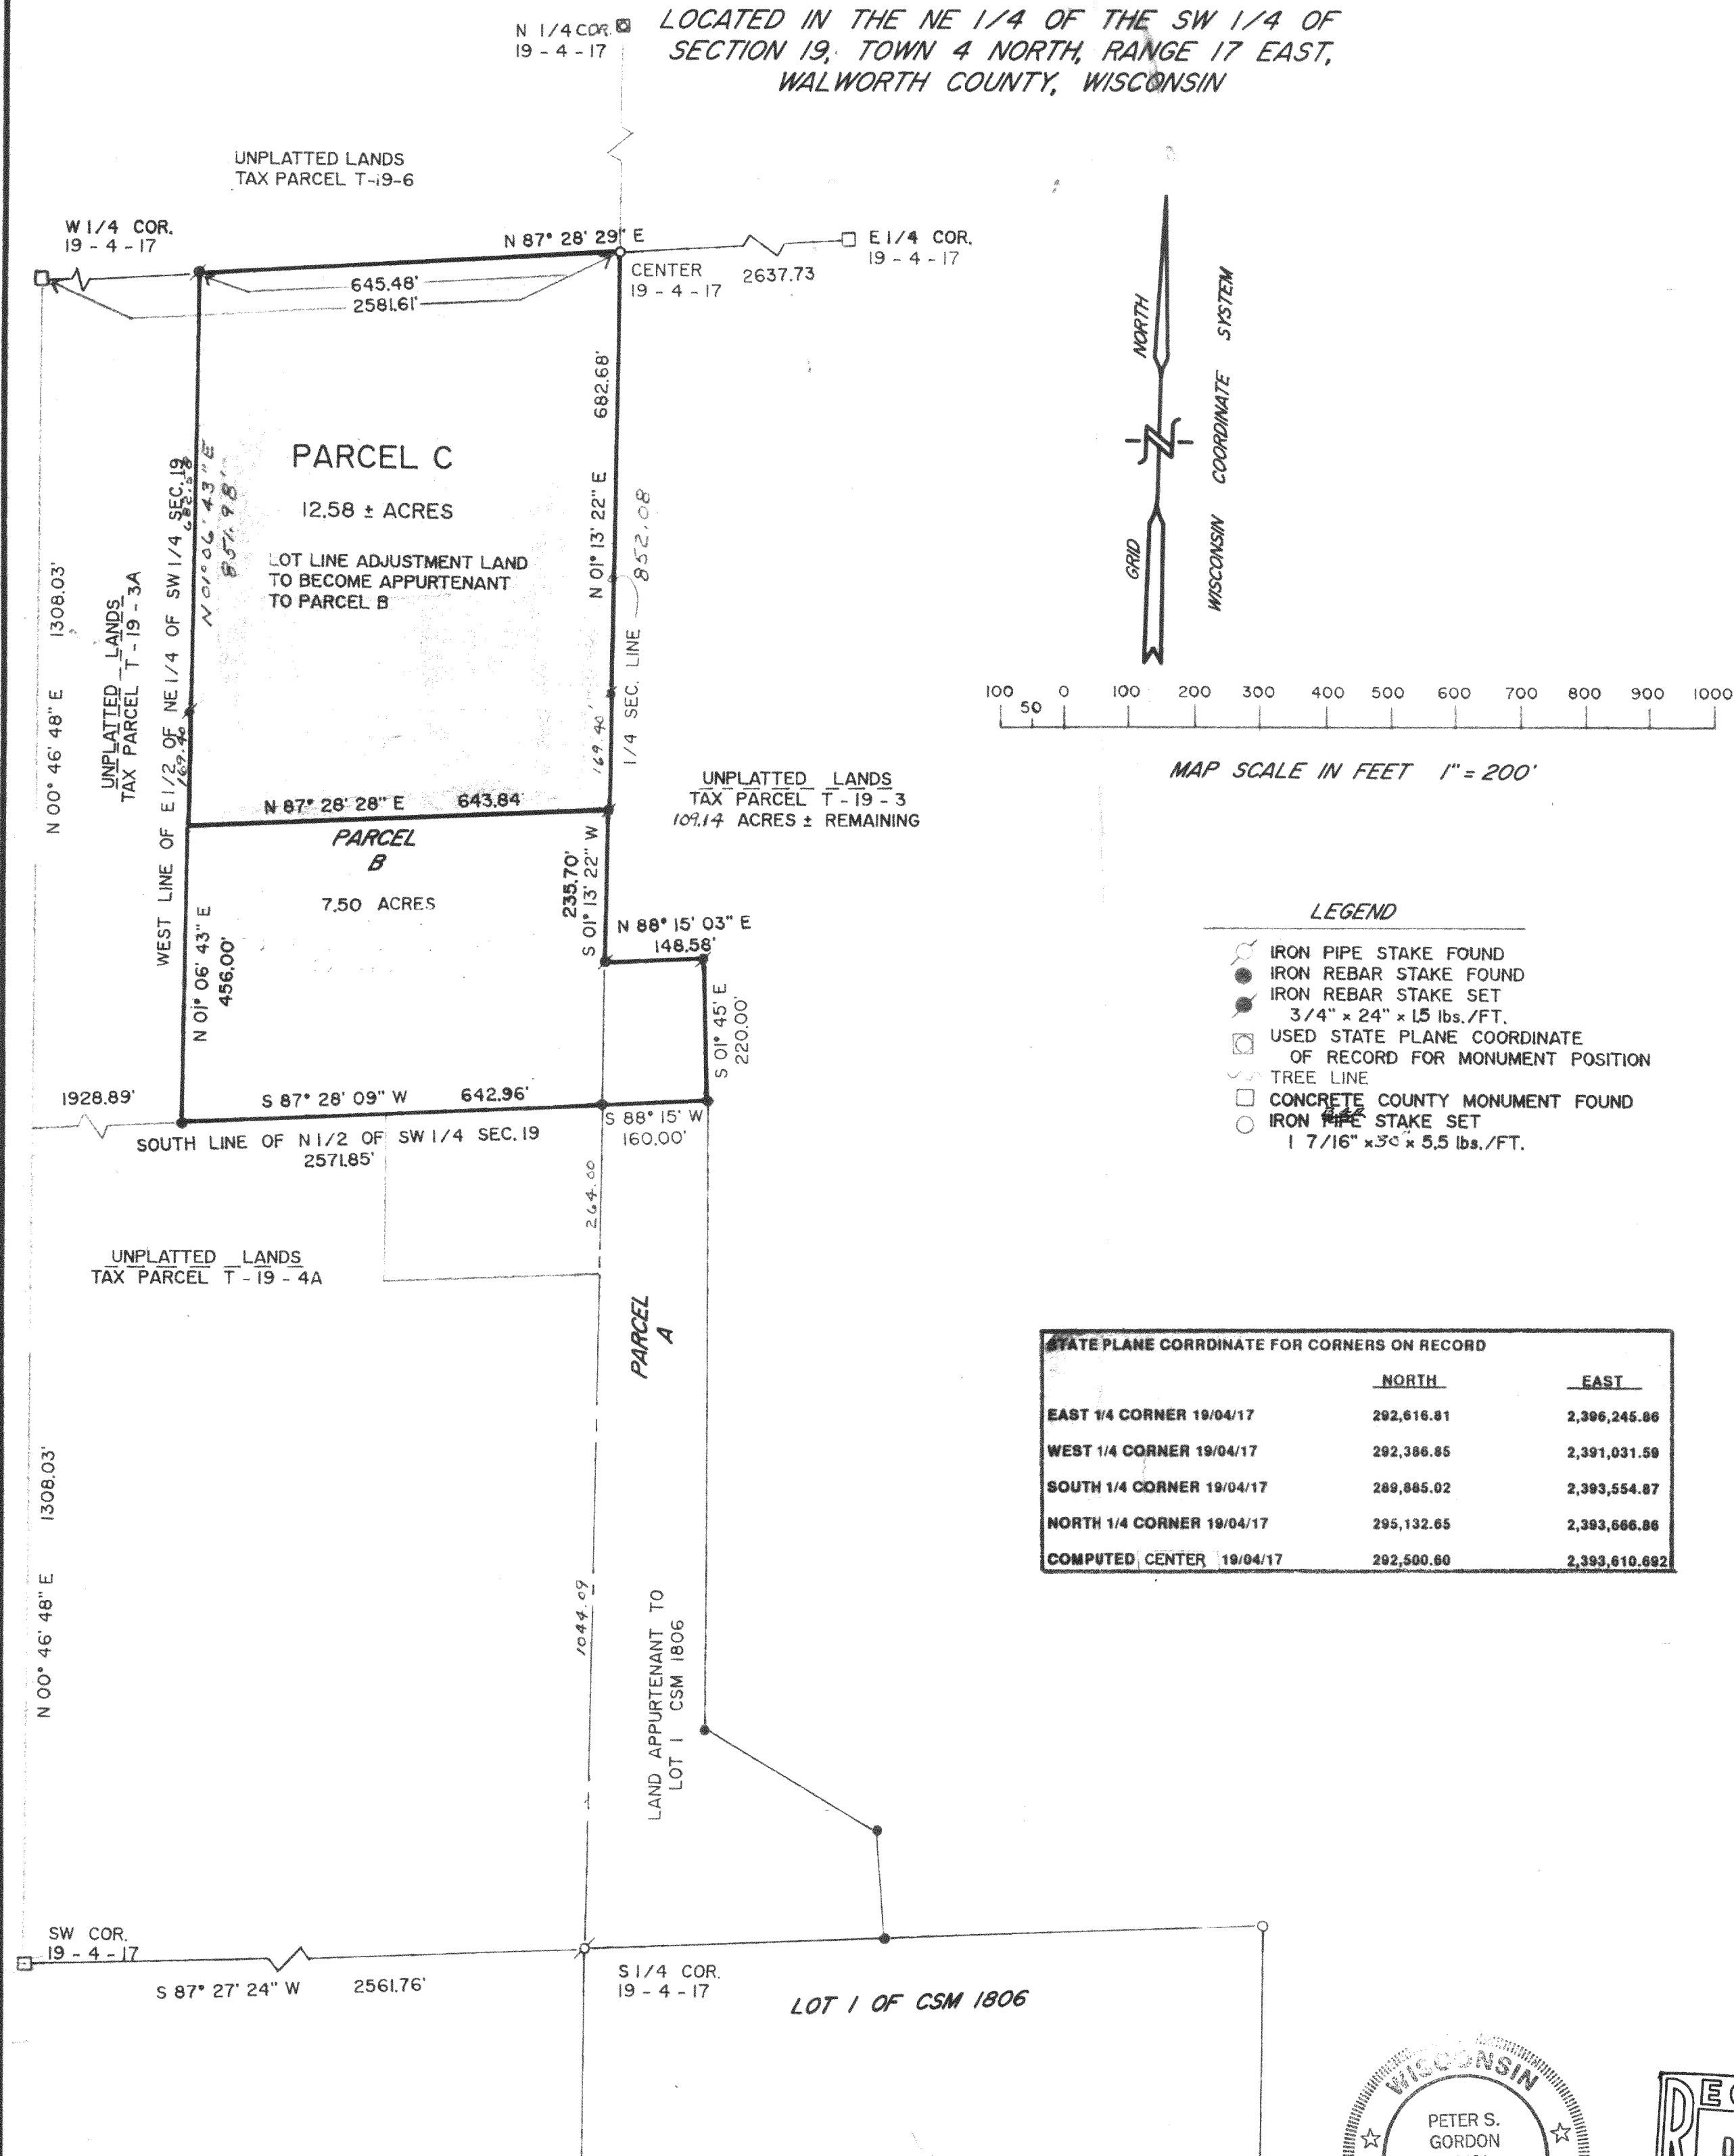

LEGAL DESCRIPTION FOR PROPOSED LOT LINE ADJUSTMENT PARCEL C

A PARCEL OF LAND LOCATED IN THE NORTHEAST 1/4 OF THE SOUTHWEST 1/4 OF SECTION 19, TOWN 4 NORTH, RANGE 17 EAST, WALWORTH COUNTY, WISCONSIN DESCRIBED AS:

COMMENCING AT A CONCRETE COUNTY MONUMENT FOUND MARKING THE SOUTHWEST CORNER OF SAID SECTION 19, THENCE N 00DEG 46MIN 48SEC E, ALONG THE WEST LINE OF THE SOUTHWEST 1/4 OF SAID SECTION 19, 1308.03 FEET; THENCE N 87DEG 28MIN 09SEC E, ALONG THE SOUTH LINE OF THE NORTH 1/2 OF THE SOUTHWEST 1/4 OF SAID SECTION 19, 1928.89 FEET; THENCE N 01DEG 06MIN 43SEC E, ALONG THE WEST LINE OF THE EAST 1/2 OF THE NORTHEAST 1/4 OF THE SOUTHWEST 1/4 OF SAID SECTION 19, 456.00 FEET TO THE POINT OF BEGINNING; THENCE CONTINUE ON SAID LINE N 01DEG 06MIN 43SEC E, 851.98 FEET TO THE NORTH LINE OF SAID SW 1/4; THENCE ALONG SAID NORTH 1/4 SECTION LINE N 87DEG 28MIN 32SEC E, 645.48 FEET TO THE CENTER OF SAID SECTION 19; THENCE ALONG THE EAST LINE OF SAID SW 1/4, S 01DEG 13MIN 22SEC W, 852.08 FEET; THENCE S 87DEG 28MIN 28SEC W, 643.84 FEET TO THE POINT OF BEGINNING. CONTAINING 12.58 ACRES OF LAND MORE OR LESS AND IS INTENDED TO BECOME APPURTENANT TO PARCEL "B" AS DEPICTED ABOVE.

WORK ORDERED BY: DAVE HELBLING


NOTE: COPIES OF THIS MAP TO WHICH THE FOLLOWING CERTIFICATE WILL APPLY ARE BLUE LINE PRINTS SHOWING SURVEYOR'S ORIGINAL SEAL AND SIGNATURE IN BLACK INK. COPIES BY ANY OTHER MEANS MAY HAVE ALTERATIONS WHICH DO NOT REPRESENT THE SURVEYOR'S WORK PRODUCT.

I HEREBY CERTIFY THAT THIS PLAT OF SURVEY IS A TRUE AND ACCURATE REPRESENTATION OF THE PARCEL DESCRIBED HEREON TO THE BEST OF MY PROFESSIONAL KNOWLEDGE AND BELIEF.

DATED: Nov. 16, 1992 *Peter S. Gordon*
PETER S. GORDON RLS 2101

LT-19-3
LT-19-3G

417-341

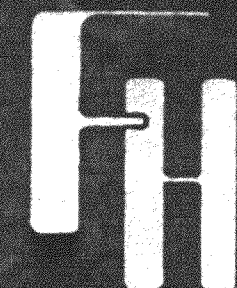



MAP AND LEGAL DESCRIPTION

LOCATED IN THE NE 1/4 OF THE SW 1/4 OF
SECTION 19, TOWN 4 NORTH, RANGE 17 EAST,
WALWORTH COUNTY, WISCONSIN

FOR: DAVE HELBLING
8400 HWY "20"
EAST TROY, WI 53120

FARRIS, HANSEN & ASSOCIATES, INC.
Engineering, Architecture, Surveying
7 Ridgeway Court P.O. Box 437
ELKHORN, WISCONSIN 53121
Office: (414) 723-2098
Fax: (414) 723-5886

REVISIONS
CHANGED PARCEL B.
FROM 10 TO 7.5 ACRES
25 FEB 92 KF
11-13-92
ADD PARCEL
C + LEGAL

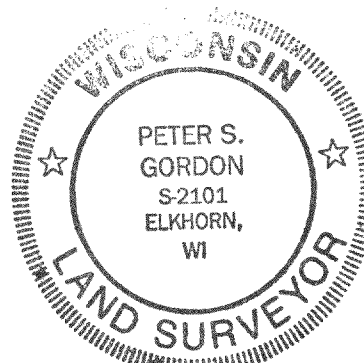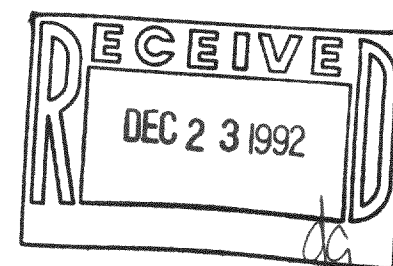

PROJECT NO
3421
DATE
01-20-92
SHEET NO.
1 of 1