







RSV ENGINEERING, INC.
ENGINEERS, PLANNERS, SURVEYORS
CONSTRUCTION MANAGERS
545 BAY VIEW ROAD, Mukwonago, Wisconsin 53149 (414) 363-2004


DATE: 8/21/95

LEGEND

- | | |
|---|---------------------------|
|  | POWER POLE |
|  | FENCE |
|  | IRON PIPE OR
BAR FOUND |
| ANT. | ANTENNA |
|  | CONC. AREAS |
|  | LIGHT ON POLE |
|  | EDGE OF PVMT. |



SCALE 1" = 50'

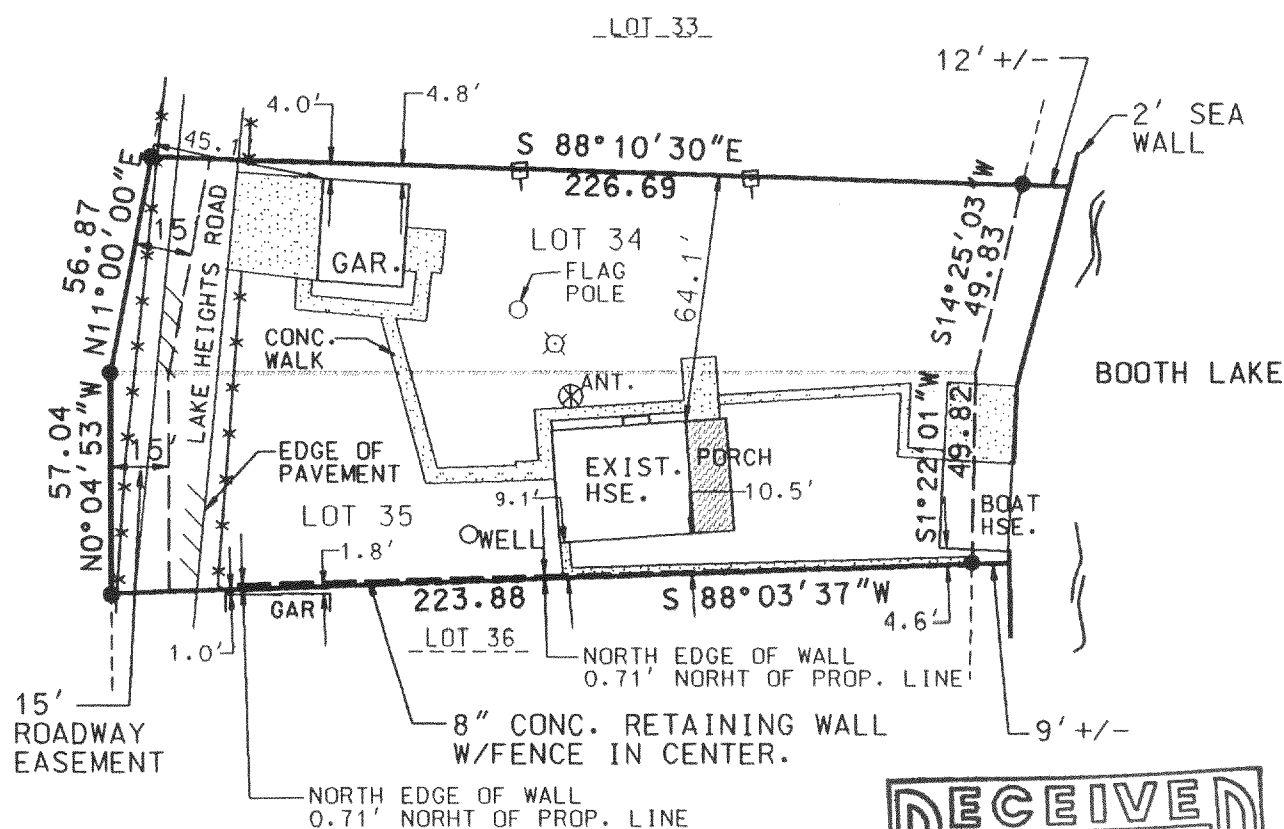

RECEIVED
SEP 11 1995

THE ABOVE MAP IS A TRUE REPRESENTATION THEREOF AND SHOWS THE SIZE AND LOCATION OF ALL THE PROPERTY, EXTERIOR BOUNDARIES, THE LOCATION OF ALL VISIBLE BOUNDARY FENCES, APPARENT EASEMENTS, ROADWAYS AND VISIBLE ENCROACHMENTS, IF ANY.

THIS SURVEY IS MADE FOR THE USE OF THE PRESENT OWNERS OF THE PROPERTY, AND ALSO THOSE WHO PURCHASE, MORTGAGE OR GUARANTEE TITLE THERETO WITHIN ONE (1) YEAR FROM DATE HERETO.

BRADFORD L. SPENCER, R.L.S. 2069
RSV# 95100.DGN

THIS IS ORIGINAL
PRINT ONLY IF
SEAL IS IMPRINTED
IN RED



LBL-29

417-426