

ABERNATHY and ASSOCIATES


Kenneth B. Abernathy Jr.

Wisconsin Registered Land Surveyor S-1594

Rt. 3, Box 273
Elkhorn, Wisconsin 53121
Phone: (414) 723-4260 (office)
(414) 723-7209 (FAX)


PLAT OF SURVEY

LOT 11, BLOCK 2, SWIFT LAKE SUBDIVISION, LOCATED IN
THE SE 1/4 OF SECTION 8, TOWN 4 NORTH, RANGE 17 EAST,
TROY TOWNSHIP, WALWORTH COUNTY, WISCONSIN.

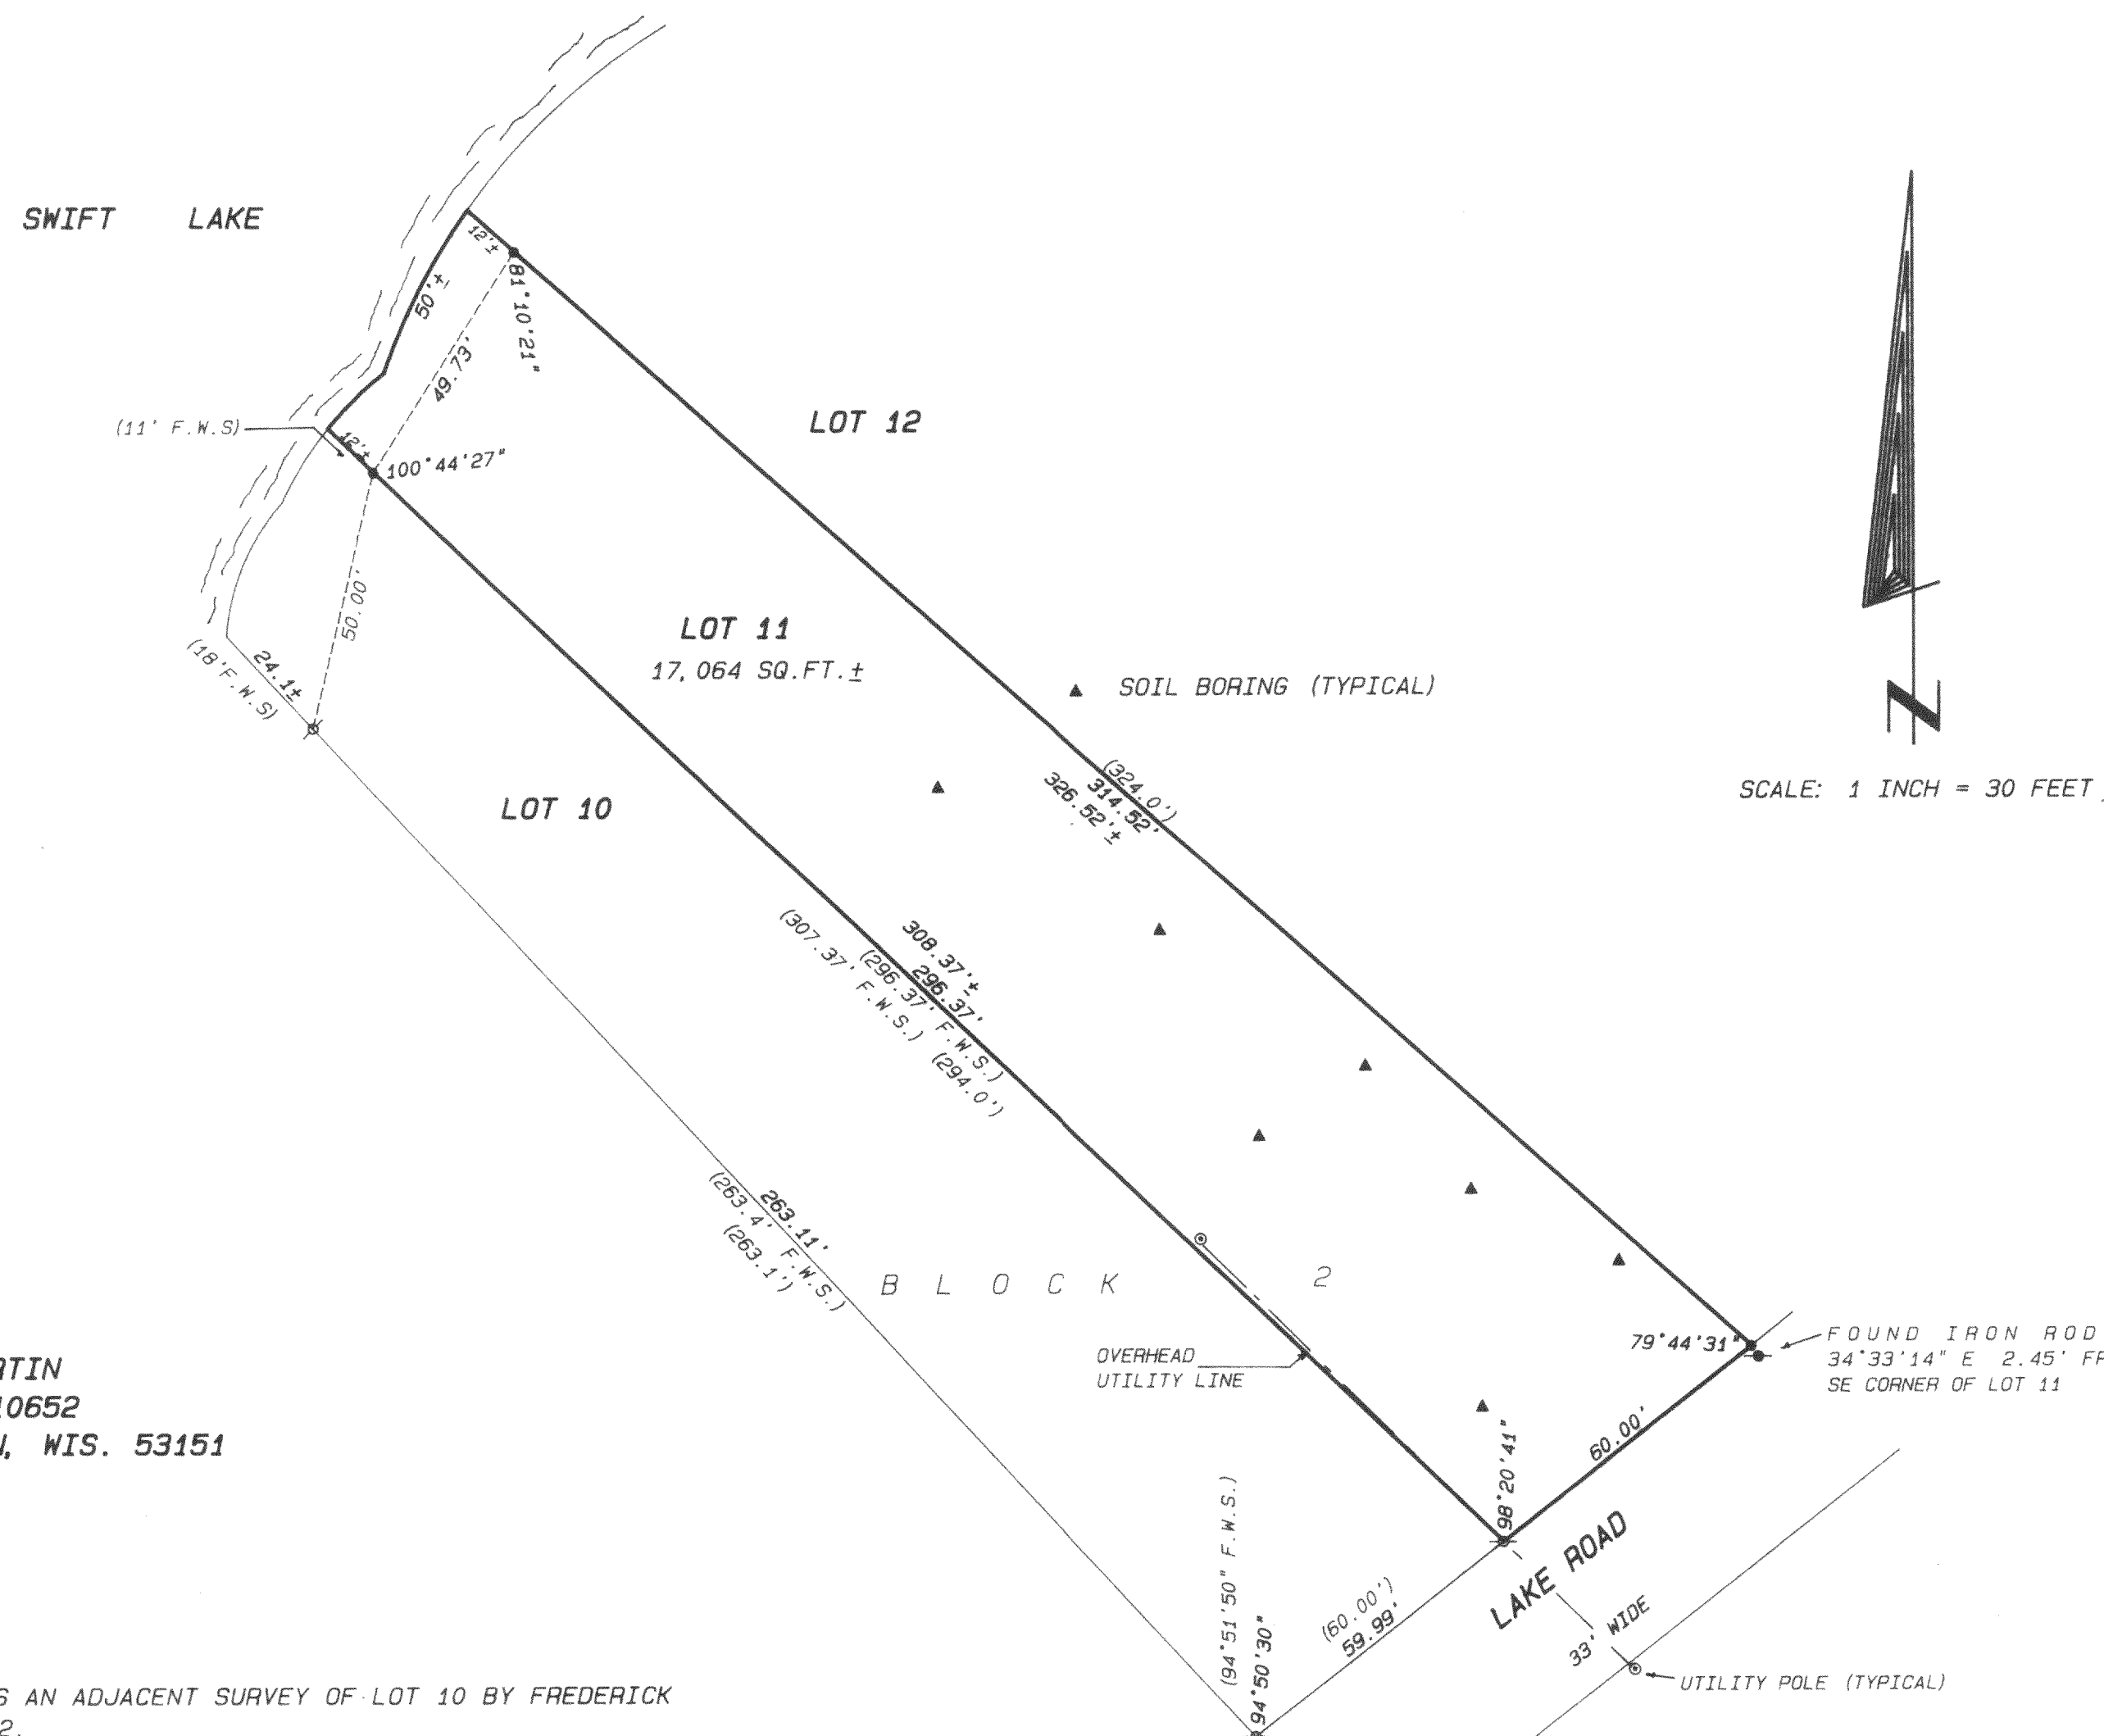

ORDERED BY: BONNIE MARTIN
P.O. BOX 510652
NEW BERLIN, WIS. 53151

NOTE: THIS SURVEY RETRACES AN ADJACENT SURVEY OF LOT 10 BY FREDERICK
W. SHIBILSKI DATED 9-30-1982.

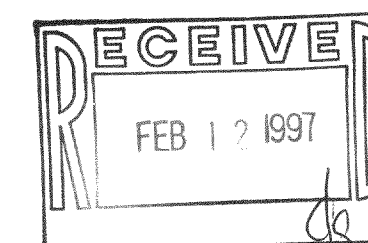

SCALE: 1" = 30 FEET

"I hereby certify that the above described property has been surveyed
by me or under my direction and that the above map is a true
representation thereof and shows the size and location of the property, its
exterior boundaries, the location of all visible structures and dimensions of
all principal buildings thereon, boundary fences, apparent easements,
roadways and visible encroachments, if any."
"This survey is made for the use of the present owners of the property,
and also those who purchase, mortgage, or guarantee the title thereto within
one year from date hereof."

Kenneth B. Abernathy, Jr.
KENNETH B. ABERNATHY, JR.
WISCONSIN REGISTERED LAND SURVEYOR,
S-1594

Date: JANUARY 31, 1997 Job No. 97.110



LSL-15
417-476