
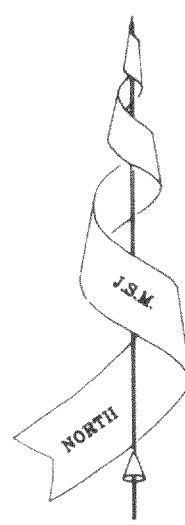
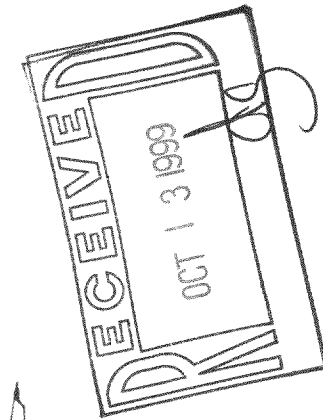


Plat of Survey


of
Lot 2 of Certified Survey Map No. 3048,
recorded in Vol. 16 of Certified Survey Maps of Walworth County on Page 183
being a redivision of Lot 1 of Certified Survey Map No. 3048 and Lot 5 of Avo
Sunset Park, located in the Southeast 1/4 of Section 13, Town 4 North, Range
17 East, Town of Troy, Walworth County, Wisconsin.

Surveyed for: Don & Shirley Allen
16715 Tanglewood Drive
Brookfield, Wisconsin. 53005
Address of site: N8605 Town Line Road
East Troy, Wisconsin. 53120

Booth
Lake

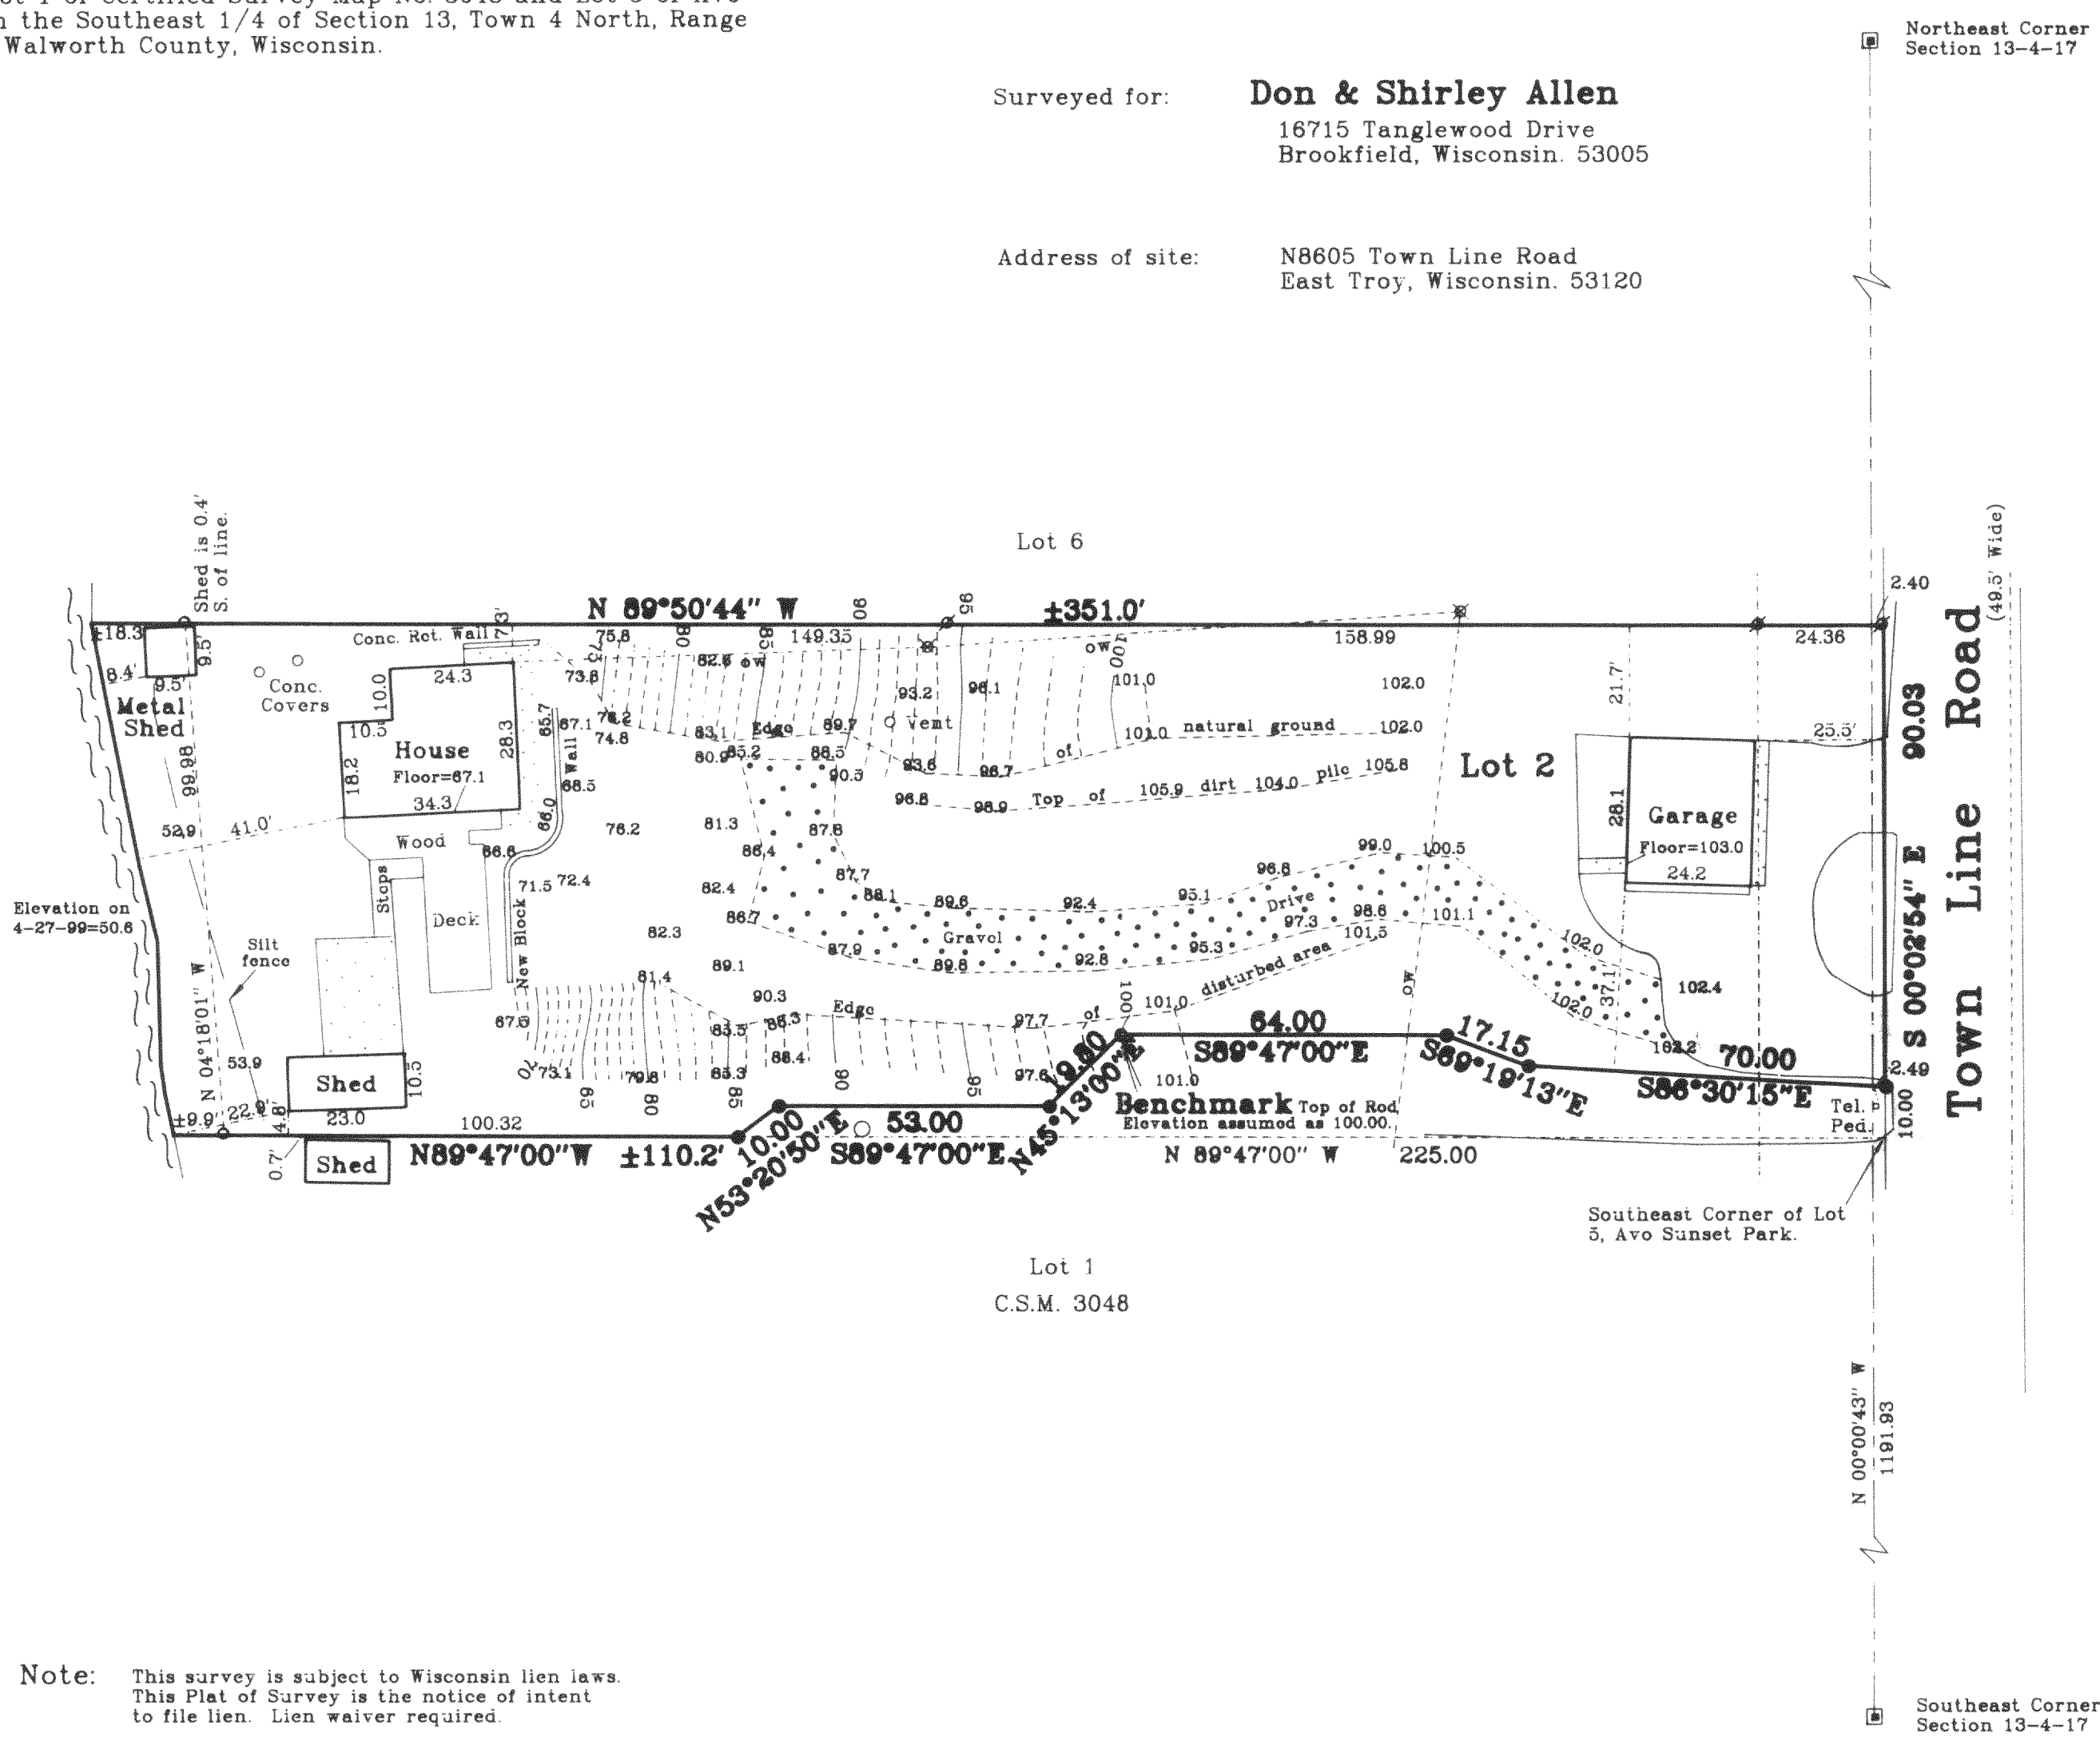

Bearings referenced to Certified
Survey Map No. 1656.

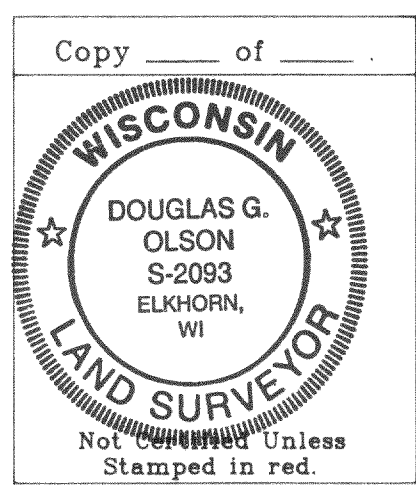

Note: This survey plat is not
certified unless signed
and sealed in red ink.

Note: This survey is subject to Wisconsin lien laws.
This Plat of Survey is the notice of intent
to file lien. Lien waiver required.

Copyright © 1999 by Jensen & Olson Land Surveying, LLC

All rights reserved. No part of this survey plat may be reproduced
or transmitted in any form by any means - graphic, electronic, or
mechanical, including photocopying, tracing, or information storage
and retrieval systems - without permission in writing from Douglas G.
Olson, Jensen & Olson Land Surveying, LLC.

I, Douglas G. Olson, Wisconsin Registered Land Surveyor, do
hereby certify that this survey was performed by me, or under my
direction in full compliance with the owner's / agent's instructions
and Chapter A-E 7 of the Wisconsin Administrative Code "Minimum
Standards for Property Surveys"; and that this map is as accurate
representation thereof to the best of my knowledge and belief.
Date: 4/28/99
Douglas G. Olson R.L.S. 2093

Mapping date: April 28, 1999.	
Revisions:	
Scale in Feet 1" = 30' 0' 15' 30' 60'	
Jensen & Olson Land Surveying, LLC 45 South Wisconsin Street P.O. Box 322 Elkhorn, Wisconsin. 53121 Telephone: (414) 723-3434 Facsimile: (414) 723-8044	
Legend Found County Section Corner Found Iron Pipe Found Iron Rod Found Iron Rod, 3/4" dia. Recorded Information Utility Pole & Overhead Wires Concrete Surface Asphalt Surface	Sheet 1 of 1 Sheets. Job Reference Number 1999.044
1999.044	

LA-3048-2
417-570