

SOUTHWEST CORNER OF THE SOUTHEAST 1/4 OF SECTION 6-7-17

6-7-17
SOUTH LINE OF THE SOUTHWEST 1/4 OF SECTION 6-7-17

RICE

ROAD

S86°22'27"W

10' WIDE UTILITY EASEMENT

400.23'

N00°18'29"W

33.06'

WOOD FENCE

N00°18'25"W

50' WIDE ACCESS EASEMENT

10' WIDE UTILITY EASEMENT

WIRE FENCE

974.90'

468880.90 FT.
11.475 ACRES

S00°12'22"E

486.00'

S87°44'46"W

250.16'

S00°12'22"E

453.51'

651.24'

S89°58'45"E

EXISTING
PIRELLING
(UNDER CONSTRUCTION)

CONCRETE
SLAB


EXISTING
SHED

● FOUND 1" IRON PIPE
● FOUND COUNTY MONUMENT
● SET 1" IRON PIPE

SCALE 1"=40'

"I hereby certify that I have surveyed the above property and that the above map is a true representation thereof and shows the site and location of the property, exterior boundaries, the location of all visible structures and dimensions of all principal buildings thereon, boundary fences, apparent easements, roadways and encroachments if any."
This survey is made for the use of the present owners of the property, and also those who purchase, mortgage or guarantee the title thereto within one year from date hereof.

KETTLE MORANE SURVEYING
P.O. Box 337
Eagle WI 53119
(262)594-3484

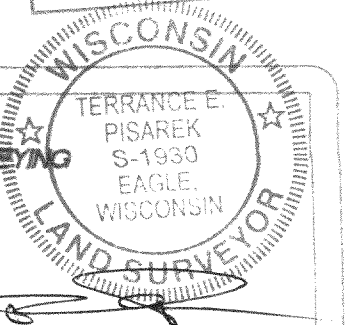

RECEIVED
APR 15 2005

THIS IS NOT AN ORIGINAL SURVEY UNLESS THE SEAL IS HERE.

DATE: 12/13/04
FIELD WORK BY: TEP/TW
DRAWN BY: TEP
JOB NUMBER: 04156