

NORTHWEST CORNER
SECTION 21-4-17

NORTH 1/4 CORNER
SECTION 21-4-17

THE EAST 46.66 ACRES,
MORE OR LESS, OF THE
EAST 1/2 OF THE NORTH-
WEST 1/4 OF SECTION 21,
TOWNSHIP 4 NORTH, RANGE
17 EAST OF THE FOURTH
PRINCIPAL MERIDIAN, IN THE
TOWN OF TROY, COUNTY OF
WALWORTH AND STATE OF
WISCONSIN.

SURVEY FOR: KAY NABER

SURVEY ADDRESS: W3932
STATE ROAD "20"

2,028,174 sq. ft.
46.56 acres
including r-o-w

1,916,701 sq. ft.
44.00 acres
excluding r-o-w

LEGEND

- ⊕ FOUND BRASS CAPPED
CONCRETE MONUMENT
- FOUND IRON PIPE
- SET IRON PIPE

MONUMENTATION BY WRITTEN AGREEMENT
WITH THE ABOVE NAMED CLIENT HAS BEEN
WAIVED IN ACCORDANCE WITH A-E 7.01(2)
OF THE WISCONSIN ADMINISTRATIVE CODE.
(SOUTHEAST LOT CORNER ONLY)

WEST 1/4 CORNER
SECTION 21-4-17

WEST 1869.91' S. LINE OF THE NW 1/4 OF SEC. 21-4-17


WEST 731.47'

WEST 764.41'

"I hereby certify that I have surveyed the above described property and that the above map is a correct representation thereof and shows the size and location of the property, its exterior boundaries, the location of all visible structures and dimensions of all principal buildings thereon, boundary fences, apparent easements, roadways and encroachments, if any."

"This survey is made for the use of the present owners of the property, and those who purchase, mortgage, or guarantee the title thereto within one year from date hereof."

CENTER OF
SECTION 21-4-17

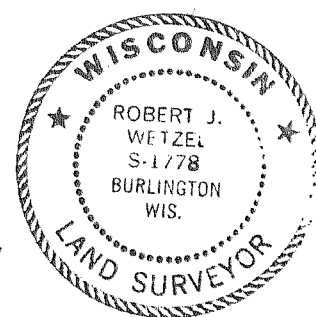


THIS IS NOT AN ORIGINAL PRINT
UNLESS THIS SEAL IS RED.

Robert J. Wetzel
ROBERT J. WETZEL S-1778

JULY 27, 2006
DATE

7307
JOB NUMBER

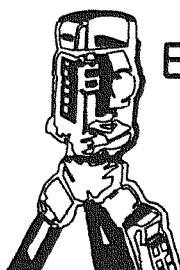

B.W. SURVEYING, INC.
LAND SURVEYS
MAPPING AND PLANNING
412 N. PINE STREET
BURLINGTON, WI 53105
(262)-767-0225

LT 21-4

417-831