



PLAT OF SURVEY

LOTS 1 THRU 38 OF BLOCK 1 OF
SWIFT LAKE SUBDIVISION
LOCATED IN SECTION 8, TOWN 4 NORTH, RANGE 17 EAST,
WALWORTH COUNTY, WISCONSIN

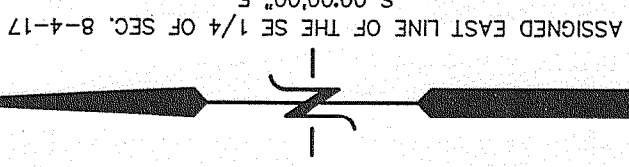

LINE	BEARING	DISTANCE
L1	S 371°23'01" E	38.42


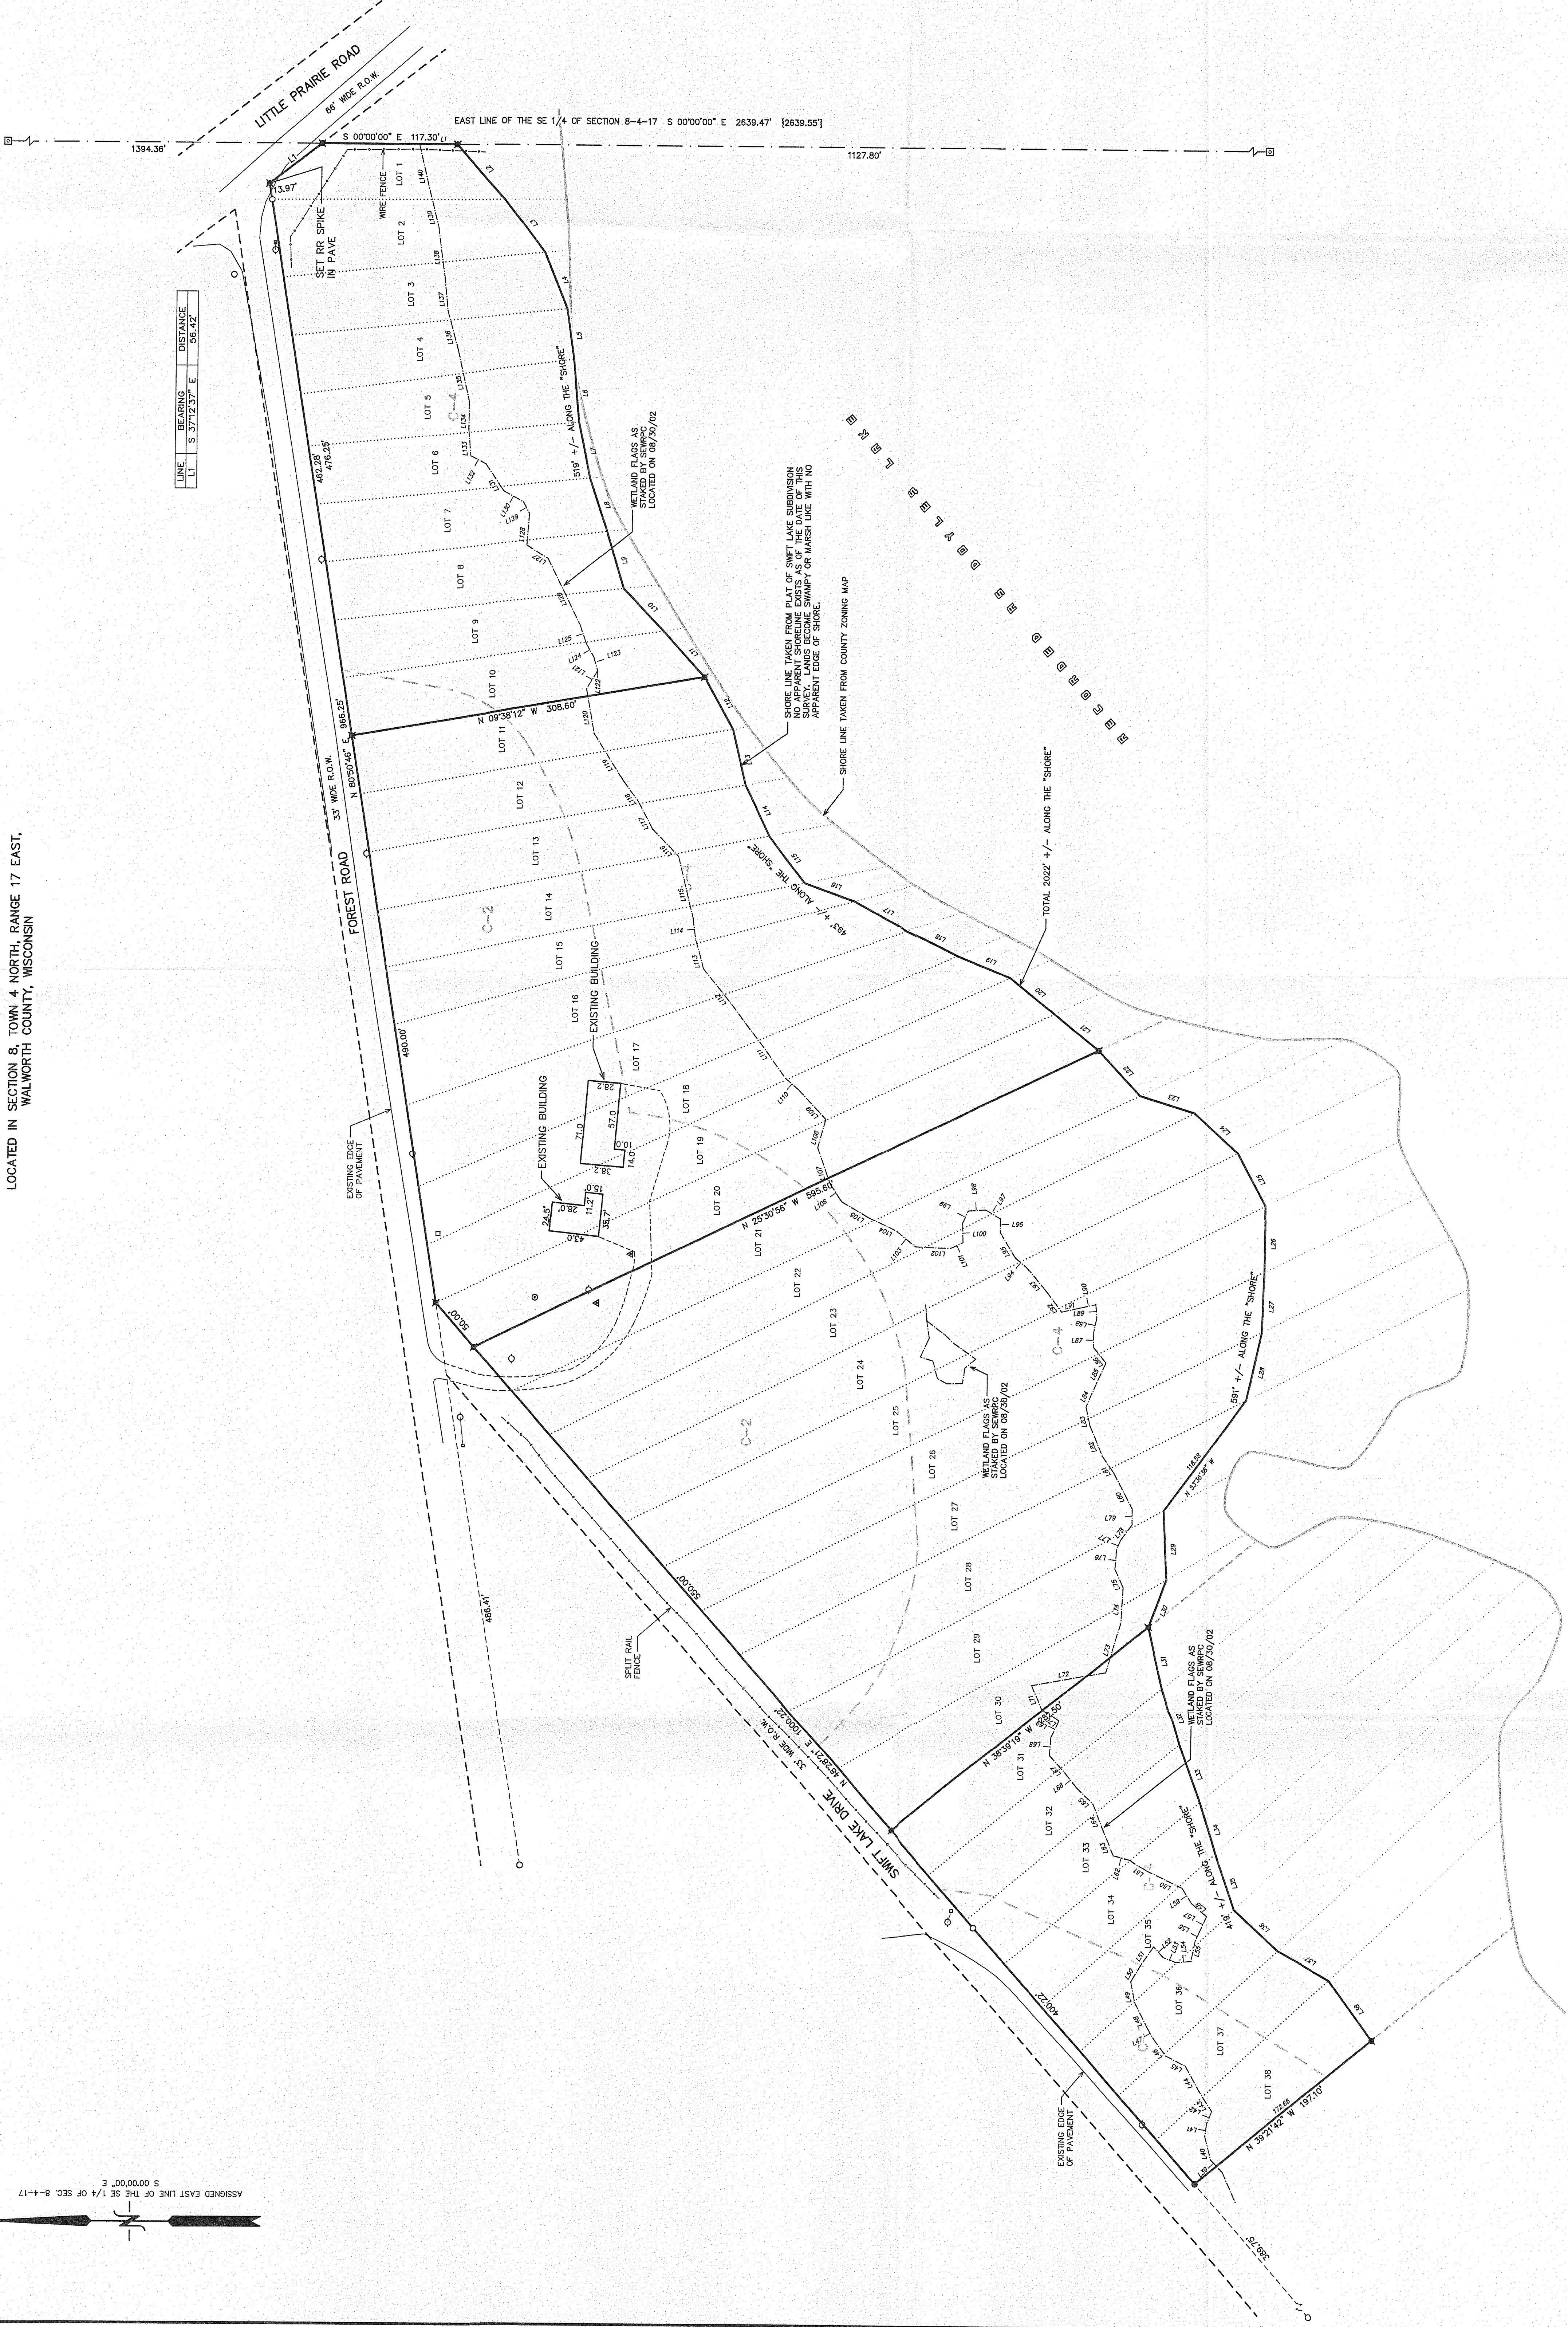


- LEGEND
- ✕ = SET IRON REBAR STAKE
 - = FOUND IRON PIPE STAKE
 - = FOUND IRON REBAR STAKE
 - ⊙ = FOUND CONCRETE COUNTY MONUMENT W/BRASS CAP
 - ✕ = SET IRON REBAR STAKE, 1/4" DIA.
 - = UTILITY POLE LOCATED
 - = GUY WIRE LOCATED
 - = UTILITY CONTROL BOX LOCATED
 - ⊙ = WELL LOCATED
 - ▲ = SEPTIC STRUCTURE LOCATED
 - XXXX = RECORDED AS

NOTE: COPIES OF THIS MAP TO WHICH THE FOLLOWING CERTIFICATE IS ATTACHED SHALL BE VALID FOR THE PURPOSES OF THE SURVEY. THE SURVEYOR'S WORK PRODUCT, INCLUDING BUT NOT LIMITED TO, THE SURVEYOR'S FIELD NOTES, PLAT, AND ANY OTHER INSTRUMENTS WHICH DO NOT REPRESENT THE SURVEYOR'S WORK PRODUCT, IS HEREBY CERTIFIED THAT THE ABOVE DESCRIBED PROPERTY HAS BEEN SURVEYED AND THE SURVEYOR'S FIELD NOTES, PLAT, AND ANY OTHER INSTRUMENTS REPRESENTATION THEREOF AND SHOWING THE SIZE AND LOCATION OF THE PROPERTY ARE TRUE AND CORRECT. THE SURVEYOR'S FIELD NOTES AND ANY OTHER INSTRUMENTS, INCLUDING BUT NOT LIMITED TO, THE SURVEYOR'S PLAT, ARE HEREBY CERTIFIED TO BE TRUE AND CORRECT. ALSO THOSE WHO PURCHASE, MORTGAGE, OR GUARANTEE THE TITLE HEREIN SHALL BE DEEMED TO HAVE BEEN ADVISED OF THE TRUE AND CORRECT NATURE OF THE SURVEY.

DATED: 12/13/2001

RECEIVED 05-23-2007
TO SHOW SIZE & LOCATION OF
PROPOSED ADDITION

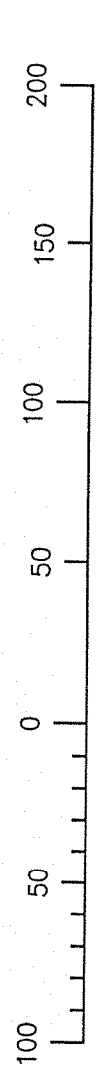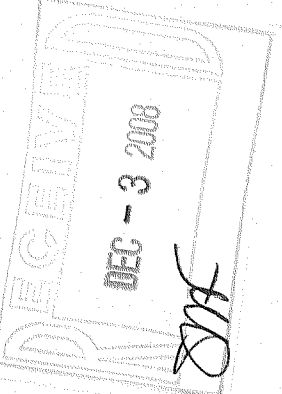

15L-1 15L-1A 15L-1B 15L-1C

417-873

PLAT OF SURVEY

WORK ORDERED BY -
7 SWIFT LAKE ROAD
EAST TROY, WI.
FARRIS, HANSEN & ASSOCIATES, INC.

ENGINEERING - ARCHITECTURE - SURVEYING
7 RIDGWAY COURT
ELKHORN, WISCONSIN 53121
OFFICE: (262) 723-2098 FAX: (262) 723-5888

REVISIONS
08/13/02
08/13/02
08/13/02
08/13/02

PROJECT NO.
5860
DATE
11/19/2001
SHEET NO.
1 OF 1