


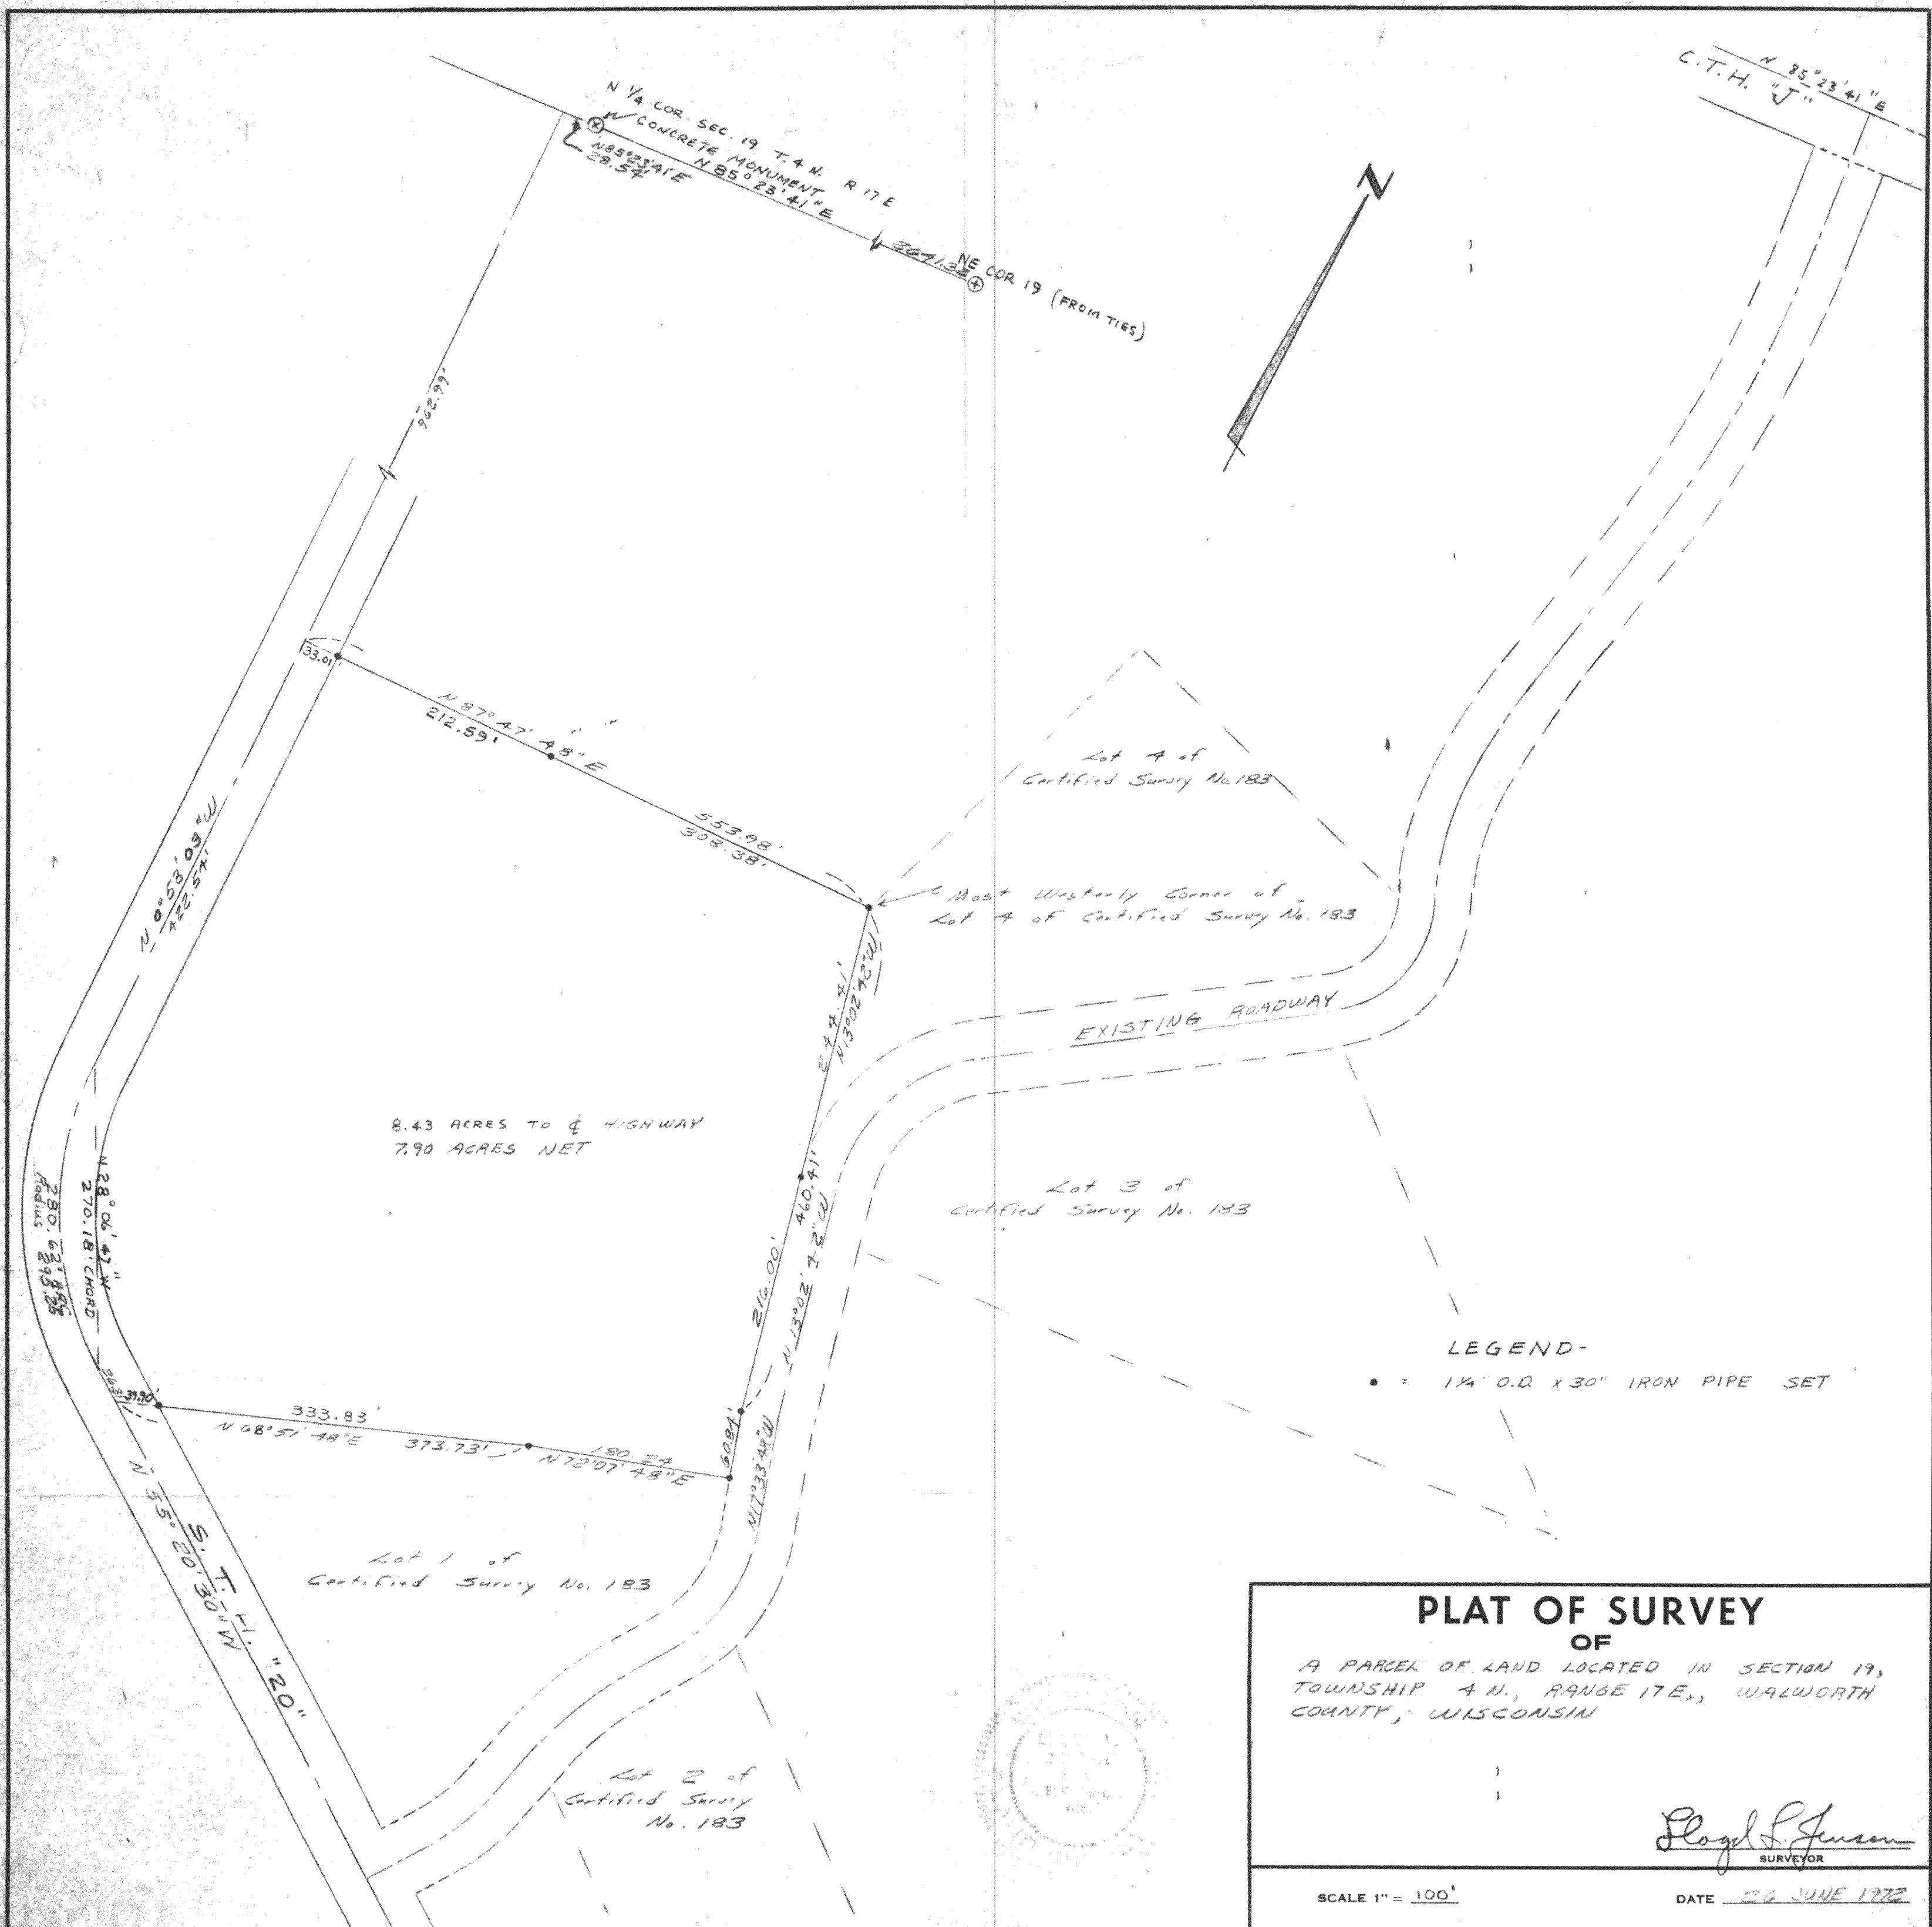

8.43 ACRES TO & HIGHWAY
7.90 ACRES NET

Lot 3 of
Certified Survey No. 183

Lot 4 of
Certified Survey No. 183

Most Westerly Corner of
Lot 4 of Certified Survey No. 183

EXISTING ROADWAY

LEGEND-

• = 1 1/4" O.D. x 30" IRON PIPE SET

PLAT OF SURVEY OF

A PARCEL OF LAND LOCATED IN SECTION 19,
TOWNSHIP 4 N., RANGE 17 E., WALWORTH
COUNTY, WISCONSIN

Floyd L. Jensen
SURVEYOR

SCALE 1" = 100'

DATE 26 JUNE 1972