


SURVEY OF LOTS 1, 2, 3 A.V.O. SUNSET PARK SECTION 13, T4N, R17E

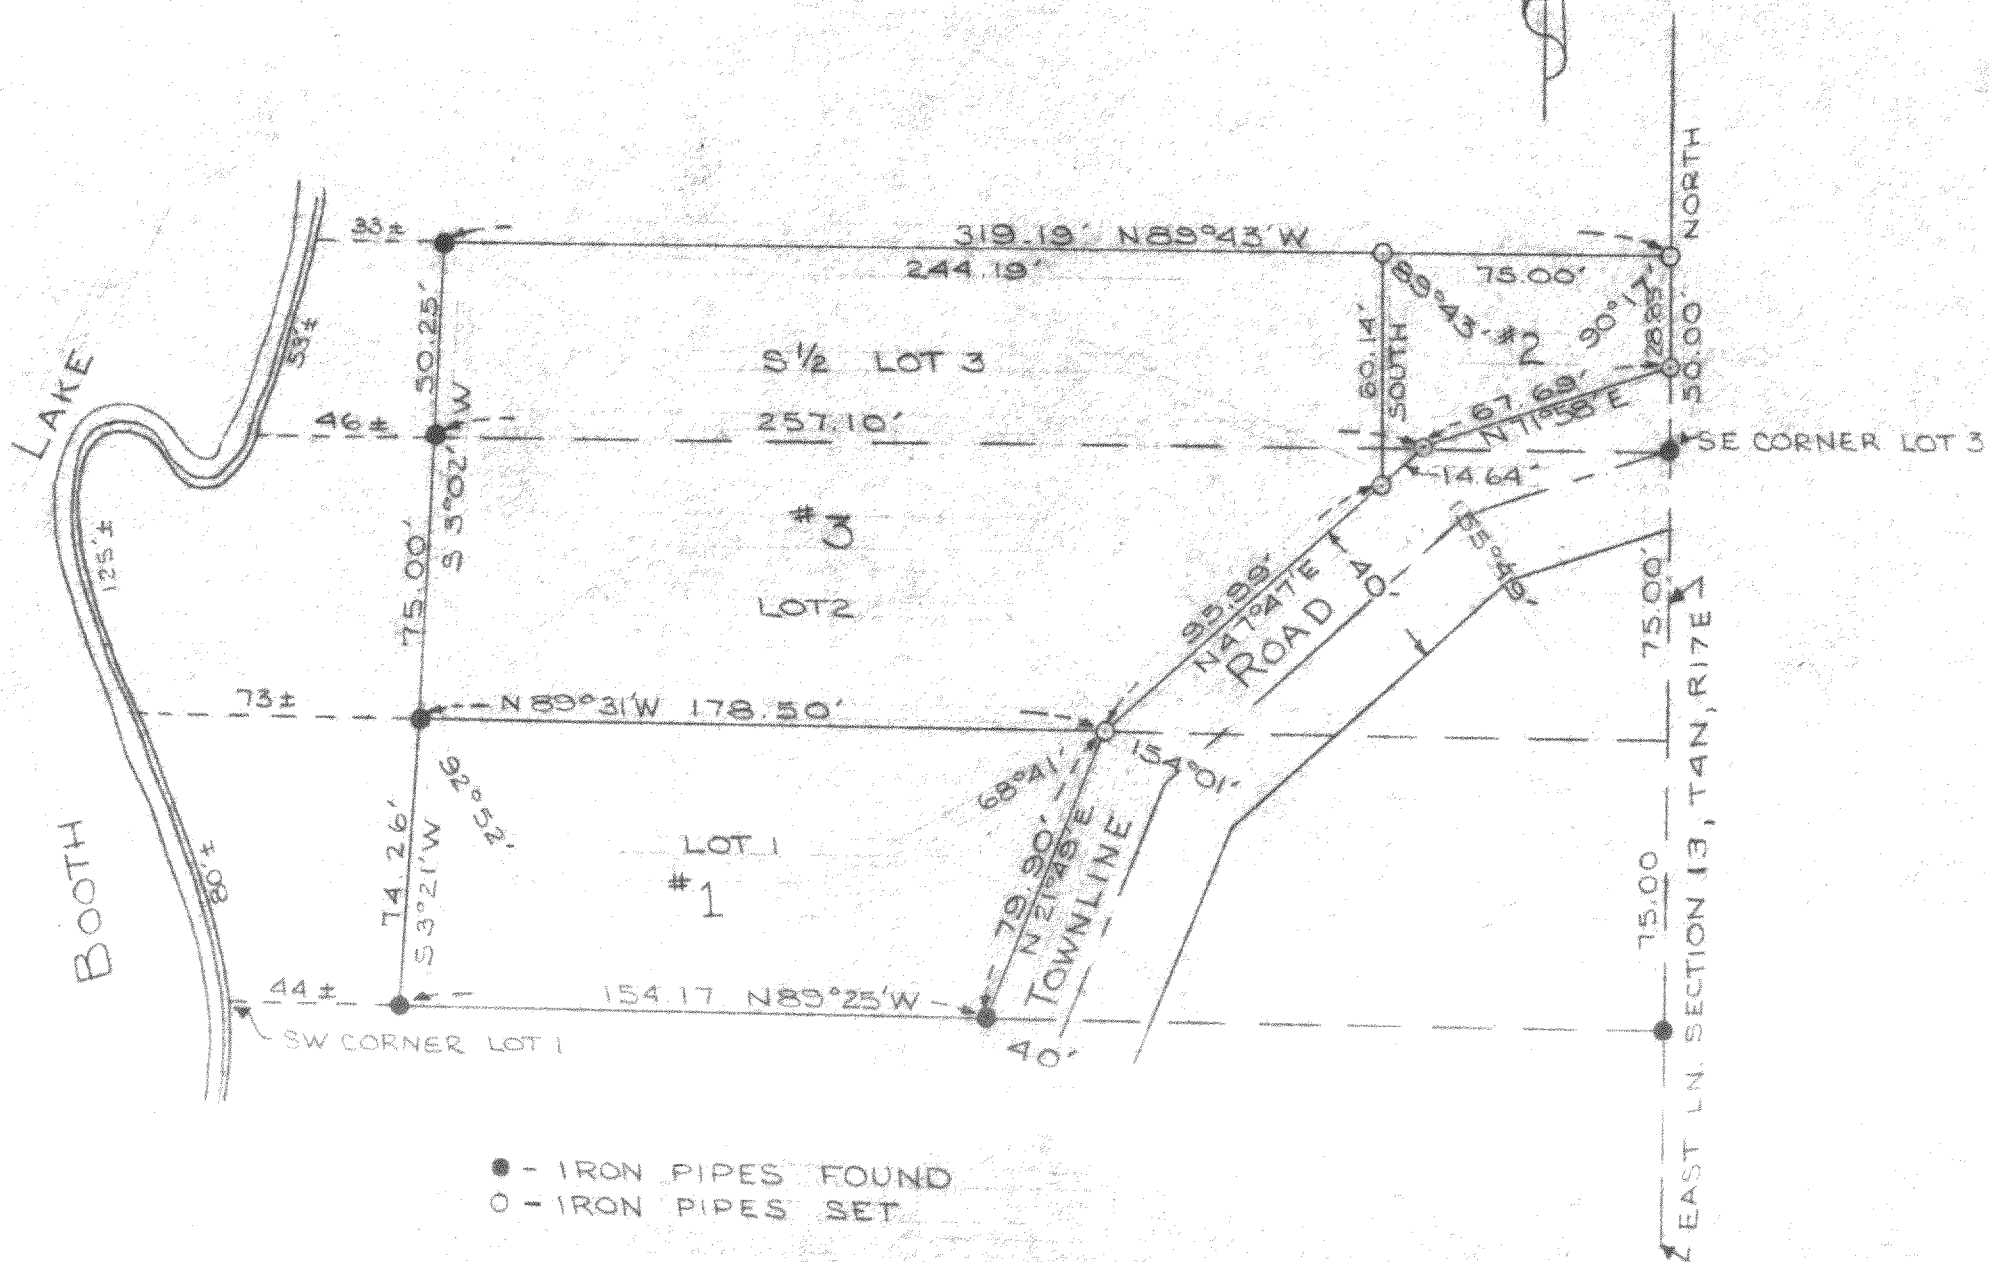

DESCRIPTIONS:

PARCEL 1 Commencing at the intersection of the shore of Booth Lake and the south line of Lot 1, A.V.O. Sunset Park, Section 13, T4N, R17E, Walworth County, Wisconsin, thence S 89° 25' E, 44 feet more or less, thence S 89° 25' E along said south line of said Lot 1, 154.17 feet to the west line of Townline Road, thence N 21° 49' E along said west line of Townline Road, 79.90 feet to the north line of said Lot 1, thence N 89° 31' W along said north line of Lot 1, 178.50 feet, thence continue N 89° 31' W along said north line of Lot 1, 73 feet more or less to the shore of said Booth Lake, thence SE'ly along said shoreline 80 feet more or less to the place of beginning.


PARCEL 2 Commencing at the SE corner of Lot 3, A.V.O. Sunset Park, Section 13, T4N, R17E, Walworth County, Wisconsin, thence North along the East line of said section and of said Lot 3, 21.15 feet to the place of beginning of the lands hereinafter described, to wit: Thence North along said East line of said Section and of said Lot 3, 28.85 feet, thence N 89° 43' W, 75.00 feet, thence South 60.14 feet to the West line of said Townline Road, thence N 47° 47' E along said west line of Townline Road, 14.64 feet to the south line of said Lot 3, thence N 71° 58' E along said west line of Townline Road, 67.69 feet to the place of beginning.

PARCEL 3 Commencing at the SE corner of Lot 3, A.V.O. Sunset Park, Section 13, T4N, R17E, Walworth County, Wisconsin, thence North along the East line of said section and of said Lot 3, 50.00 feet, thence N 89° 43' W, 75.00 feet to the place of beginning of the lands hereinafter described, to wit: thence N 89° 43' W, 244.19 feet, thence continue N 89° 43' W, 33 feet more or less to the shore of Booth Lake, thence Southerly along said shoreline, 178 feet more or less to the south line of Lot 2, said A.V.O. Sunset Park, thence S 89° 31' E along said south line of said Lot 2, 73 feet more or less, thence continue S 89° 31' E along said south line, 178.50 feet to the west line of Townline Road, thence N 47° 47' E along said west line of said Townline Road, 95.99 feet, thence North, 60.14 feet to the place of beginning.

CERTIFICATE:


I, James F. Biagi, surveyor, do hereby certify that I have surveyed the lands hereon described.

September 3, 1970

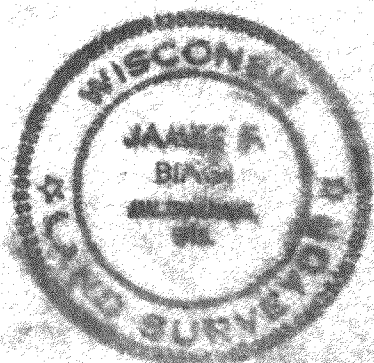

James F. Biagi
James F. Biagi R.L.S. 272

SURVEY OF
LOTS 1, 2, 3 A.V.O. SUNSET PARK
SECTION 13, T4N, R17E

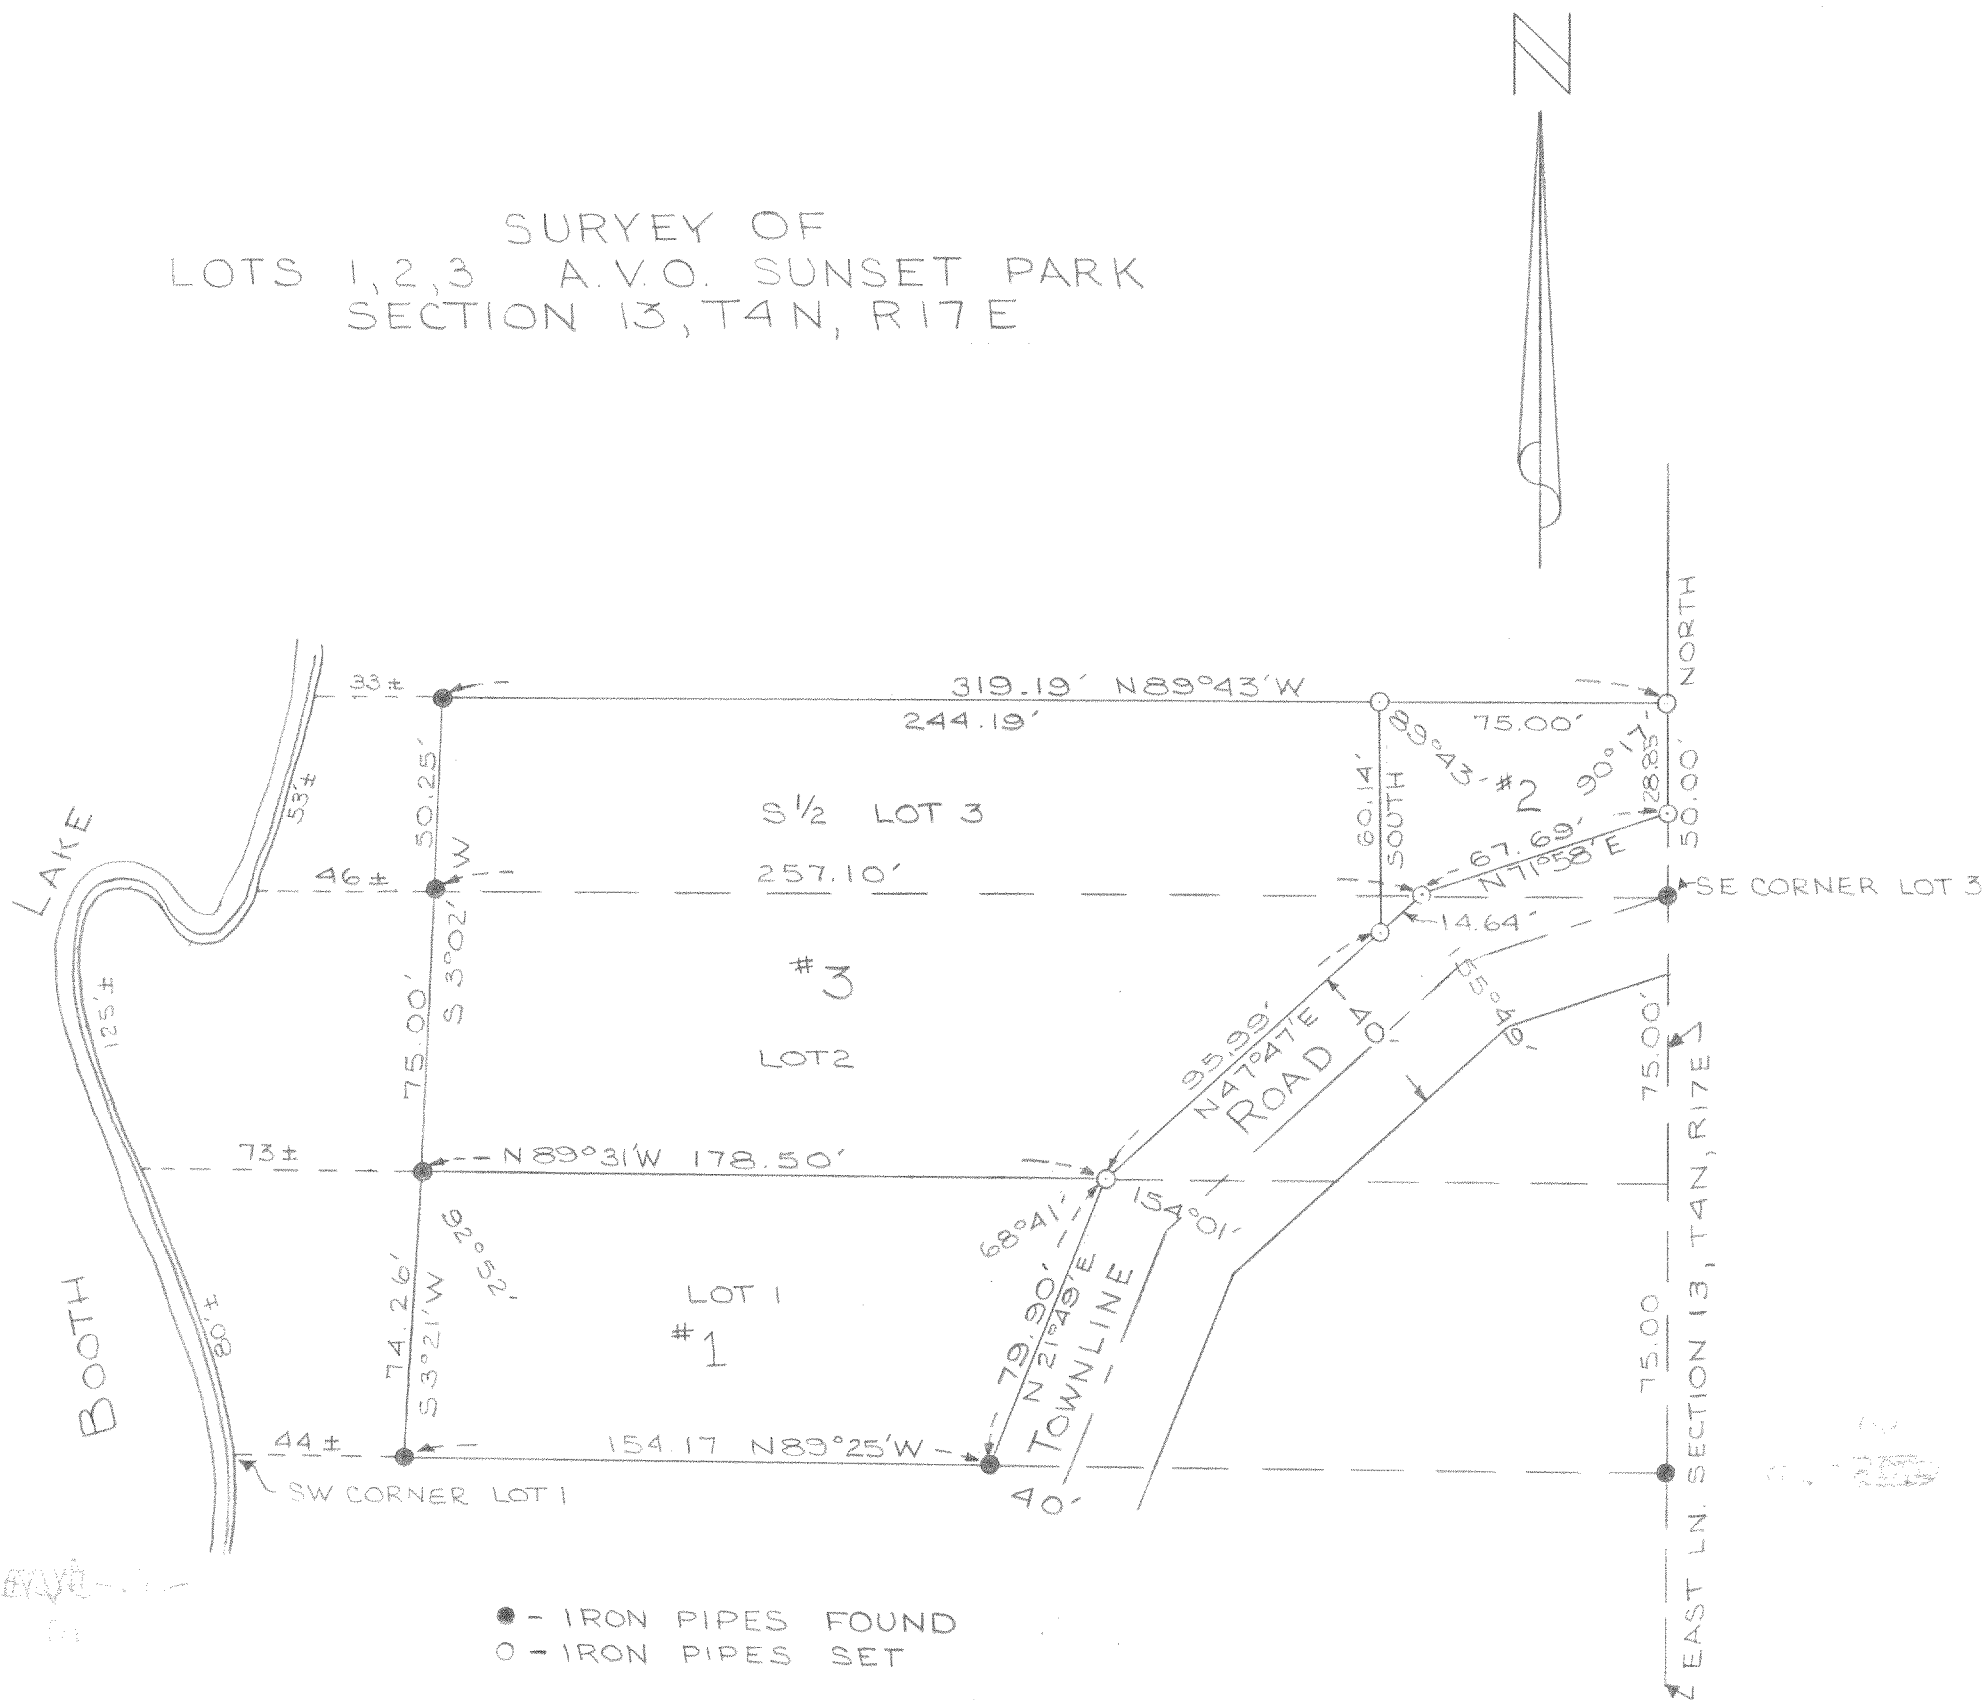

DESCRIPTIONS:

PARCEL 1 Commencing at the intersection of the shore of Booth Lake and the south line of Lot 1, A.V.O. Sunset Park, Section 13, T4N, R17E, Walworth County, Wisconsin, thence S 89°25' E, 44 feet more or less, thence S 89°25' E along said south line of said Lot 1, 154.17 feet to the west line of Townline Road, thence N 21°49' E along said west line of Townline Road, 79.90 feet to the north line of said Lot 1, thence N 89°31' W along said north line of Lot 1, 178.50 feet, thence continue N 89°31' W along said north line line of lot 1, 73 feet more or less to the shore of said Booth Lake, thence SE'ly along said shoreline 80 feet more or less to the place of beginning.


PARCEL 2 Commencing at the SE corner of Lot 3, A.V.O. Sunset Park, Section 13, T4N, R17E, Walworth County, Wisconsin, thence North along the East line of said section and of said Lot 3, 21.15 feet to the place of beginning of the lands hereinafter described, to wit; Thence North along said East line of of said Section and of said Lot 3, 28.85 feet, thence N 89°43' W, 75.00 feet, thence South 60.14 feet to the West line of said Townline Road, thence N 47° 47' E along said west line of Townline Road, 14.64 feet to the south line of said Lot 3, thence N 71°58' E along said west line of Townline Road, 67.69 feet to the place of beginning.

PARCEL 3 Commencing at the SE corner of Lot 3, A.V.O. Sunset Park, Section 13, T4N, R17E, Walworth County, Wisconsin, thence North along the East line of said section and of said Lot 3, 50.00 feet, thence N 89°43' W, 75.00 feet to the place of beginning of the lands hereinafter described, to wit; thence N 89° 43' W, 244.19 feet, thence continue N 89°43' W, 33 feet more or less to the shore of Booth Lake, thence Southerly along said shoreline, 178 feet more or less to the south line of Lot 2, said A.V.O. Sunset Park, thence S 89°31' E along said south line of said Lot 2, 73 feet more or less, thence continue S 89°31' E along said south line, 178.50 feet to the west line of Townline Road, thence N 47°47' E along said west line of said Townline Road, 95.99 feet, thence North, 60.14 feet to the place of beginning.

CERTIFICATE:

I, James F. Biagi, surveyor, do hereby certify that I have surveyed the lands hereon described.

September 3, 1970

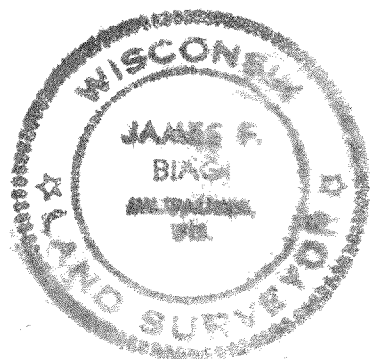

James F. Biagi
James F. Biagi R.L.S. 272