

KAEREK BUILDERS
Sullivan #4459




PLAT OF SURVEY

LOCATION: N8059 Nicky Court, Troy, Wisconsin

LEGAL DESCRIPTION: Lot 12 in APPLE WOOD ESTATES, being a subdivision of a part of the Northwest 1/4 of the Northeast 1/4 of Section 25, Town 4 North, Range 17 East, in the Town of Troy, Walworth County, Wisconsin.

December 19, 1996

Survey No. 87491

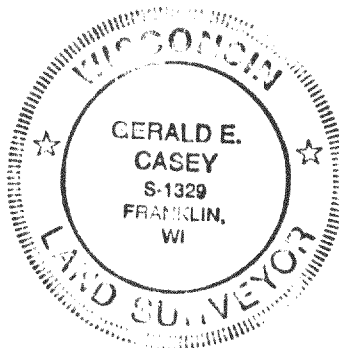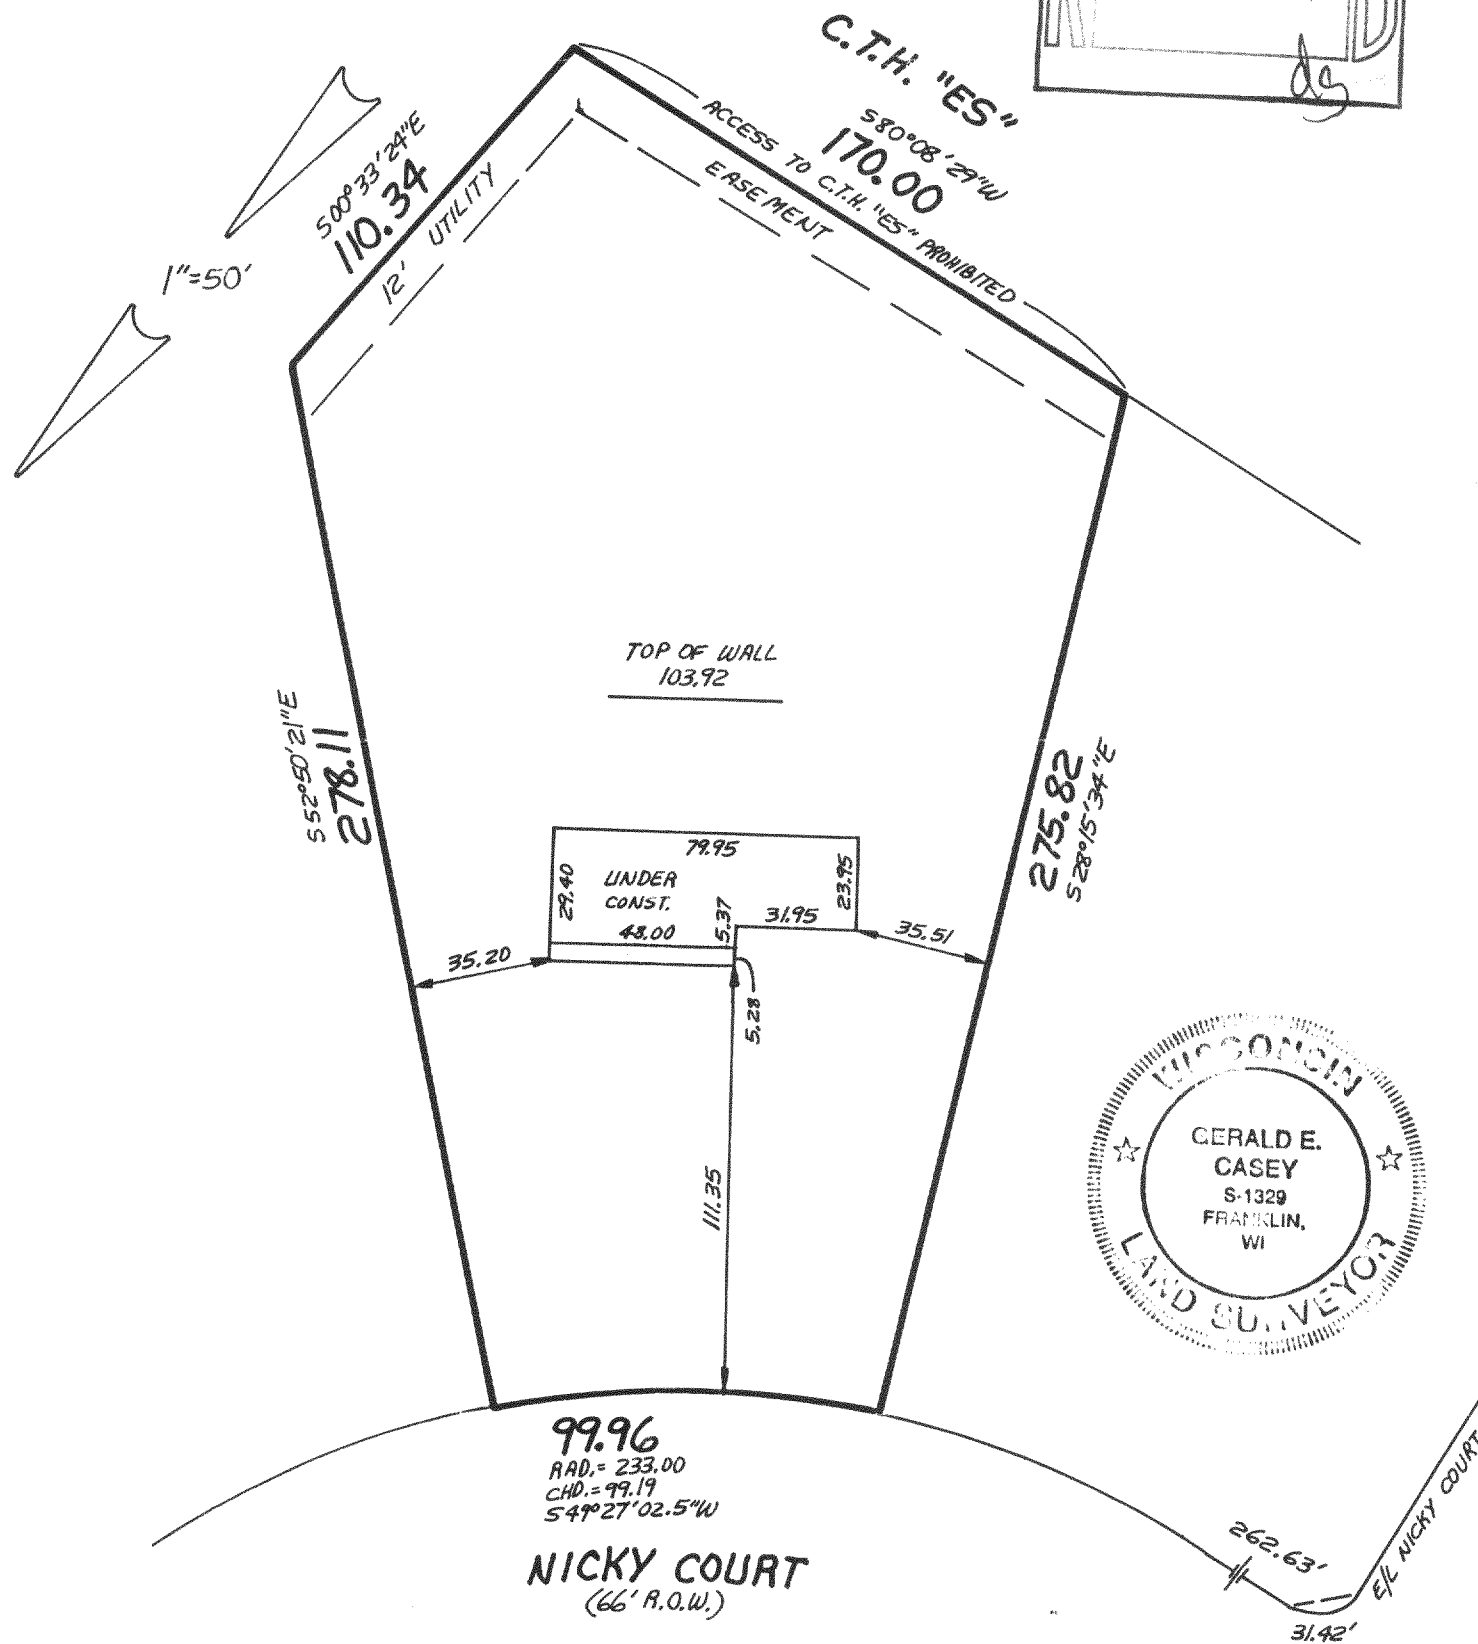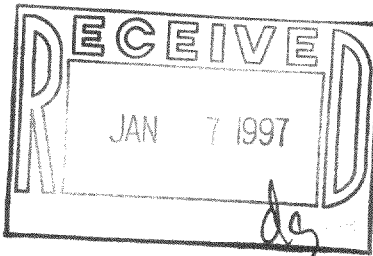

99.96
RAD. = 233.00
CHD. = 99.19
54°27'02.5"W
NICKY COURT
(66' R.O.W.)

METROPOLITAN SURVEY SERVICE, INC.

REGISTERED LAND SURVEYORS

9415 W. FOREST HOME AVE., SUITE 202, HALES CORNERS, WI 53130

PH. 529-5380 FAX 529-9787

I HEREBY CERTIFY THAT I HAVE SURVEYED THE ABOVE DESCRIBED PROPERTY AND THAT THE ABOVE MAP IS A TRUE REPRESENTATION THEREOF AND SHOWS THE SIZE AND LOCATION OF THE PROPERTY, ITS EXTERIOR BOUNDARIES, THE LOCATION OF ALL VISIBLE STRUCTURES AND DIMENSIONS OF ALL PRINCIPAL BUILDINGS THEREON, BOUNDARY FENCES, APPARENT EASEMENTS AND ROADWAYS AND VISIBLE ENCROACHMENTS, IF ANY.

THIS SURVEY IS MADE FOR THE EXCLUSIVE USE OF THE PRESENT OWNERS OF THE PROPERTY, AND ALSO THOSE WHO PURCHASE, MORTGAGE, OR GUARANTEE THE TITLE THERETO WITHIN ONE (1) YEAR FROM DATE HEREOF.

SIGNED

Gerald E. Casey
Registered Land Surveyor S-1329

417-471
LAP-12