

PLAT OF SURVEY

RSV ENGINEERING, INC
 ENGINEERS, PLANNERS, SURVEYORS
 CONSTRUCTION MANAGERS,
 ENVIRONMENTAL SCIENTISTS
 801 MAIN STREET, MUKWONAGO, WISCONSIN 53149 (414) 363-2004

RECERTIFICATION: 1/24/00
 DATE: 9-1-99

FOR: PAT WHITING



DESCRIPTION: LOT 14 OF APPLE WOOD ESTATES BEING LOCATED IN PART OF THE NW 1/4 OF THE NE 1/4 OF SECTION 25, TOWN 4 NORTH, RANGE 17 EAST, TOWN OF TROY, WALWORTH COUNTY, WISCONSIN.



SCALE 1" = 50'

LEGEND


- 2" FOUND IRON PIPE
- ∅ 1" FOUND IRON PIPE

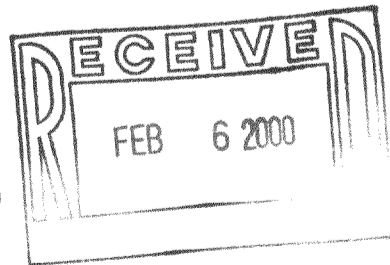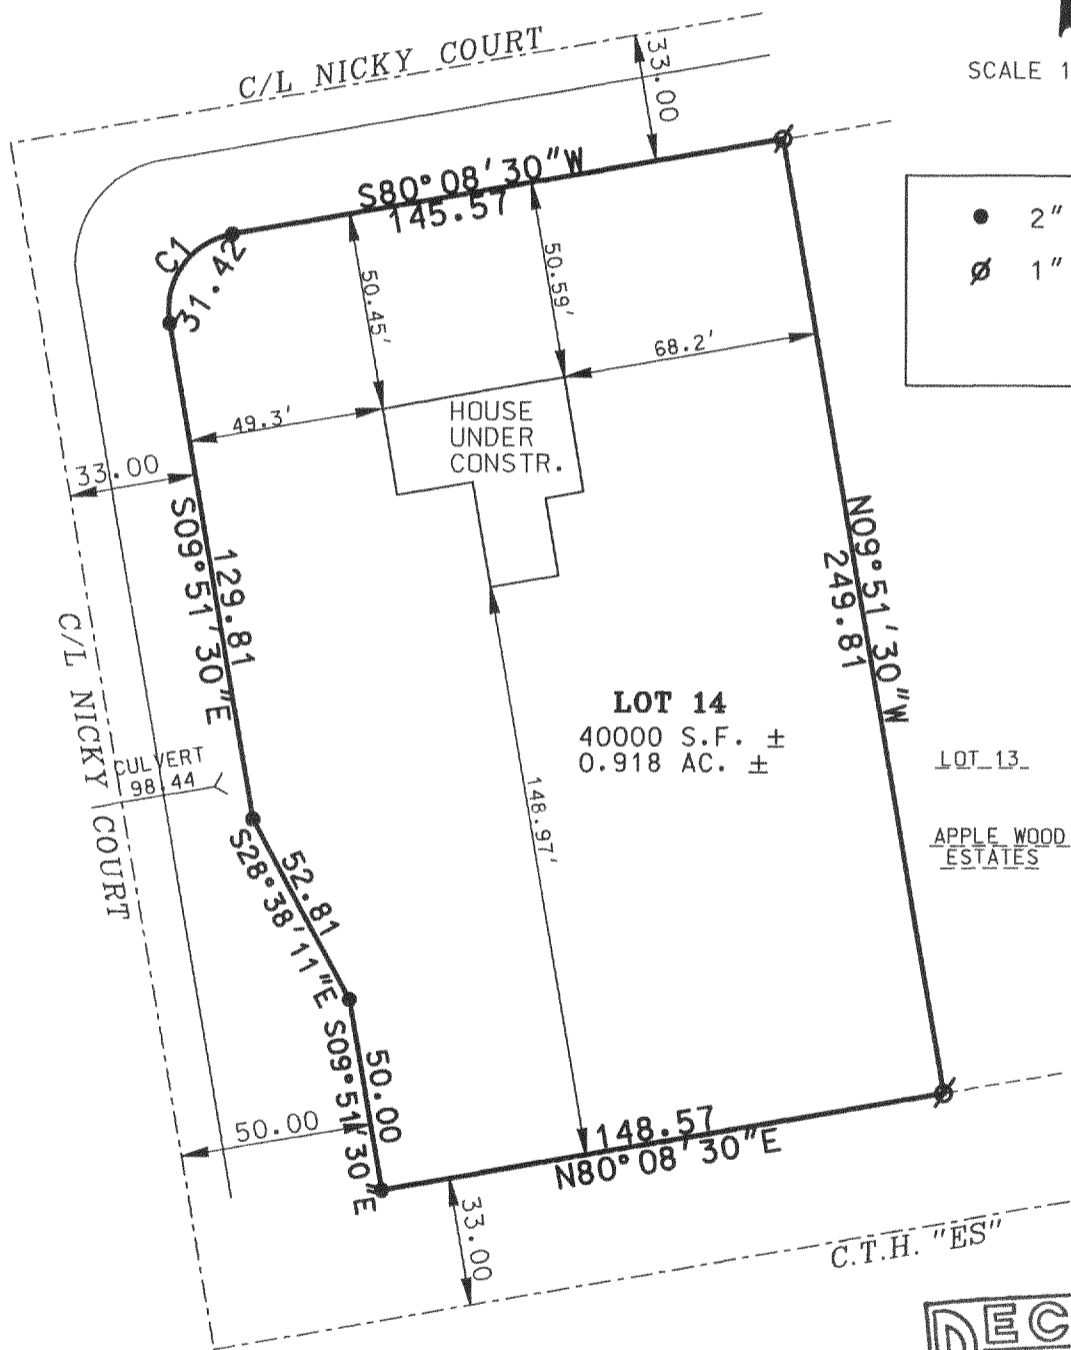

THE ABOVE MAP IS A TRUE REPRESENTATION THEREOF AND SHOWS THE SIZE AND LOCATION OF ALL THE PROPERTY, EXTERIOR BOUNDARIES, THE LOCATION OF ALL VISIBLE BOUNDARY FENCES, APPARENT EASEMENTS, ROADWAYS AND VISIBLE ENCROACHMENTS, IF ANY.

THIS SURVEY IS MADE FOR THE USE OF THE PRESENT OWNERS OF THE PROPERTY, AND ALSO THOSE WHO PURCHASE, MORTGAGE OR GUARANTEE TITLE THEREIN WITHIN ONE (1) YEAR FROM DATE HERETO.

**THIS IS ORIGINAL
 PRINT ONLY IF
 SEAL IS IMPRINTED
 IN RED**

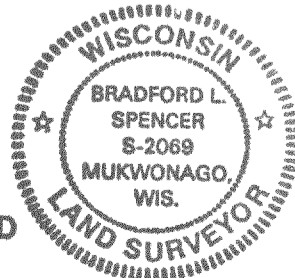

BRADFORD L. SPENCER, R.L.S. 2069
 RSV# 99217.DGN

LAP-14

417-591