

PLAT OF SURVEY





LEGAL DESCRIPTION:

BEING ALL THAT PART OF LOT 16, APPLE WOOD ESTATES, LOCATED IN PART OF THE NORTHWEST 1/4, OF THE NORTHEAST 1/4 OF SECTION 25, TOWN 4 NORTH, RANGE 17 EAST, TOWN OF TROY, WALWORTH COUNTY, WISCONSIN.

CURVE INFORMATION:

CURVE	DELTA	RADIUS	ARC	CHORD BEARING	CHORD
C1	134°00'31"	167.00'	390.60'	N66°26'56"E	307.46'

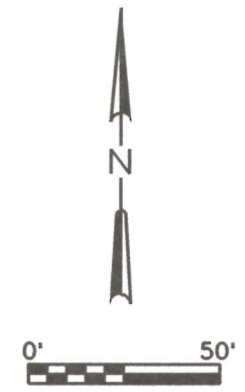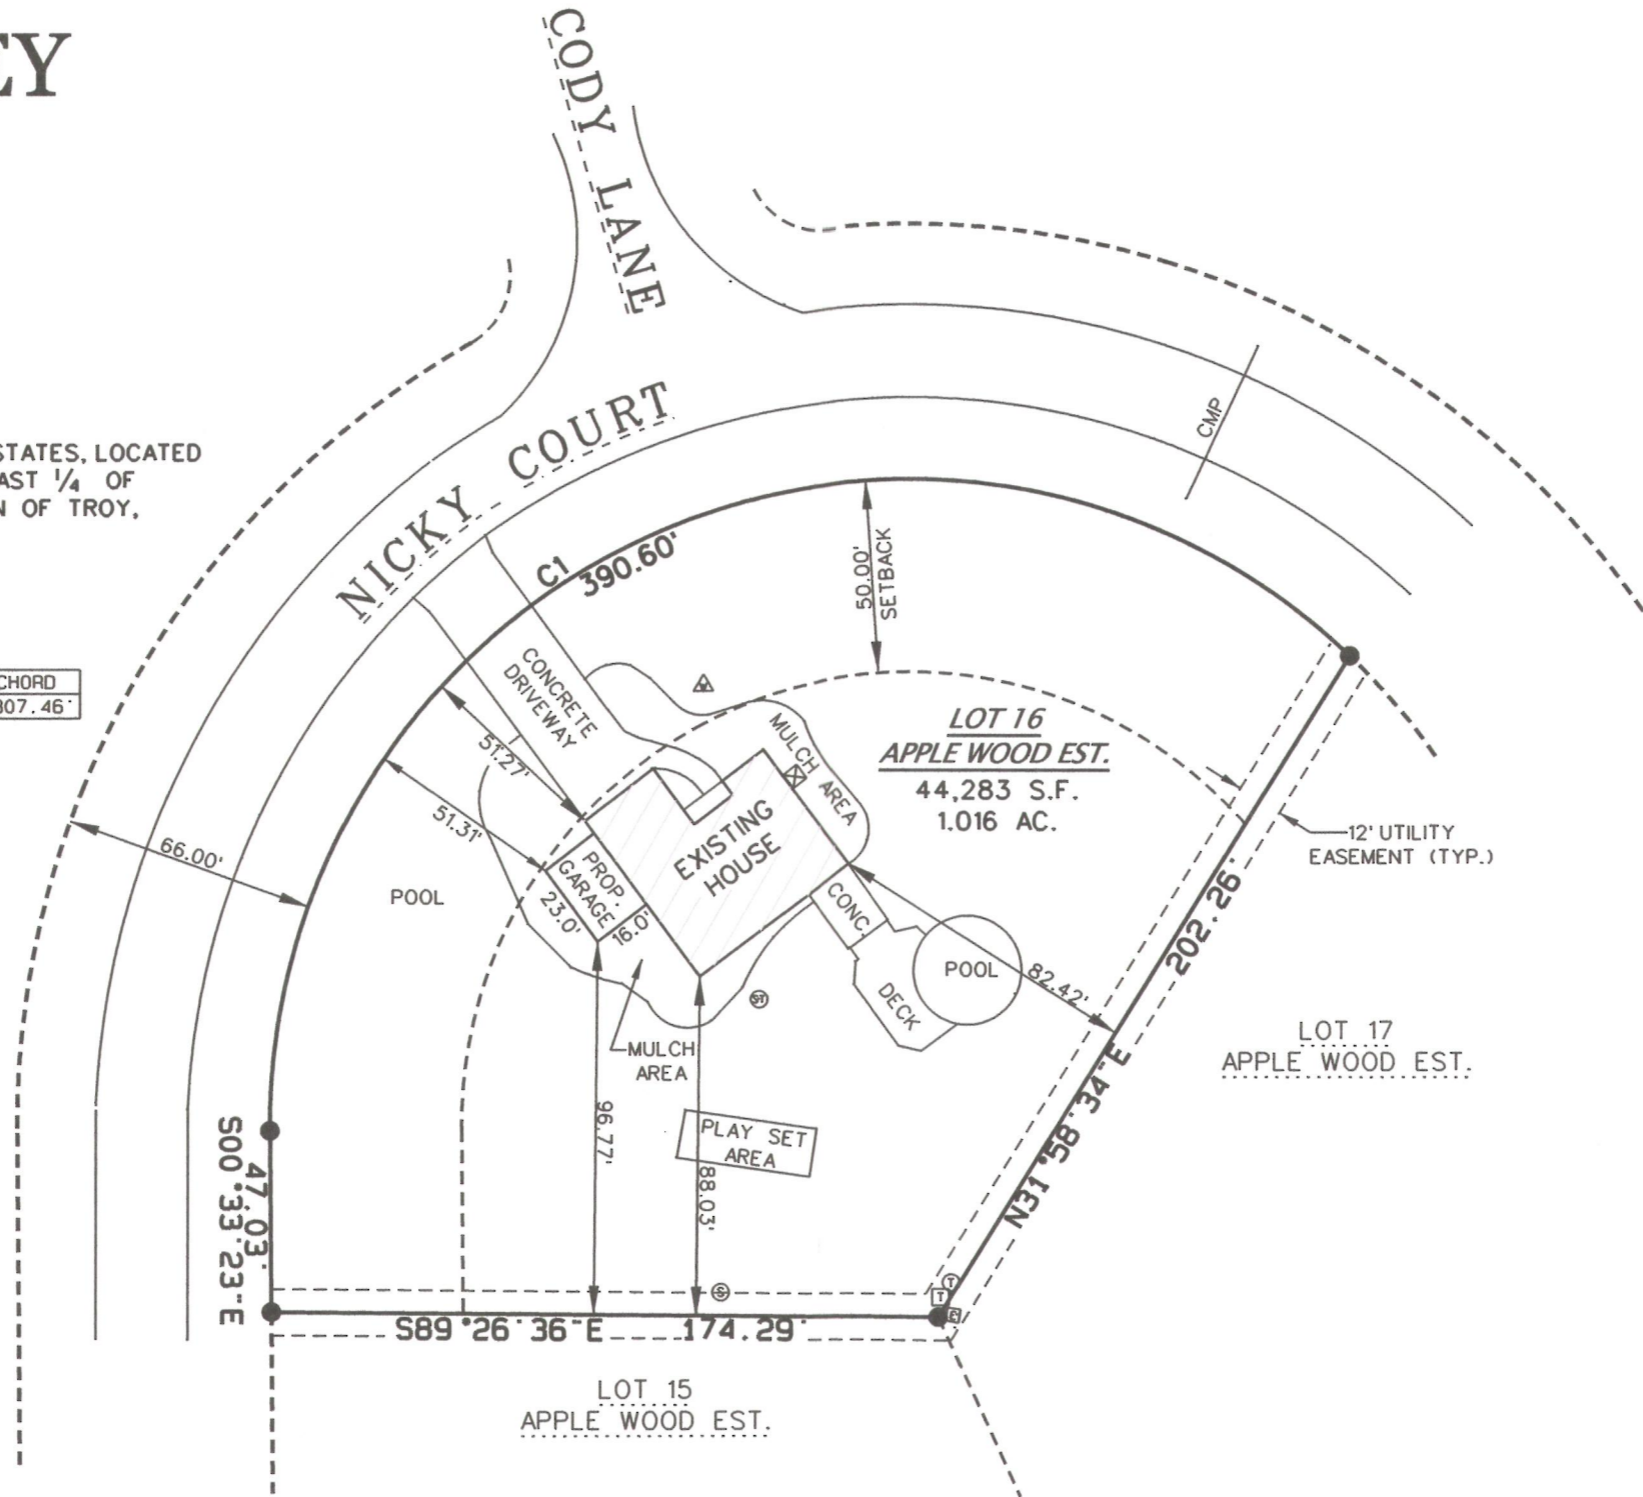

LEGEND:

- 100.00' MEASURED DISTANCE
- 1" FOUND IRON PIPE, UNLESS NOTED
- ⊗ 3/4" x 18" IRON PIPE SET, 1.13 lbs./L.F.
- △ WELL
- ⊕ SEPTIC TANK
- ⊙ SEPTIC VENT
- ⊠ TELEPHONE PEDESTAL
- ⊞ ELECTRIC TRANSFORMER
- ⊕ CABLE BOX
- ⊞ AIR CONDITIONER


FILE NAME: 2012-043 STRAIGHT ARROW APPLE WOOD EST SURVEY.DGN

SURVEY DATE: 07/12/2012
SURVEY MADE FOR:
 STRAIGHT ARROW BUILDERS
 W5571 LOST NATION ROAD
 ELKHORN WI 53121



THIS SURVEY IS MADE FOR THE USE OF THE PRESENT OWNERS OF THE PROPERTY, AND ALSO THOSE WHO PURCHASE, MORTGAGE OR GUARANTEE TITLE TO WITHIN ONE (1) YEAR FROM DATE HERETO.

I, MICHAEL A. GREESON R.L.S. *2770, HEREBY CERTIFY THAT THIS SURVEY WAS MADE IN ACCORDANCE WITH THE MINIMUM STANDARDS FOR PROPERTY SURVEYS (CHAPTER A-E 7) FOR THE STATE OF WISCONSIN AND HAS BEEN PREPARED UNDER MY DIRECTION AND CONTROL AND IS CORRECT TO THE BEST OF MY KNOWLEDGE AND BELIEF.

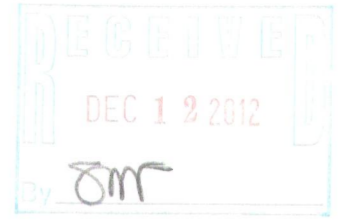

PLOT DATE: 7/12/12

V2G JOB#: 2012-043

417.952

LAP-16