
PLAT OF SURVEY -OF-

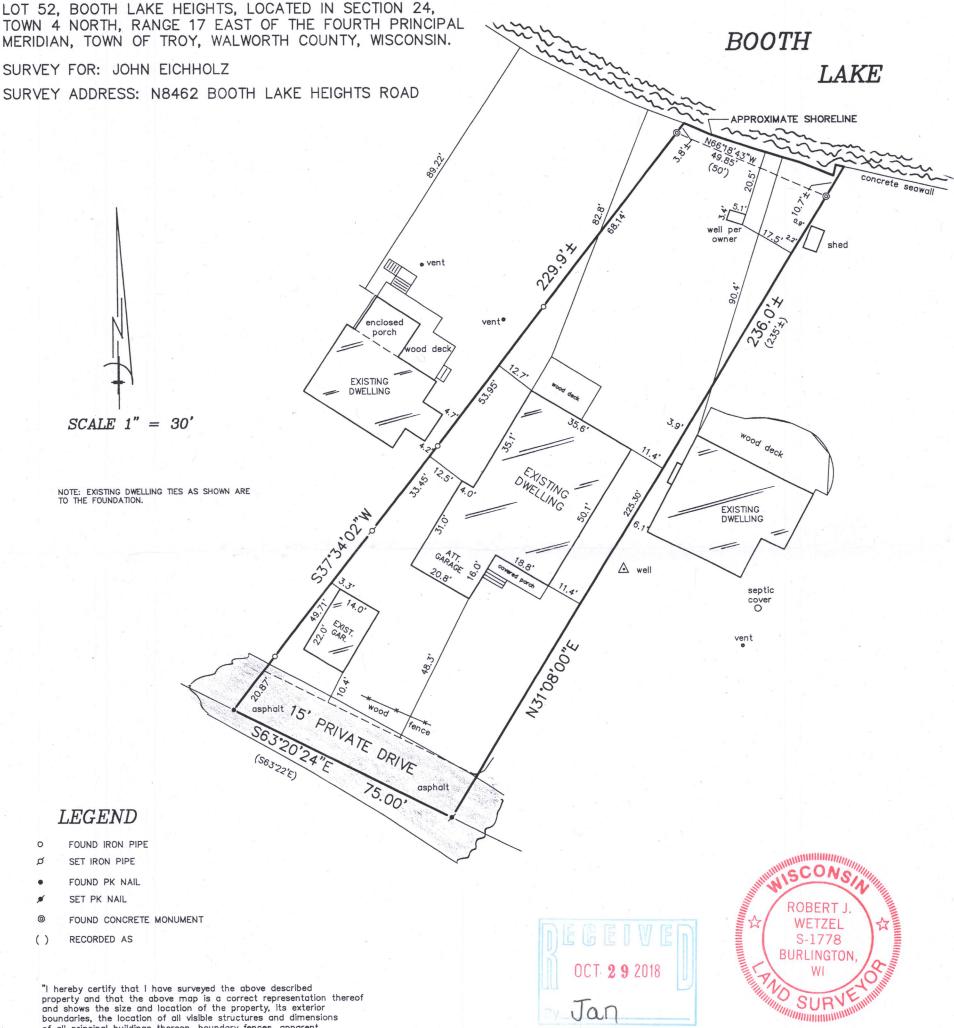

property and that the above map is a correct representation thereof and shows the size and location of the property, its exterior boundaries, the location of all visible structures and dimensions of all principal buildings thereon, boundary fences, apparent easements, roadways and encroachments, if any.

"This survey is made for the use of the present owners of the property, and those who purchase, mortgage, or guarantee the title thereto within one year from date hereof."



NOTE: REVISED TO MARK UP LOT LINES AS SHOWN. NO NEW IMPROVEMENTS UPDATED ON THIS REVISION.



B.W. SURVEYING, INC.

LAND SURVEYS MAPPING AND PLANNING 412 N. PINE STREET BURLINGTON, WI 53105 (262) - 767 - 0225

REVISED: JULY 18, 2018 REVISED: JULY 28, 2014 REVISED: DECEMBER 30, 2013 REVISED: OCTOBER 17, 2013 ROBERT J. WETZEL

AUGUST 12, 2009

8077

JOB NUMBER

DATE

THIS IS NOT AN ORIGINAL PRINT UNLESS THIS SEAL IS RED.