## LAND-MARK SURVEYING Mark L. Miritz

Wisconsin Professional Land Surveyor S-2582

SEC. 4-4-17

**N9330 Knuteson Drive** Whitewater, WI 53190 Phone:(262)495-3284 MARKMIRITZ@ LAND-MARKSURVEYING.COM

# PLAT OF SURVEY


**LOT 1 OF CERTIFIED SURVEY MAP NO. 3722, LOCATED** IN THE SOUTHEAST 1/4 OF THE NORTHWEST 1/4 OF **SECTION 4, TOWN 4 NORTH, RANGE 17 EAST, TOWN** OF TROY, WALWORTH COUNTY, WISCONSIN.

**OWNERS: ROBERT J. GUNN NANCY C. GUNN W3950 BLUFF ROAD EAGLE, WI 53119** 

## LOT 1

75.214 S.F. ( 1.73 AC.) TOTAL 62,134 S.F. (1.43 AC.) C-2 13,080 S.F ( 0.30 AC.) C-4

# **RESIDENCE DETAIL**

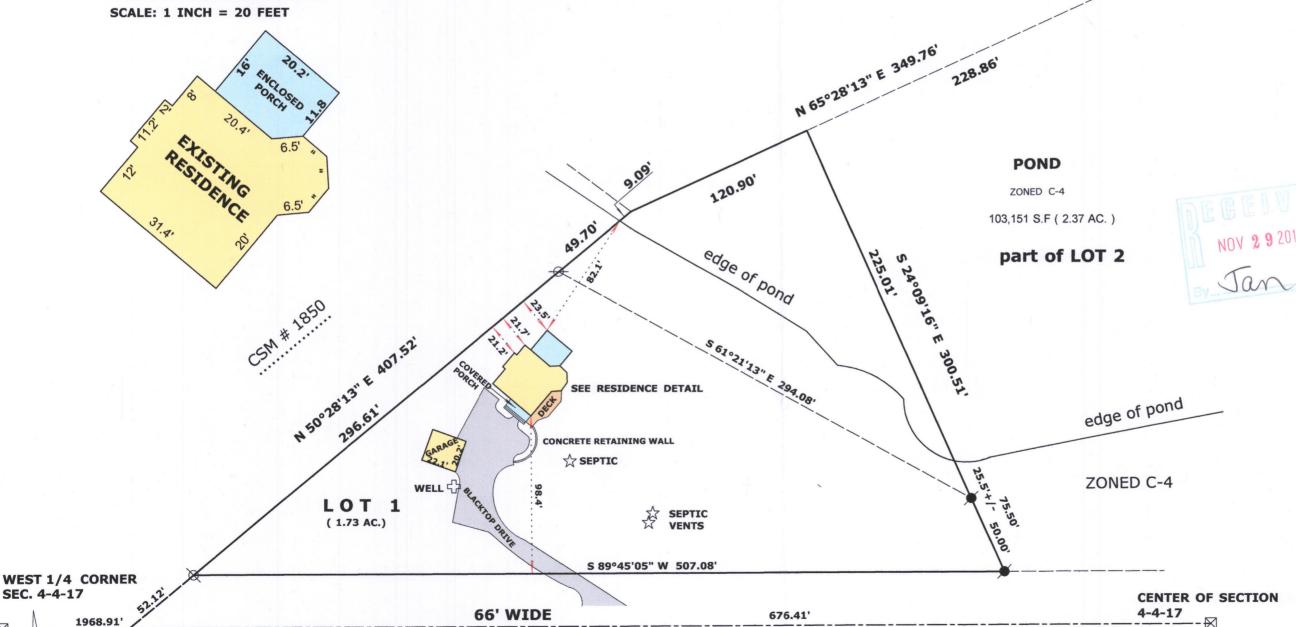





# **LEGEND**

FOUND IRON PIPE

**FOUND IRON ROD** 

 $\boxtimes$ FOUND COUNTY MONUMENT

RECORDED AS DIMENSION

SCALE: 1 INCH = 60 FEET

(xx)

"I hereby certify that the above described property has been surveyed by me or under my direction and that the above map is a true representation thereof and shows the size and location of the property, its exterior boundaries, the location of all visible structures and dimensions of all principal buildings thereon, boundary fences, apparent easements, roadways and visible encroachments, if any."

"This survey is made for the use of the present owners of the property, and also those who purchase, mortgage, or

MARK L. MIRITZ WISCONSIN PROFESSIONAL

**LAND SURVEYOR S-2582** 

DATE: OCT. 12, 2005 JOB NO. 02.1202

**BLUFF ROAD** 

S 89°45'04"W

- 2645.32' -

**REVISED JUNE 30, 2018 TO** SHOW PROPOSED ADDITION REVISED OCT. 10, 2018 TO SHOW ENCLOSED PORCH "AS BUILT"