


FILE NAME: V:\V2G PROJECTS\088 Paul Nyffeler 2 Surveys N8570 & N8574 Booth Lake Heights Rd

IMPERVIOUS SURFACES

LOT 21, BOOTH LAKE HEIGHT SUBDIVISION, LOCATED IN PART OF SECTIONS 13 AND 24,
TOWNSHIP 4 NORTH, RANGE 17 EAST, TOWN OF TROY, WALWORTH COUNTY, WISCONSIN.

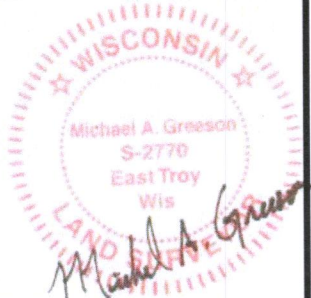

THIS SURVEY IS MADE FOR THE USE OF THE PRESENT OWNERS
OF THE PROPERTY, AND ALSO THOSE WHO PURCHASE, MORTGAGE
OR GUARANTEE TITLE TO WITHIN ONE (1) YEAR FROM DATE HERETO.

I, MICHAEL A. GREESON P.L.S. #2770, HEREBY CERTIFY THAT THIS
SURVEY WAS MADE IN ACCORDANCE WITH THE MINIMUM STANDARDS
FOR PROPERTY SURVEYS (CHAPTER A-E 7) FOR THE STATE OF WISCONSIN
AND HAS BEEN PREPARED UNDER MY DIRECTION AND CONTROL AND IS
CORRECT TO THE BEST OF MY KNOWLEDGE AND BELIEF.

SURVEY MADE FOR:
NYFFELER RENTALS LLC
N8481 DIVISION RD
EAST TROY WI, 53120

DATE	ITEM
06/25/2020	ORIGINAL SURVEY

V²G
SURVEYING, LLC
123 WOLF RUN - SUITE 4
MUKWONAGO, WI 53149
(262) 378-5097



LOT 20


LOT 21
10,532.61 S.F.

LOT 22

BOOTH LAKE

E

- LEGEND:**
- (100.00') RECORDED DISTANCE
 - 100.00' MEASURED DISTANCE
 - 1" FOUND IRON PIPE, UNLESS NOTED
 - ⊗ 3/4" x 18" IRON PIPE SET, 1.13 lbs./L.F.
 - △ WELL
 - ⊙ SEPTIC TANK
 - ⊙ SEPTIC VENT
 - ⊗ LIGHT POLE
 - ⊡ ELECTRIC TRANSFORMER
 - ⊙ ELECTRIC PEDESTAL
 - ⊡ TELEPHONE PEDESTAL
 - ⊙ CABLE TV PEDESTAL

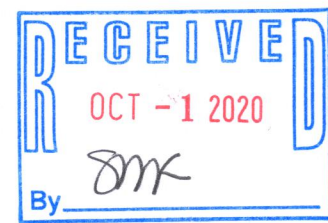

PLOT DATE: 06/25/2020

V2G JOB#: 2020-088

LBL-19

417-1119