


# Plat of Survey

of

The East line of Lot 6 of Surrey Ridge,  
a subdivision located in the Northwest  
1/4 of Section 31, Town 4 North, Range  
17 East, Town of Troy, Walworth County,  
Wisconsin.


Surveyed for: Jim Powers, Regional VP/Broker  
**Country Lakes Realty, Inc.**  
P.O. Box 8127  
Janesville, Wisconsin. 53544  
(800) 827-6815

Attn: Leo Kalinowski

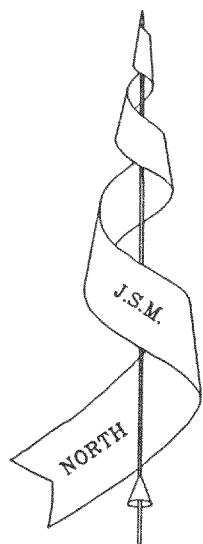

Bearings referenced to the  
Subdivision Plat.

Note: This survey plat is not  
certified unless signed  
and sealed in red ink.

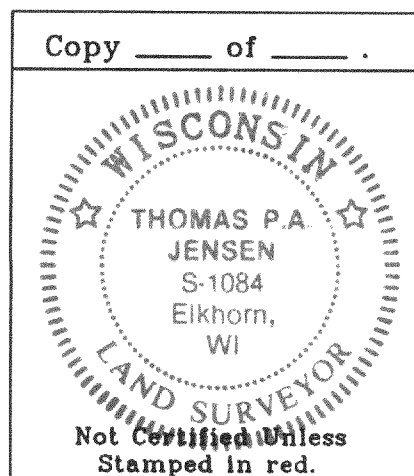

Lot 6

S 78°18'39" W  
423.44

Rod 3' West  
of fence.

Rod 4' West  
of fence.



Rod 4' West  
of fence.

Rod 5.5' West  
of fence.

Rod 5.5' West  
of fence.

Rod 6' West  
of fence.

574.34  
N 88°05'00" W

Lot 7

Copyright © 1995 by Jensen Surveying & Mapping S.C.

All rights reserved. No part of this survey plat may be reproduced  
or transmitted in any form by any means - graphic, electronic, or  
mechanical, including photocopying, tracing, or information storage  
and retrieval systems - without permission in writing from Thomas  
P.A. Jensen, Jensen Surveying & Mapping S.C..

I, Thomas P.A. Jensen, Wisconsin Registered Land Surveyor, do  
hereby certify that this survey was performed by me, or under my  
direction in full compliance with the owner's / agent's instructions  
and Chapter A-E 7 of the Wisconsin Administrative Code "Minimum  
Standards for Property Surveys"; and that this map is as accurate  
representation thereof to the best of my knowledge and belief.

Date: \_\_\_\_\_

Thomas P.A. Jensen R.L.S. 1084

## Legend

- Found Iron Rod 3/4" dia.
- Set Iron Rod 3/4" dia.

## Jensen Surveying & Mapping S.C.

45 South Wisconsin Street P.O. Box 322

Elkhorn, Wisconsin. 53121

Telephone & Facsimile (414) 723-3434

Mapping Date: 4-26-95

Revisions:

Sheet 1 of 1 Sheets

Job Reference No.

1995.034

Scale in feet: 1" = 100'



LSR-6

417-444