


PLAT OF SURVEY  
LOTS 1, 2, AND 3, BLOCK 6, IN THE VILLAGE OF TROY CENTER, being a part of the Northeast 1/4 of Section 15, Town 4 North, Range 17 East, Village of Troy Center, Walworth County, Wisconsin.

Surveyed for: Shirley Voght


Survey Address: W3329 4th Street

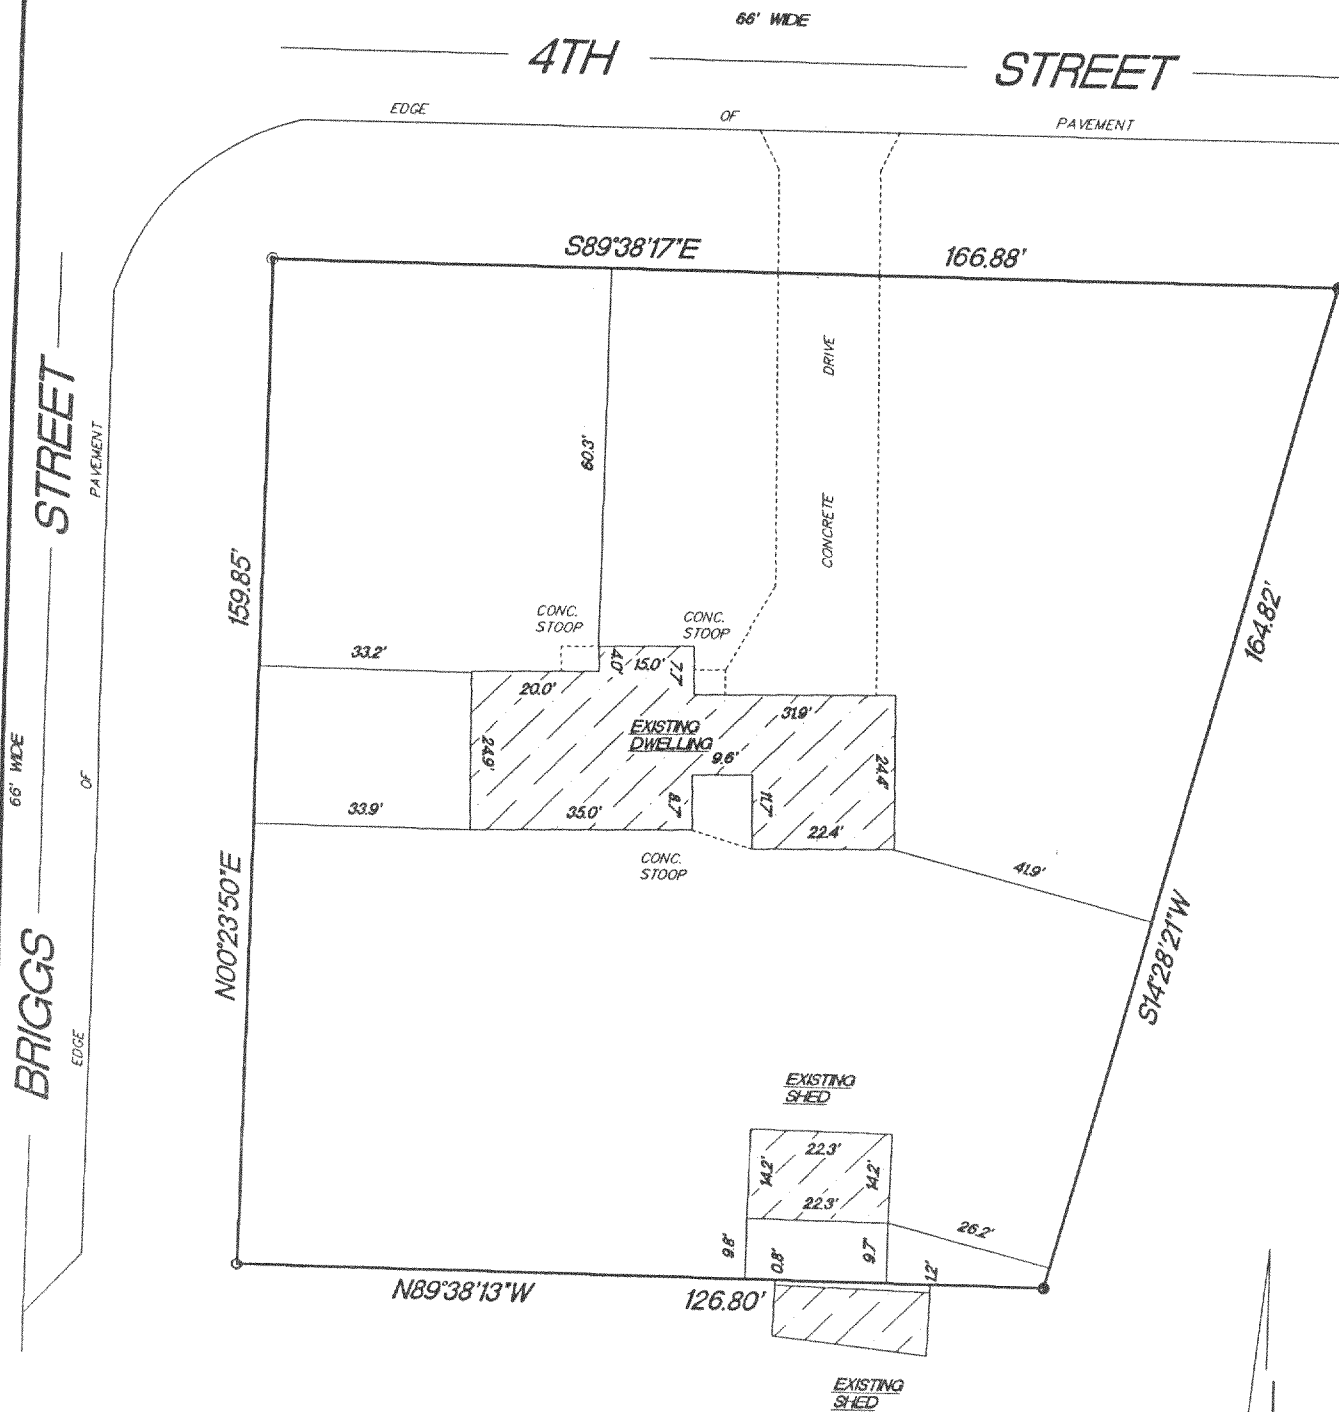

- FOUND 1 1/4" IRON PIPE
- FOUND 1" IRON PIPE
- ⊙ FOUND SPIKE

"I hereby certify that I have surveyed the above described property and that the above map is a true representation thereof and shows the size and location of the property, its exterior boundaries, the location of all visible structures and dimension of all principal buildings thereon, boundary fences, apparent easements, roadways and encroachments if any."

"This survey is made for the use of the present owners of the property, and also those who purchase, mortgage or guarantee the title thereto within one year from date hereof."

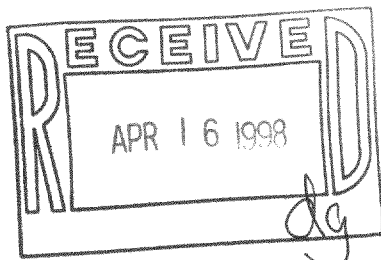

SCALE 1"=30'



W362 S10227 Lewin Lane  
Eagle, Wisconsin 53119  
Terrance E. Pisarek R.L.S.

(414) 594-3484  
fax (414) 594-5904

THIS IS NOT AN ORIGINAL SURVEY UNLESS THE SEAL IS RED.

4/14/98  
DATE

TEP/JAP  
FIELD WORK BY

TEP  
DRAWN BY

98061  
JOB NUMBER

LTC-17  
417-523