


Plat of Survey
LOT 27, BLOCK 2, SWIFT LAKE SUBDIVISION, being a part of the South
½ of Section 8, Town 4 North, Range 17 East, in the Town of Troy,
Walworth County, Wisconsin.

Surveyed for: Mr. And Mrs. Jerry Krueger

Survey address: N9009 Swift Lake Road

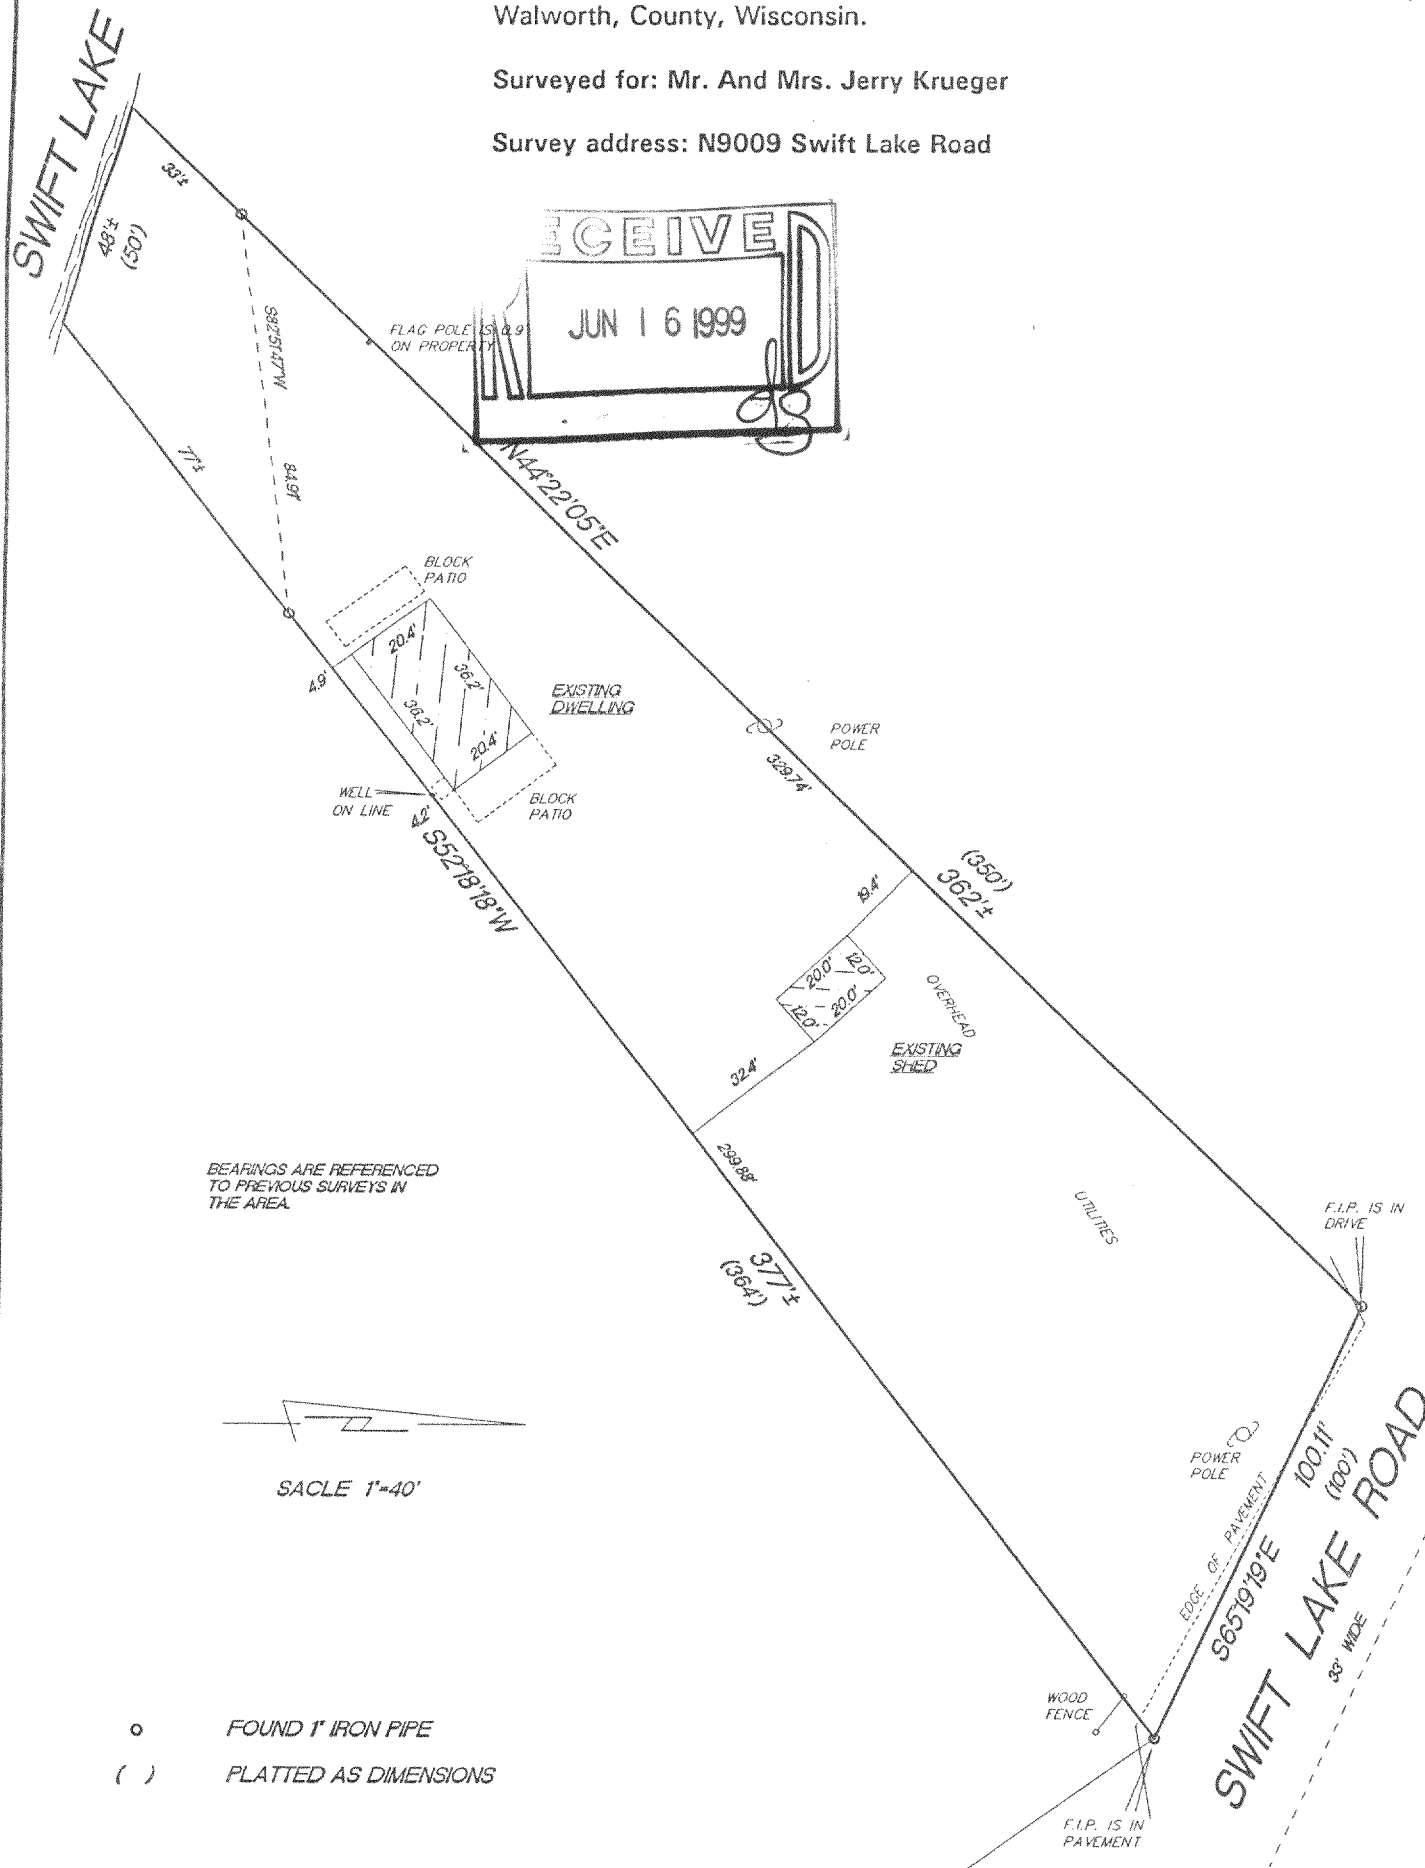


"I hereby certify that I have surveyed the above described property and that the above map is a true representation thereof and shows the size and location of the property, its exterior boundaries, the location of all visible structures and dimension of all principal buildings thereon, boundary fences, apparent easements, roadways and encroachments if any."

"This survey is made for the use of the present owners of the property, and also those who purchase, mortgage or guarantee the title thereto within one year from date hereof."



W356 S9050 Godfrey Lane
P.O. Box 357
Eagle WI. 53119

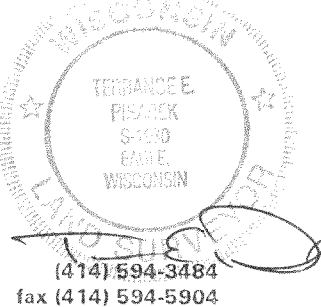

THIS IS NOT AN ORIGINAL SURVEY UNLESS THE SEAL IS RED.

5/17/99
DATE

TEP/BJ
FIELD WORK BY

TEP
DRAWN BY

99133
JOB NUMBER

LSL-23
417-559