


Plat of Survey

of


Lot 10 of Surrey Ridge,

a subdivision located in the Southwest 1/4 of Section 31, Town 4 North,
Range 17 East, Town of Troy, Walworth County, Wisconsin.

Surveyed for: **Chip & Sue Seib**
2926 Union Street
East Troy, Wisconsin. 53120

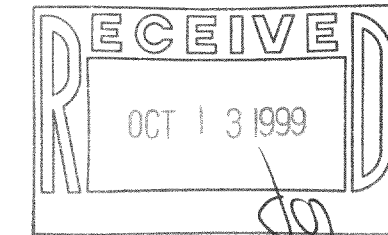

Detail

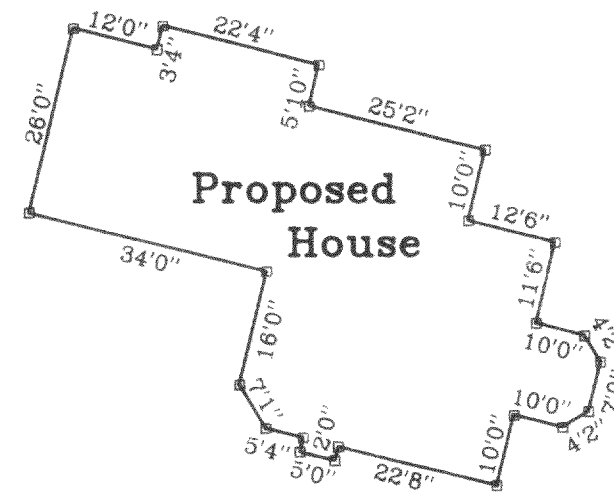

Lot 9

S 88°05'00" E 1134.94

1008.00

126.94

33.00

32.82

N 01°05'55" E 300.77

Lot 10
8.360 Acres
364,158 Sq.Ft.

Zoning line as scaled from Walworth
County zoning maps.

Zoning line as scaled from Walworth
County zoning maps.

N 89°36'13" E 1116.98

876.98

100.00

140.00

Lot 11


Copyright © 1999 by Jensen & Olson Land Surveying, LLC

All rights reserved. No part of this survey plat may be reproduced or transmitted in any form by any means - graphic, electronic, or mechanical, including photocopying, tracing, or information storage and retrieval systems - without permission in writing from Douglas G. Olson, Jensen & Olson Land Surveying, LLC.

I, Douglas G. Olson, Wisconsin Registered Land Surveyor, do hereby certify that this survey was performed by me, or under my direction in full compliance with the owner's / agent's instructions and Chapter A-E 7 of the Wisconsin Administrative Code "Minimum Standards for Property Surveys"; and that this map is as accurate representation thereof to the best of my knowledge and belief.

Date: April 24, 1999

Douglas G. Olson R.L.S. 2093

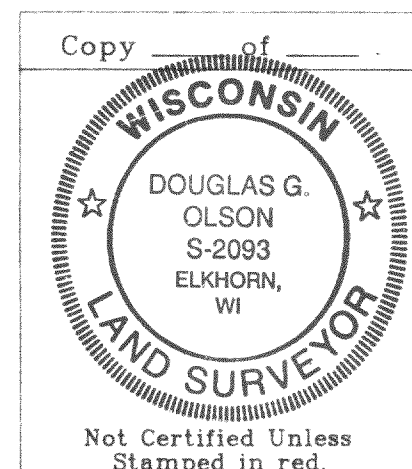

Note A: Monumentation of this corner as required by Chapter A-E-7.03 of the Wisconsin Administrative Code has been waived by Chip & Sue Seib per Chapter A-E-7.01(2).

Note: This survey plat is not certified unless signed and sealed in red ink.

Note: This survey is subject to Wisconsin lien laws. This Plat of Survey is the notice of intent to file lien. Lien waiver required.

Mapping date: March 5, 1999.
Revisions: April 14, 1999.
April 24, 1999.

Scale in Feet
1" = 60'



Jensen & Olson Land Surveying, LLC

45 South Wisconsin Street P.O. Box 322
Elkhorn, Wisconsin. 53121
Telephone: (414) 723-3434
Facsimile: (414) 723-8044

Legend

- Found Iron Rod
- Set Iron Rod, 3/4" dia.
- Recorded Information
- Wood Stake Set 4-12-99
- Soil Boring Marker 4-25-99


Sheet 1 of 1 Sheets.

Job Reference Number
1999.013

1999.013

LSR-10
417-569

Detail
1"=20'

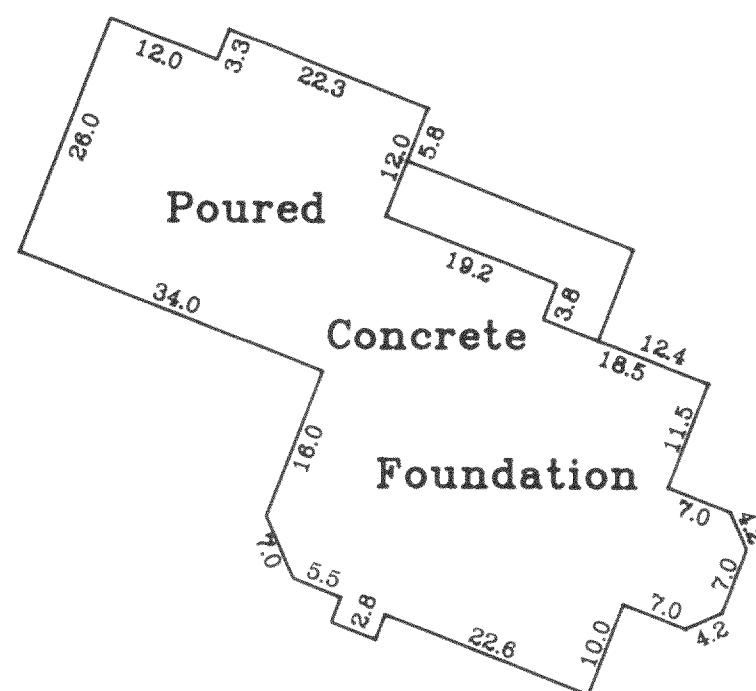


Plat of Survey

of

Lot 10 of Surrey Ridge,

a subdivision located in the Southwest 1/4 of Section 31, Town 4 North,
Range 17 East, Town of Troy, Walworth County, Wisconsin.

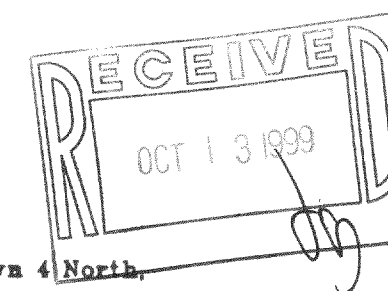

Surveyed for: **Chip & Sue Seib**
2926 Union Street
East Troy, Wisconsin. 53120

Mapping date: July 14, 1999.

Revisions:

Scale in Feet
1"= 60'



Jensen & Olson Land Surveying, LLC

45 South Wisconsin Street P.O. Box 322
Elkhorn, Wisconsin. 53121

Telephone: (414) 723-3434

Facsimile: (414) 723-8044

Legend
Found Iron Rod
() Recorded Information

Sheet 1 of 1 Sheets

Job Reference Number
1999.076

1999.076

Carriage Drive
(86' Wide)

N 01°54'59" W 346.59

A-1 Zoning
C-2 Zoning

Zoning line as scaled from Walworth
County zoning maps.

Zoning line as scaled from Walworth
County zoning maps.

Lot 10
8.360 Acres
364,158 Sq.Ft.

Lot 9

S 88°05'00" E 1134.94

1008.00

126.94

33.00

N 01°05'55" E 300.77

32.82

**Poured Concrete
Foundation**

See Detail

192.6'

31.0'


100.00

140.00

876.98

N 89°36'13" E 1116.98

Lot 11

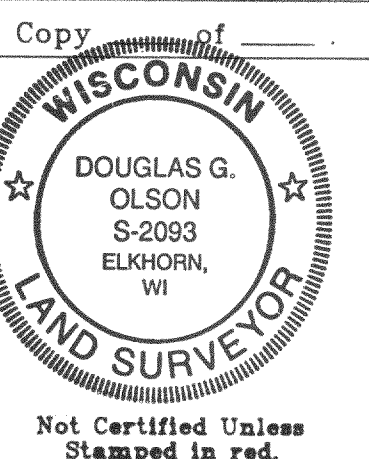

Note A: Monumentation of this corner as required by Chapter A-E-7.03
of the Wisconsin Administrative Code has been waived by Chip
& Sue Seib per Chapter A-E-7.01(2).

Note: This survey plat is not
certified unless signed
and sealed in red ink.

Note: This survey is subject to Wisconsin lien laws.
This Plat of Survey is the notice of intent
to file lien. Lien waiver required.

Copyright © 1999 by Jensen & Olson Land Surveying, LLC

All rights reserved. No part of this survey plat may be reproduced
or transmitted in any form by any means - graphic, electronic, or
mechanical, including photocopying, tracing, or information storage
and retrieval systems - without permission in writing from Douglas G.
Olson, Jensen & Olson Land Surveying, LLC.

I, Douglas G. Olson, Wisconsin Registered Land Surveyor, do
hereby certify that this survey was performed by me, or under my
direction in full compliance with the owner's / agent's instructions
and Chapter A-E 7 of the Wisconsin Administrative Code "Minimum
Standards for Property Surveys"; and that this map is as accurate
representation thereof to the best of my knowledge and belief.

Date: 7-14-99

Douglas G. Olson R.L.S. 2093

417-569