


PLAT OF SURVEY

LOTS 34, 35, 36, 37, 38, 39, BLOCK 2, IN SWIFT LAKE SUBDIVISION, Town of Troy, Town Four (4) North, Range Seventeen (17) East, Walworth County Wisconsin.

Surveyed for: Jerry Kutchera

Survey address: N9053 Swift Lake Road

BEARINGS ARE REFERENCED
TO A PREVIOUS SURVEY

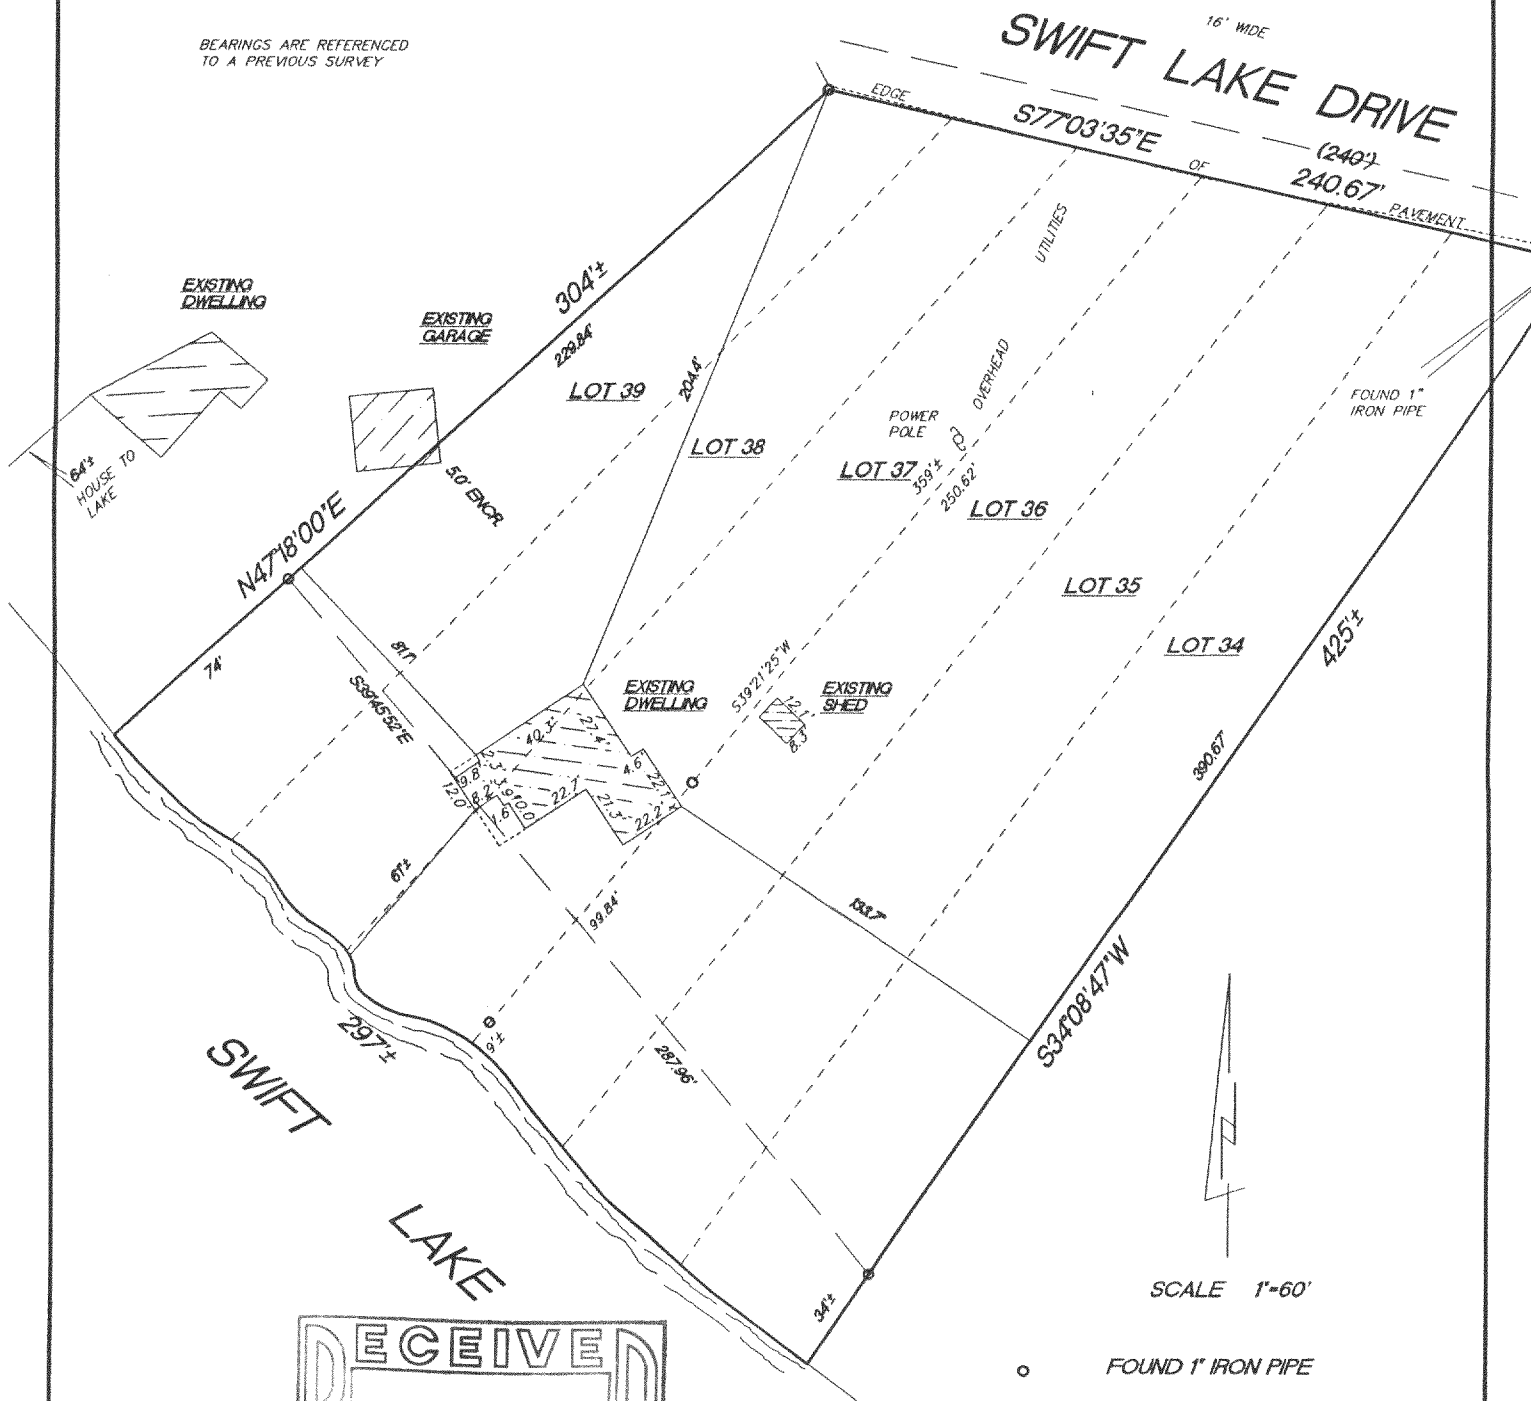

"I hereby certify that I have surveyed the above described property and that the above map is a true representation thereof and shows the size and location of the property, its exterior boundaries, the location of all visible structures and dimension of all principal buildings thereon, boundary fences, apparent easements, roadways and encroachments if any."

"This survey is made for the use of the present owners of the property, and also those who purchase, mortgage or guarantee the title thereto within one year from date hereof."

KETTLE MORaine SURVEYING
W356 S9050 Godfrey Lane
Eagle Wisconsin 53119
P.O. Box 357
(262) 594-3484

Terrance E. Pisarek R.L.S.

THIS IS NOT AN ORIGINAL SURVEY UNLESS THE SEAL IS RED.

9/19/00

DATE

TEP/DW

FIELD WORK BY

TEP

DRAWN BY

00254

JOB NUMBER

LSL-28
LSL-28A

417-608