

# PLAT OF SURVEY

**RSV**

**ENGINEERING, INC.**

Engineers • Land Surveyors • Environmental Scientists  
801 MAIN STREET MUKWONAGO, WISCONSIN 53149 (262)363-2004

FOR: WILLIAM SULLIVAN

DATE: 1/31/02



DESCRIPTION: LOT 8 OF BOOTH LAKE HEIGHTS, LOCATED  
IN PART OF SECTION 13 AND SECTION 24, TOWN 4 NORTH,  
RANGE 17 EAST, TOWN OF TROY, WALWORTH COUNTY, WISCONSIN.

## LEGEND

	POWER POLE
	TELEPHONE PEDESTAL
	FENCE
	1"X18" IRON PIPE SET
	PK NAIL SET
	1" 1/2" R IRON PIPE OR REBAR FOUND
	SEPTIC VENT
	CLEAN OUT
	WELL
	CONCRETE AREA
	GRAVEL AREA



SCALE 1" = 40'

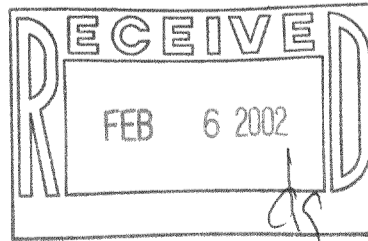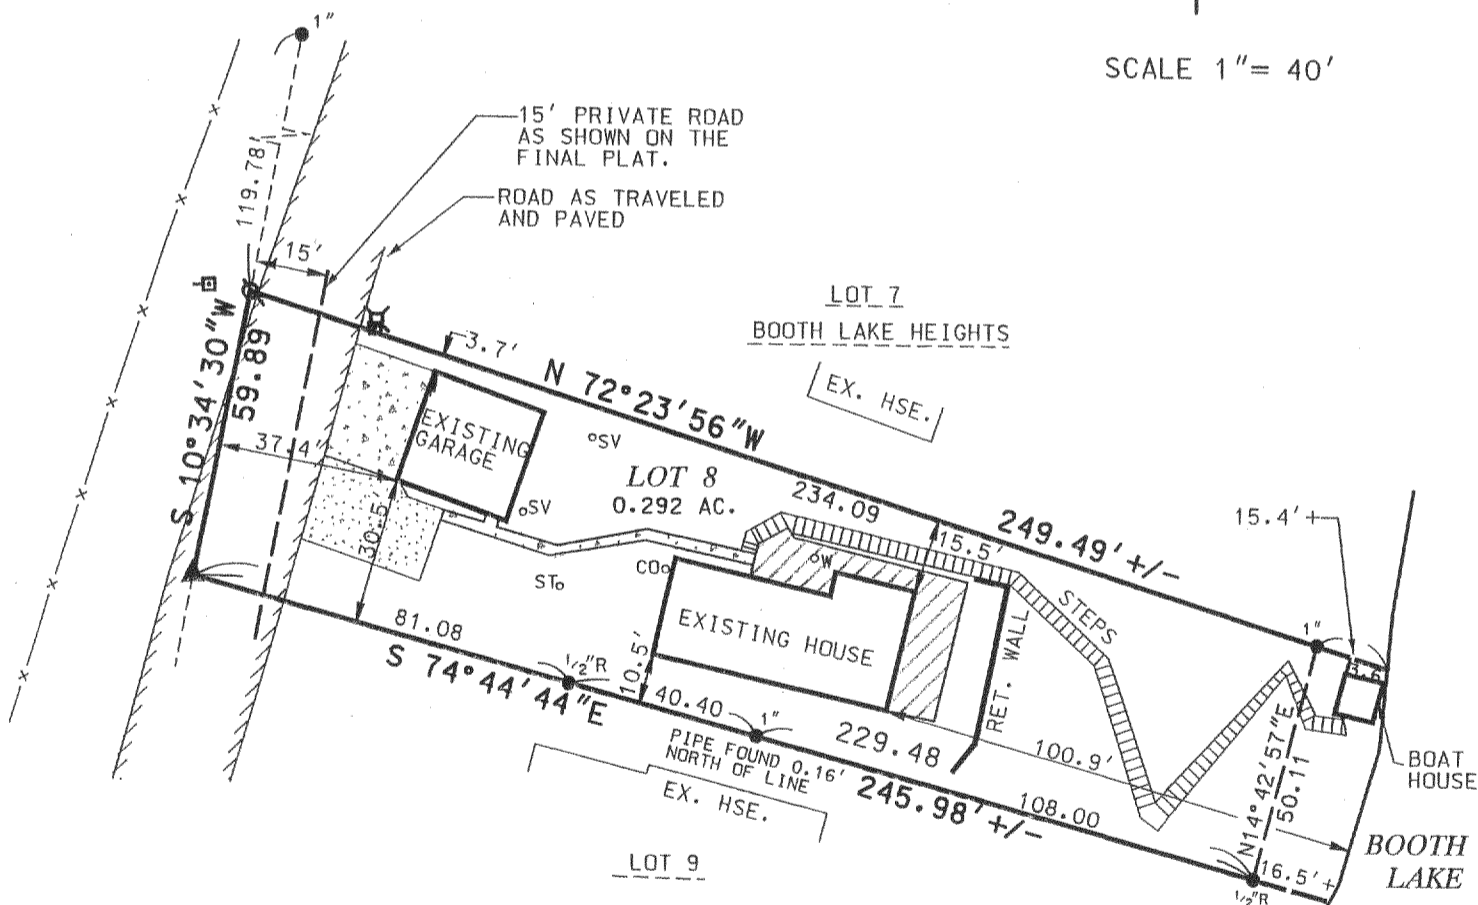


THE ABOVE MAP IS A TRUE REPRESENTATION THEREOF AND  
SHOWS THE SIZE AND LOCATION OF ALL THE PROPERTY,  
EXTERIOR BOUNDARIES, THE LOCATION OF ALL VISIBLE  
BOUNDARY FENCES, APPARENT EASEMENTS, ROADWAYS  
AND VISIBLE ENCROACHMENTS, IF ANY.

THIS SURVEY IS MADE FOR THE USE OF THE PRESENT  
OWNERS OF THE PROPERTY, AND ALSO THOSE WHO  
PURCHASE, MORTGAGE OR GUARANTEE TITLE THERETO  
WITHIN ONE (1) YEAR FROM DATE HERETO.

BRADFORD L. SPENCER, R.L.S. 2069  
RSV#02031.DGN

THIS IS ORIGINAL  
PRINT ONLY IF  
SEAL IS IMPRINTED  
IN RED

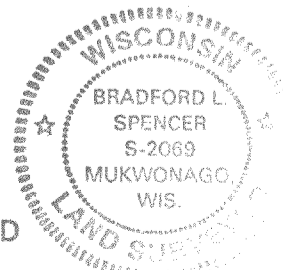

LBL-7

417-655