


PLAT OF SURVEY

LOT 2, THE ORCHARDS, BEING A PART OF THE NORTHWEST 1/4, SOUTHWEST 1/4 SOUTHEAST 1/4 AND NORTHEAST 1/4 OF THE NORTHWEST 1/4 OF SECTION 25, TOWN 4 NORTH, RANGE 17 EAST, TOWNSHIP 4 NORTH, RANGE 17 EAST, WISCONSIN.


SURVEYED FOR JOE AND JILL JAMES

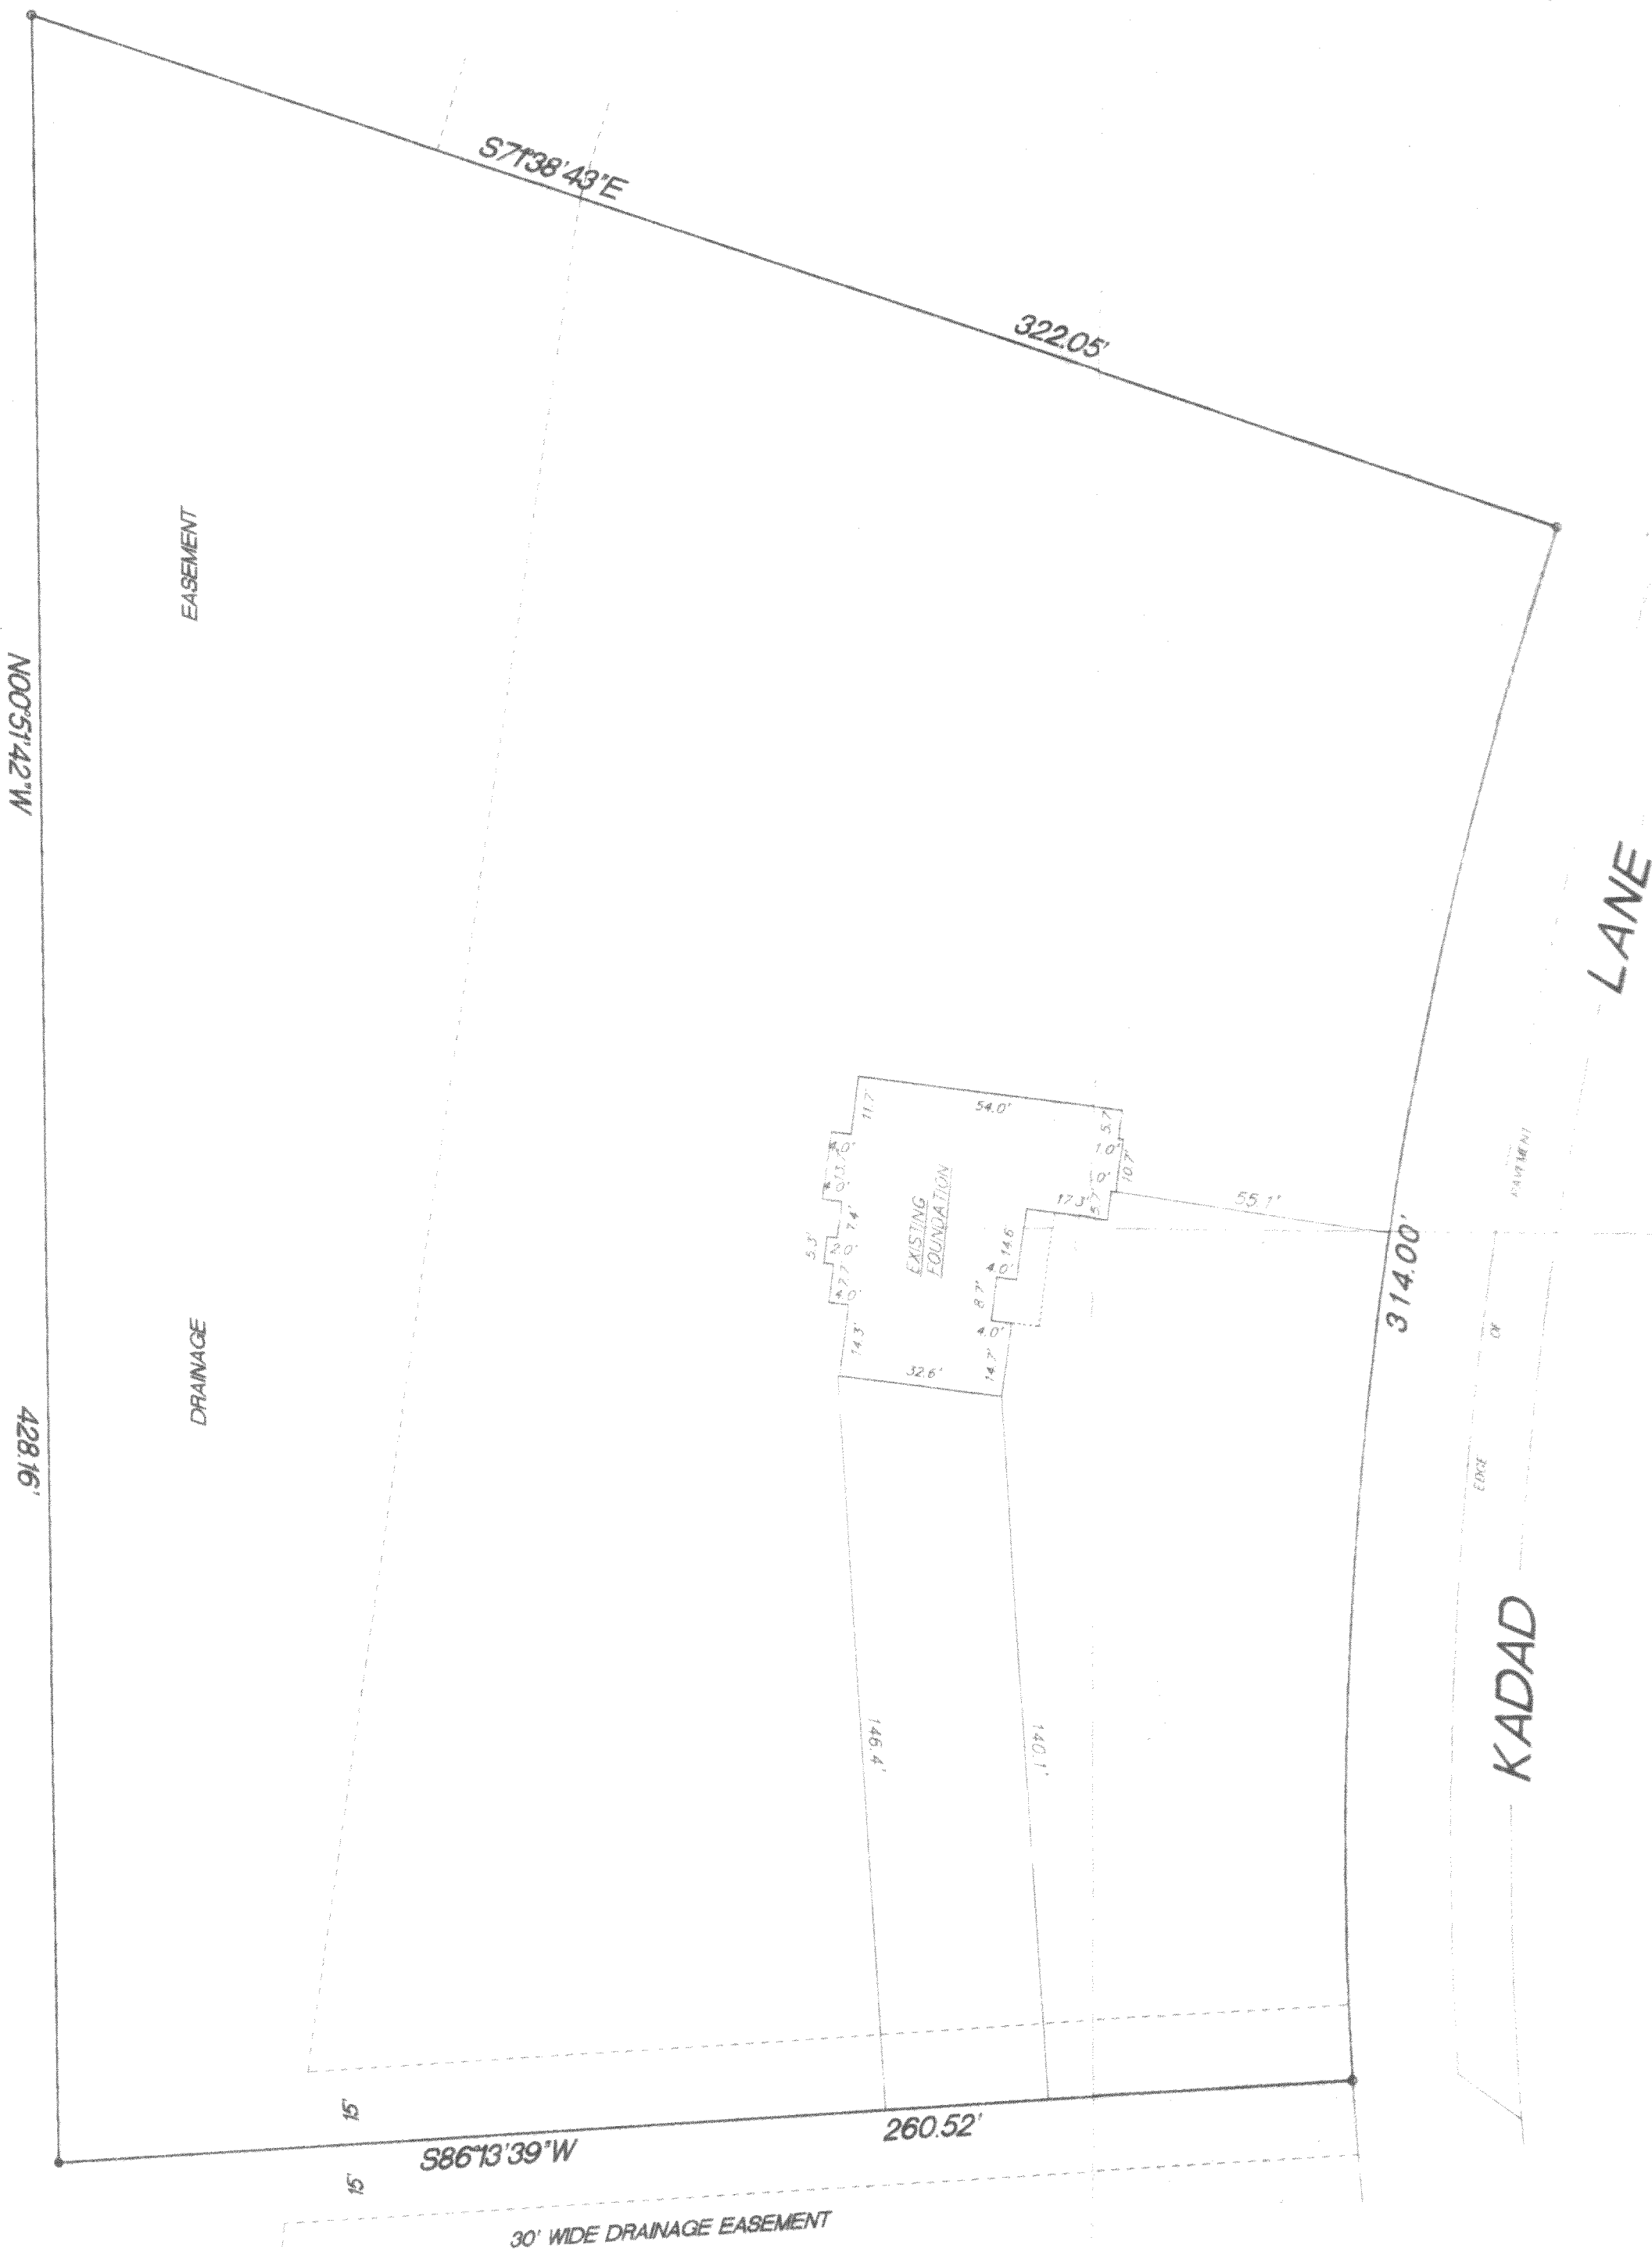

SCALE 1"=30'

- FOUND 1" IRON PIPE
- FOUND 2" IRON PIPE

RADIUS	LENGTH	CHORD	BEARING	DELTA
811.21'	314.00'	312.04'	S07°13'51"W	22°10'40"

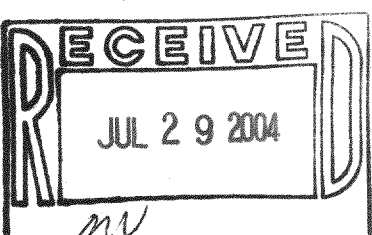

I hereby certify that I have surveyed the above property and the above map is a true representation thereof and show the size and location of the property exterior boundaries, the location of all visible structures and dimensions of all principal buildings thereon, boundary fences, apparent easements, roadways and encroachments if any.

This survey is made for the use of the present owners of the property, and also those who purchase, mortgage or guarantee the title thereto within one year from date hereof.

THIS IS NOT AN ORIGINAL SURVEY UNLESS THE SEAL IS RED.

Kettie Moraine Surveying Inc.
P.O. Box 357
Eagle WI 53119
(262) 594-3484

TERRANCE E. PISAREK
S-1930
EAGLE, WISCONSIN
LAND SURVEYOR

RE: 14/29/04
DATE 3/12/04

TEP/DW
FIELD WORK BY

TEP
DRAWN BY

04030
JOB NUMBER

LOR 00002

417-740