

PLAT OF SURVEY

ALL THAT PART OF LOTS 1 AND 2, OF AVO SUNSET PARK, according to the plat thereof on file and of record in the office of the Register of Deeds in and for the County of Walworth, lying South and East of the Road running through and across said Lots as said road is established on said plat, situated in the County of Walworth, State of Wisconsin.

Surveyed for: Carlene Klein



Survey address: N8568 Townline Road

- FOUND 1" IRON ROD
- ⊗ FOUND 3/4" IRON PIPE
- FOUND 1" IRON PIPE
- ⊙ FOUND 1 1/2" IRON PIPE
- ⊗ FOUND P.K. NAIL
- ⊗ FOUND 3/4" IRON ROD

( ) RECORDED AS DIMENSIONS

LOCATION AND WIDTH OF TOWNLINE ROAD WAS DEFINED FROM INFORMATION SHOWN ON A "BIACCI" SURVEY DATED SEPT. 3, 1979


ORIGINAL PLAT DOES NOT DIMENSION THE ROAD LOCATION OR WIDTH.

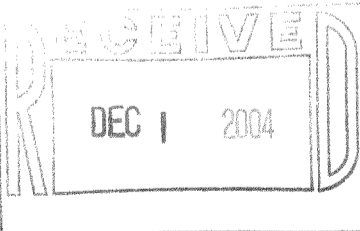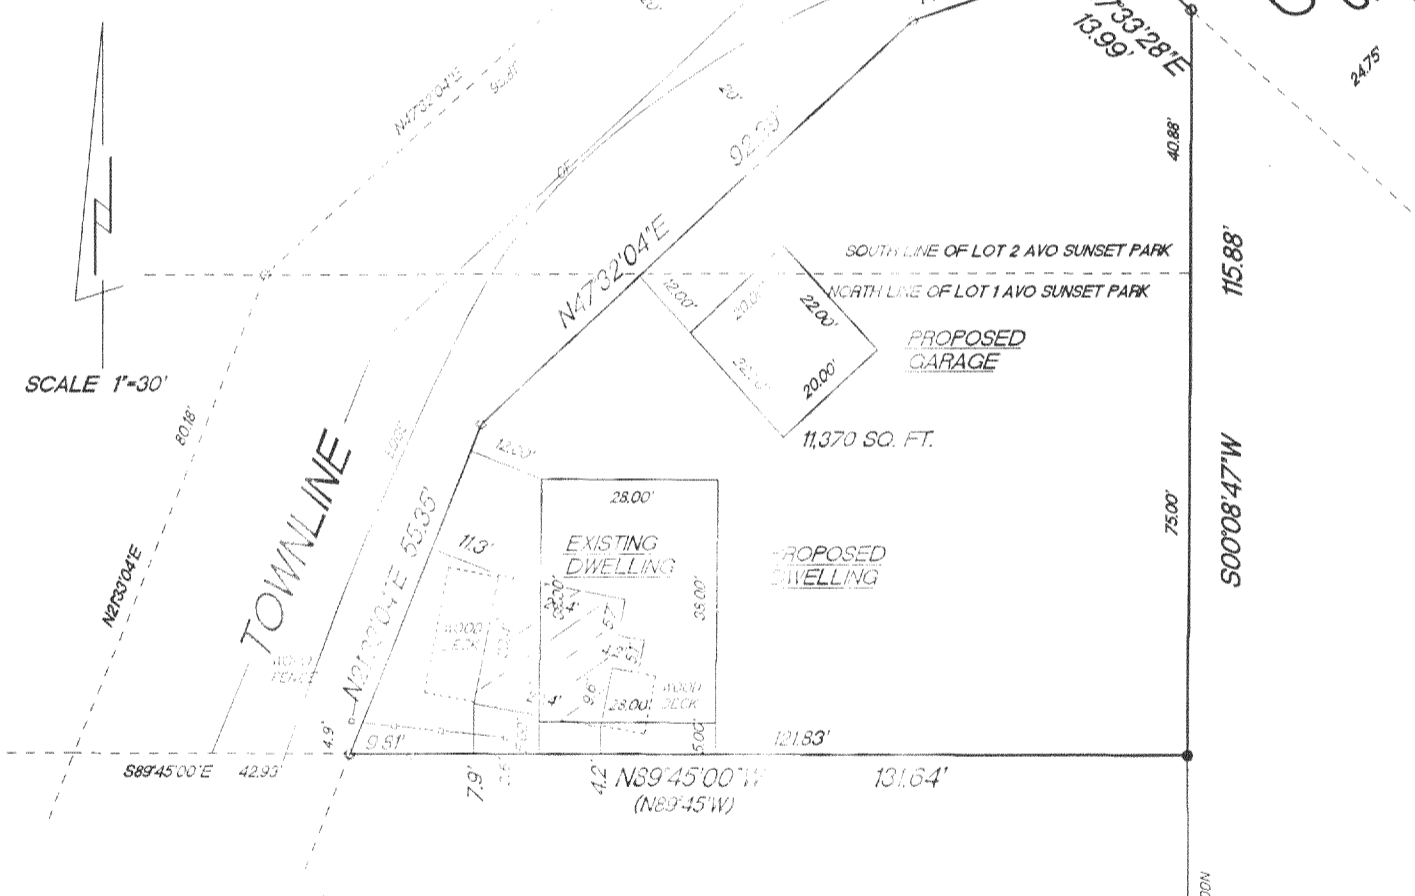

"I hereby certify that I have surveyed the above described property and that the above map is a true representation thereof and shows the size and location of the property, its exterior boundaries, the location of all visible structures and dimension of all principal buildings thereon, boundary lines, apparent easements, roadways and encroachments if any."

"This survey is made for the use of the present owners of the property, and also those who purchase, mortgage or guarantee the title thereto within one year from date hereof."

KITTLE MORaine SURVEYING INC.  
 W356 S9050 Godfrey Lane  
 Eagle Wisconsin 53119  
 P.O. Box 357  
 (262) 594-3484  
 Terrence E. Pisarek R.L.S.

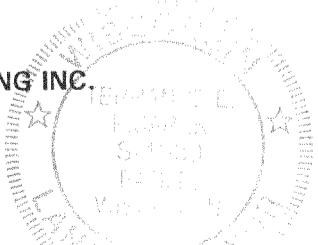

THIS IS NOT AN ORIGINAL SURVEY UNLESS THE SEAL IS RED.

10/1/04 DATE      TEP/SEP FIELD WORK BY      TEP DRAWN BY      04183 JOB NUMBER

LAS 00002

417-757