

N. 01° 06' 44" E.

682.57'

MUD  
LAKE

597.65'

620.68'

447.7'

LOT-1  
542,596 SQ. FT.  
12.456 AC.

S. 87° 28' 35" W.

558.9'

S. 29° 52' 04" W.

201.12'

S. 01° 13' 21" E.

N. 87° 28' 29" E.


N. 01° 13' 21" E.

1092.58'

1503.74'

ARC 122.72'  
S. 36° 33' 28" E.  
CHD. 122.00'

S.T.H. "20"  
66' R.O.W. ASPHALT SURFACE

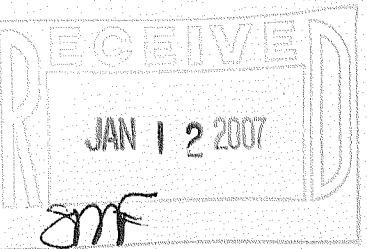

CALL DIGGERS HOTLINE  
1-800-242-8511  
TOLL FREE  
VIA STATUTE (UNLAWFUL)  
REQUIRES MIN. 3 WORK DAYS  
NOTICE BEFORE YOU EXCAVATE  
MILWAUKEE AREA 259-1181

"THE INFORMATION SHOWN ON THIS DRAWING CONCERNING TYPE AND LOCATION OF UNDERGROUND UTILITIES IS NOT GUARANTEED TO BE ACCURATE OR ALL INCLUSIVE. THE CONTRACTOR IS RESPONSIBLE FOR MAKING HIS OWN DETERMINATIONS AS TO THE TYPE AND LOCATION OF UNDERGROUND UTILITIES AS MAY BE NECESSARY TO AVOID DAMAGE THEREON."

NOTE: The location and size of the underground structures and utilities shown herein have been located to a reasonable degree of accuracy, but the Engineer and/or Surveyor does not guarantee their exact location or the location of others not shown.  
Contact Diggers Hotline, Inc., Etc.

PLAT OF SURVEY  
FOR: J ANTHONY HOMES RE: WASCHOW  
LOT-1 OF C.S.M.-3502  
TOWN OF TROY, WALWORTH COUNTY, WISCONSIN

**JAHNKE & JAHNKE ASSOCIATES INC.**  
PLANNERS & PROFESSIONAL ENGINEERS  
711 W. MORELAND BLVD.-WAUKESHA, WI 53188  
TEL No. (262) 542-5797 FAX (262) 542-7698

SCALE: 1"= 50'  
DRAWN BY: P.M.  
BOOK NO.: WAL-11 pg 62/63  
CHECKED BY: J.W.J.  
JOB: S/O  
DATE: JULY 26, 2006  
FILE NO.: WALWORTH-04  
SHEET OF

STATE OF WISCONSIN ) ss  
COUNTY OF WAUKESHA )  
We Jahnke & Jahnke Associates Inc. do hereby certify that we have made this survey and that the information as shown on the above Plat of Survey is a true and correct representation thereof.

*John W. Jahnke*  
JOHN W. JAHNKE - Wis. Reg. No. S-917  
REVISION DATE: 10-17-06 (BASEMENT SURVEY)

FILE NAME: S:\PROJECTS\IPOS\WARWORTH 94\DWG1.dwg

LA3502 - 1