

(N89°47'16"E 2647.03') State Plane
N89°58'09"E 2647.02'

West 1/4 Corner
Section 34-4-17
(N. 282,180.87)
(E. 2,406,836.98)

N89°58'09"E 431.19'
(East 411.95')

Center 1/4 Corner
Section 34-4-17
(N. 282,190.68)
(E. 2,409,483.86)

Plat of Survey

of

Lot 1 of Certified Survey Map No. 1681,

recorded in Vol. 8 of Certified Survey Maps of Walworth County
on Page 51 and located in the Southwest 1/4 of Section 34, Town
4 North, Range 17 East, Town of Troy, Walworth County, Wisconsin.


Surveyed for: **Shorewest Realtors**
1231 South Rochester Street * Suite 110
Mukwonago, Wisconsin. 53149

County Trunk Highway A (86' Wide)

(180.30°)
Arc=180.27'

Radius = 983.54', Chord = N74°40'45"E 180.02'
(N74°40'45"E 180.05')

Tax Parcel
LT 3400005

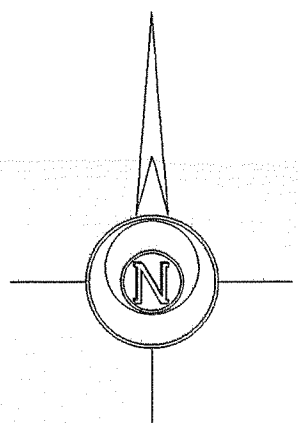

Bearings reference to Certified
Survey Map No. 1681.



Tax Parcel
LT 3400005

Lot 1

0.918 Acre
40,008 Sq.Ft.

S14°02'08"E 227.07'
(S14°00'00"E 227.15')

N14°01'45"W 223.00'
(N14°00'00"W 223.00')

Notes: 1) This survey plat is not
certified unless signed
and sealed in red ink.

2) This survey is subject to Wisconsin lien laws.
This Plat of Survey is the notice of intent
to file lien. Lien waiver required.

Copyright © 2007 by Jensen & Olson Land Surveying, LLC.

All rights reserved. No part of this survey plat may be reproduced
or transmitted in any form by any means - graphic, electronic, or
mechanical, including photocopying, tracing, or information storage
and retrieval systems - without permission in writing from Douglas
G. Olson, Jensen & Olson Land Surveying, LLC.

I hereby certify that I have surveyed the above described
property and the map hereon is correct to the best of my professional
knowledge and belief and shows the size and location of the property,
its exterior boundaries, the location and dimensions of all visible
structures thereon, boundary fences, apparent easements and roadways
and visible encroachments, if any.


This survey is made for the exclusive use of the present owners
of property, and also those who purchase, mortgage or guarantee title
thereto, within one year from the date hereof.

Douglas G. Olson
Wisconsin Registered Land Surveyor - 2093

Found Iron Rod
pounded down 1.4'
by owner is 0.31'
S19°47'41"W of new
rod set at corner
at ground level.

S75°58'32"W 180.00'
(S76°00'00"W 180.00')

Tax Parcel
LT 3400005

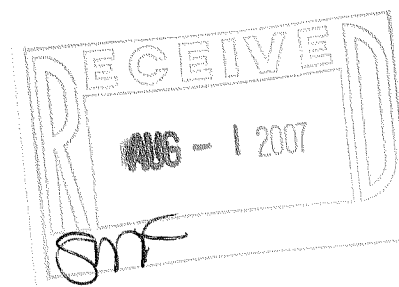

Sheet 1 of 1 Sheets

Job Reference Number

2007.049

Legend


- Found County Section Corner
- Found Iron Rod
- Set Iron Rod, 3/4" dia.
- Recorded Information
- Concrete or Plastic Cover
- Septic Vent
- Asphalt Surface
- Concrete Surface
- Gravel



Jensen & Olson Land Surveying, LLC

45 South Wisconsin Street P.O. Box 322
Elkhorn, Wisconsin. 53121
Telephone (262) 723-3434
Facsimile (262) 723-8044

Scale in Feet
1" = 20'

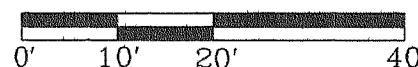

Survey Date: April 30, 2007.
Revisions:

2007.059

LA1681-1

417-843