

LOT 2 OF CERTIFIED SURVEY MAP NO. 3854, RECORDED IN
VOLUME 23 OF CERTIFIED SURVEY MAPS OF WALWORTH COUNTY
ON PAGE 215 AND LOCATED IN THE NORTHWEST 1/4 OF THE
NORTHEAST 1/4 OF SECTION 24 TOWN 4 NORTH, RANGE 17
EAST, TOWN OF TROY, WALWORTH COUNTY, WISCONSIN.


SCALE: 1" = 40'

- ☐ FOUND IRON PIPE
- ☒ FOUND IRON PIPE IN CONCRETE
- ☐ FOUND IRON ROD
- ☒ SET IRON PIPE




"I hereby certify that I have surveyed the above described property and that the above map is a correct representation thereof and shows the size and location of the property, its exterior boundaries, the location of all visible structures and dimensions of all principal buildings thereon, boundary fences, apparent easements, roadways and encroachments, if any."

"This survey is made for the use of the present owners of the property, and those who purchase, mortgage, or guarantee the title thereto within one year from date hereof."

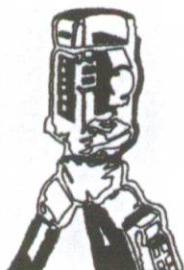

B.W. SURVEYING, INC.

LAND SURVEYS
MAPPING AND PLANNING
412 N. PINE STREET
BURLINGTON, WI 53105
(262)-767-0225

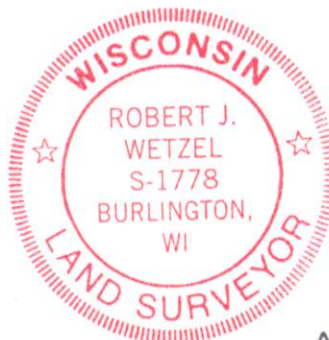

THIS IS NOT AN ORIGINAL PRINT
UNLESS THIS SEAL IS RED.

Robert J. Wetzel
ROBERT J. WETZEL S-1778

JUNE 11, 2009
DATE

8043
JOB NUMBER

LA3854-2

417-898