


HOLLAND & THOMAS, L.L.C. - LAND SURVEYORS

202 West Street Johnson Creek, WI 53038 (920) 699-3305

PLAT OF SURVEY


FOR LOTS 1, 2, 5, 6 AND THE NORTH 15 FEET OF LOT 9 AND LOT A (AS SHOWN ON THE RECORDED PLAT,) EXCEPTING FROM SUCH LOT A SO MUCH, IF ANY, AS MAY LIE WESTERLY FROM THE WEST LINE OF THE PRIVATE DRIVE AS PLATTED OR EXTENDED TO BOOTH LAKE, IN "FENLON'S SUBDIVISION", AND BEING A PART OF GOVERNMENT LOT 2 OF SECTION 24, TOWN 4 NORTH, RANGE 17 EAST, TOWN OF TROY, WALWORTH COUNTY, WISCONSIN.

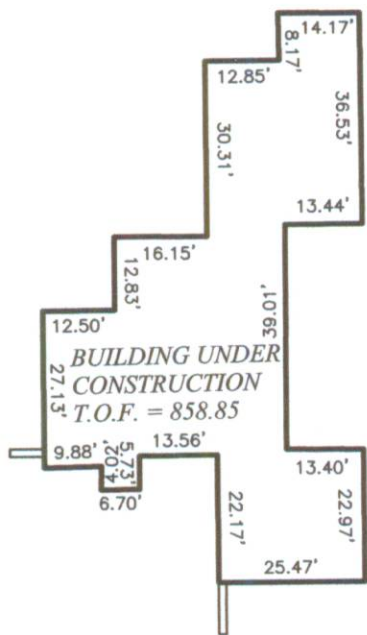

BOOTH


LAKE

DETAIL

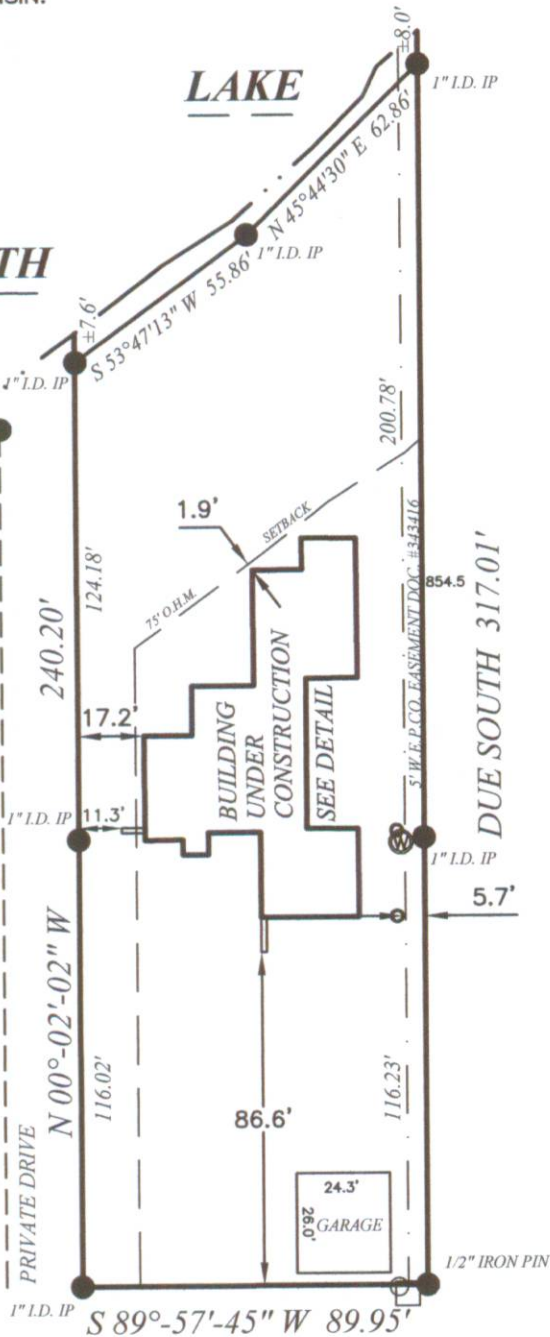

IF THE SURVEYOR'S SEAL IS NOT RED, THE PLAN IS A COPY THAT SHOULD BE ASSUMED TO CONTAIN UNAUTHORIZED ALTERATIONS. THE CERTIFICATION CONTAINED ON THIS DOCUMENT DOES NOT APPLY TO COPIES UNLESS THEY TOO HAVE A RED STAMP OVER THE PHOTOCOPIED STAMP BY SAME SURVEYOR.

BEARINGS ARE REFERENCED TO THE EAST LINE OF THE NORTHWEST QUARTER OF SECTION 14-07-17, WHICH IS ASSUMED TO BEAR N 00°-04'-28" W.

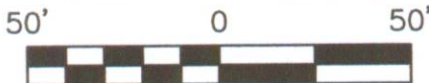

State of Wisconsin }
County of Jefferson } SS.

We, Holland & Thomas, L.L.C., do hereby certify that we have made this survey and that the information as shown on the above Plat of Survey is a true and correct representation thereof. Lots are drawn from subdivision plats/C.S.M.s; unplatted lands from recorded deeds/surveys. Boundary survey plats reflect field-located information; consult a title attorney to discover all the legal encumbrances attached to any property.


LEGEND: These standard symbols may be found in the drawing.

- | | |
|------------------------------|-------------------------------------|
| ● Lot Corner (Found) w/desc. | — — — — — Setback Line |
| □ Elec. Trans. Box | — . — — — Easement Boundary |
| ⊕ Man Hole | — . . . — — Ordinary Highwater Mark |
| ⊙ Well | |
| ○ Utility Pedestal | |

OWNER: FELSKE

BUILDER: HOME SPECIALISTS, INC.
MUKWONAGO, WI 53149
CELL: (414) 745-4534
PH: (262) 363-0910
FAX: (262) 363-0826

LHF-1

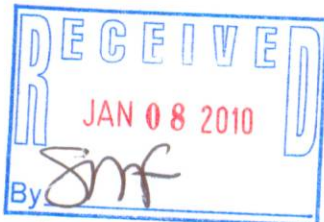

417-899