


PLAT OF SURVEY

LOTS 19, 20, 21 AND 22, BLOCK 12, FOUR LAKES BEACH, being a part of the Southwest 1/4 of Section 8, Town 4 North, Range 17 East, Town of Troy, Walworth County, Wisconsin.

Surveyed for: Katherine Vanacker

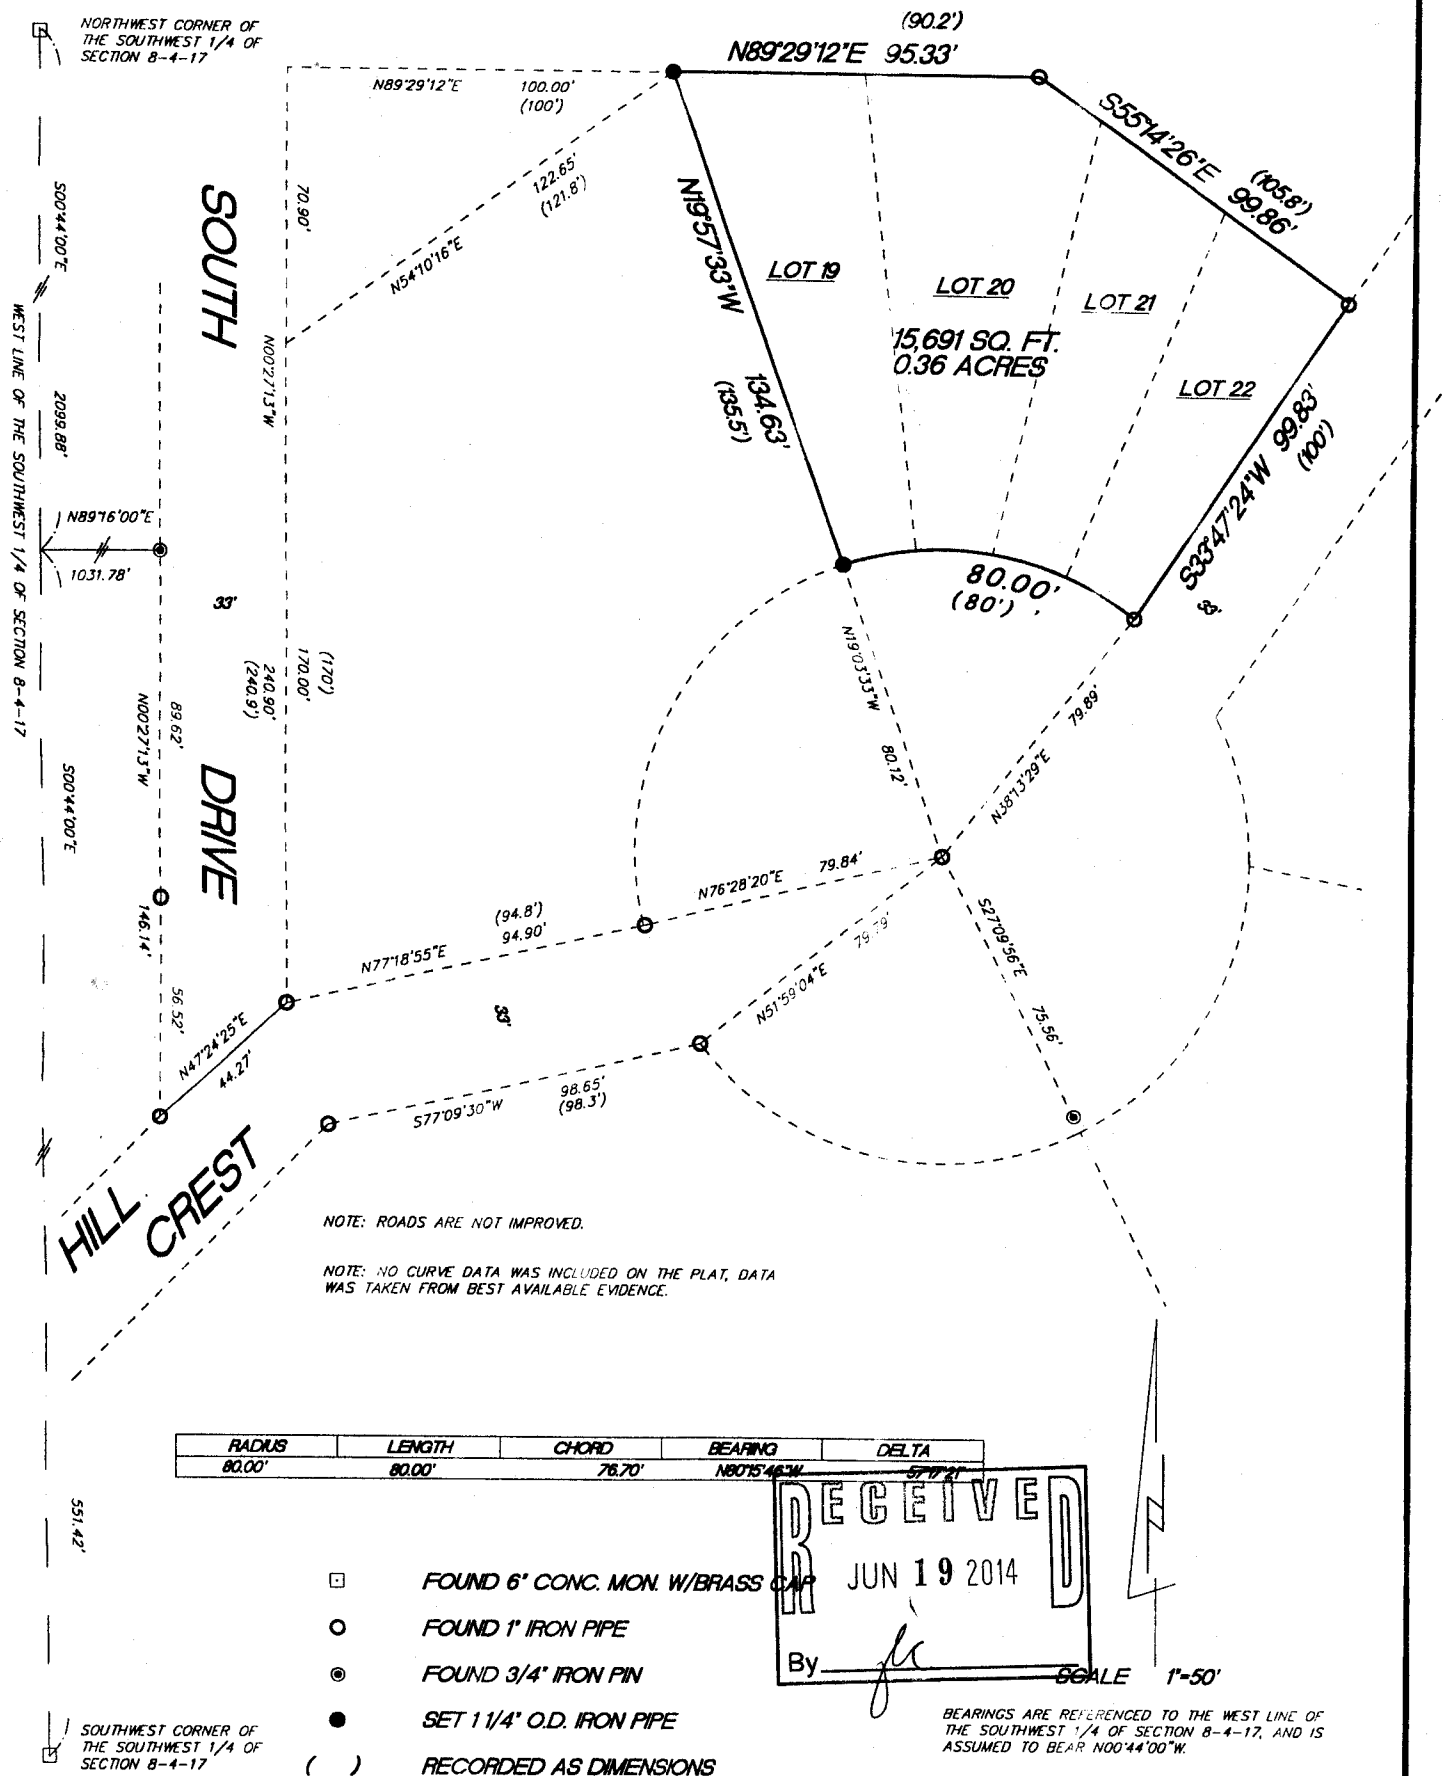

"I hereby certify that I have surveyed the above described property and that the above map is a true representation thereof and shows the size and location of the property, its exterior boundaries, the location of all visible structures and dimensions of all principal buildings thereon, boundary fences, apparent easements, roadways and encroachments if any"

"This survey is made for the use of the present owners of the property, and also those who purchase, mortgage or guarantee the title thereto within one year from date hereof."

KETTLE MORaine SURVEYING INC. WISCONSIN
S75 W36245 Wilton Road
Eagle Wisconsin 53119
P.O. Box 357
(262) 594-3484
kettlemorainesurvey.com
Terrance E. Pisarek R.L.S.



THIS IS NOT AN ORIGINAL SURVEY UNLESS THE SEAL IS RED.

4/24/14

TEP

TEP

14023

DATE

FIELD WORK BY

DRAWN BY

JOB NUMBER

LFL-9

417-970