

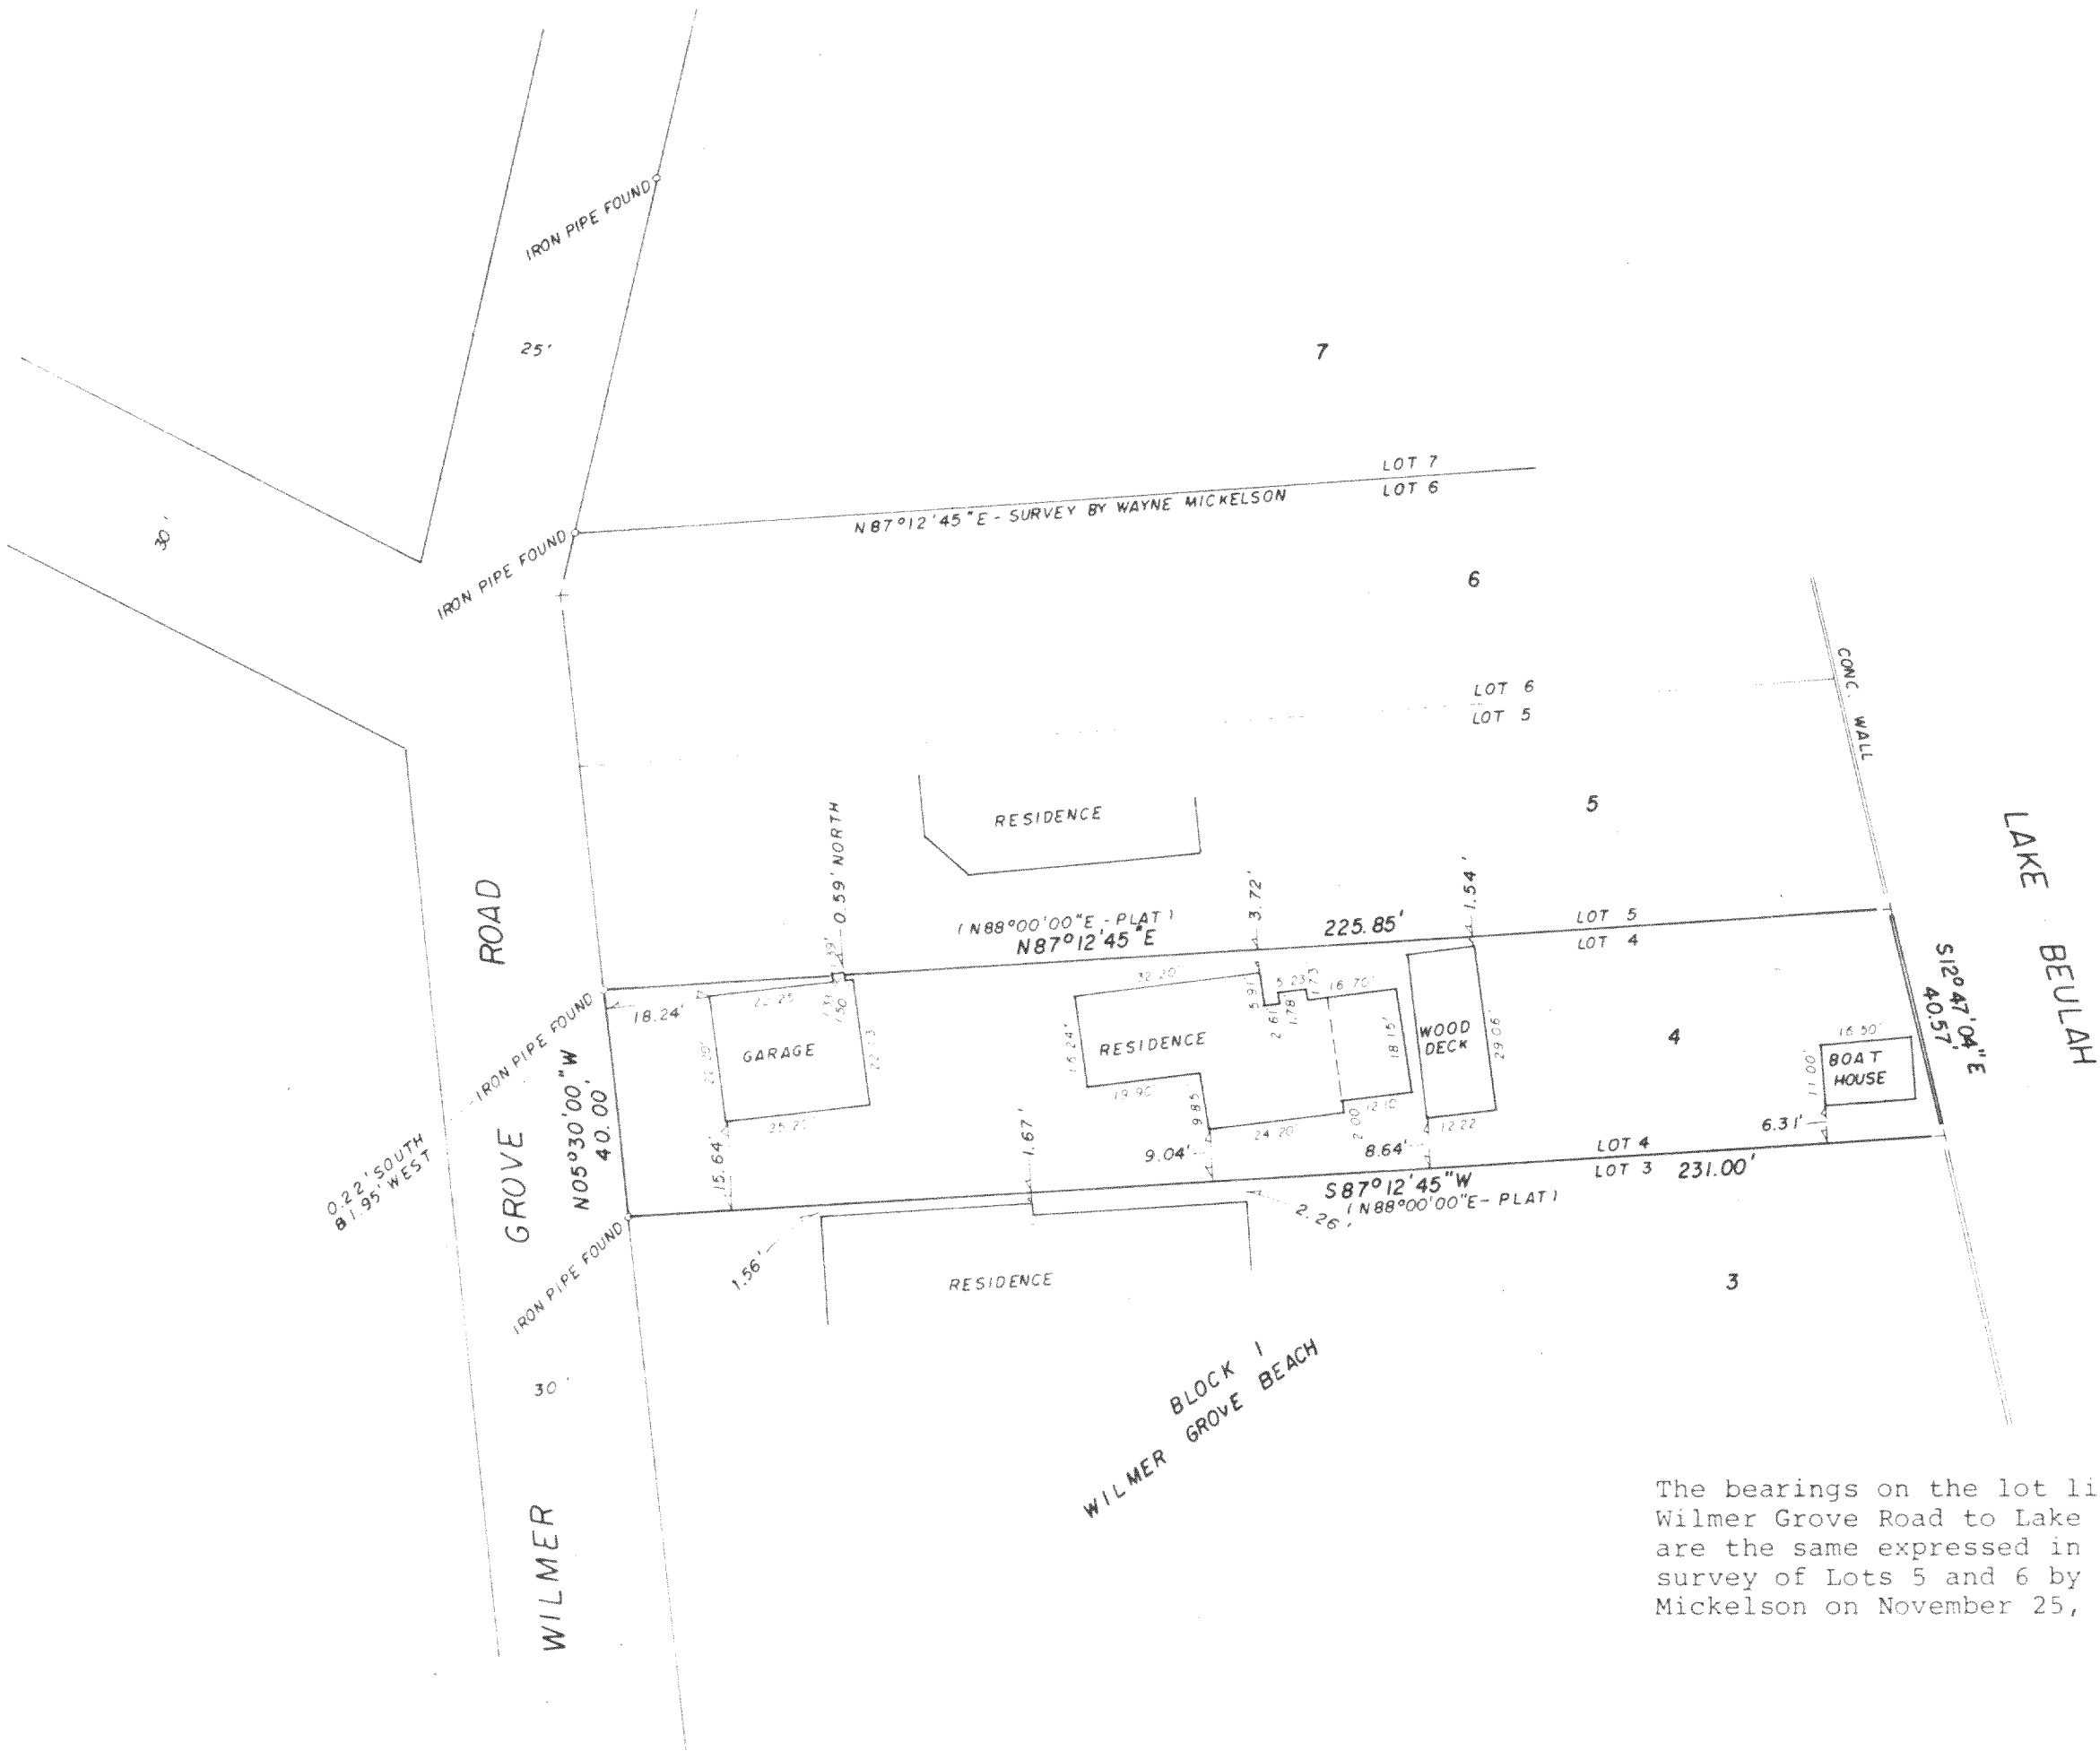


Lot 4, Block 1, Wilmer Grove Beach, being a part of the East one-half of Section 18, Town 4 North, Range 18 East, in the Town of East Troy, Walworth County Wisconsin.

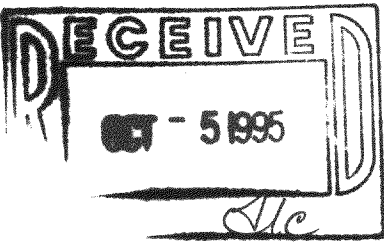


The bearings on the lot lines from Wilmer Grove Road to Lake Beulah are the same expressed in the survey of Lots 5 and 6 by Wayne Mickelson on November 25, 1992.

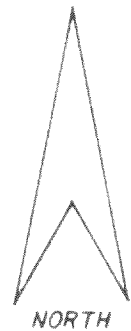

CERTIFICATION

"I have surveyed the above described property and the above map is a true representation thereof, and shows the size and location of the property, its exterior boundaries, the location and dimensions of all structures thereon, fences, apparent easements and roadways and visible encroachments, if any. This survey is made for the exclusive use of the present owners of the property, and also those who purchase, mortgage or guarantee the title thereto, within one (1) year from date hereof; and as to them I hereby certify that said survey and the above map were made in accordance with acceptable professional standards and that the information contained thereon is, to the best of my knowledge, information and belief a true and accurate representation thereof".

Dated this 28th day of September, 1995 *Claude C. Johnson, Jr.*
Registered Land Surveyor

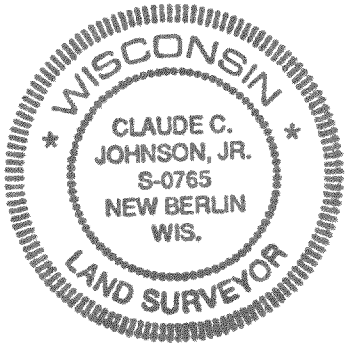

PLAT OF SURVEY
FOR
GARY KUMMER

PART OF E 1/2 OF SECTION 18 T. 4 N. R. 18 E.
TOWN OF EAST TROY, WALWORTH CO. WIS

PHONE: 414-542-8844 FAX: 414-542-3384
Suburban Surveys & Engineering, Inc. 1407 E. SUNSET DRIVE SUITE 100 WAUKESHA, WI 53186

SCALE 1"=30' DRAFTED BY GREG L. BARLOW DATE 09/27/94 PROJECT NO 95-180

418-1071
PWW-4