



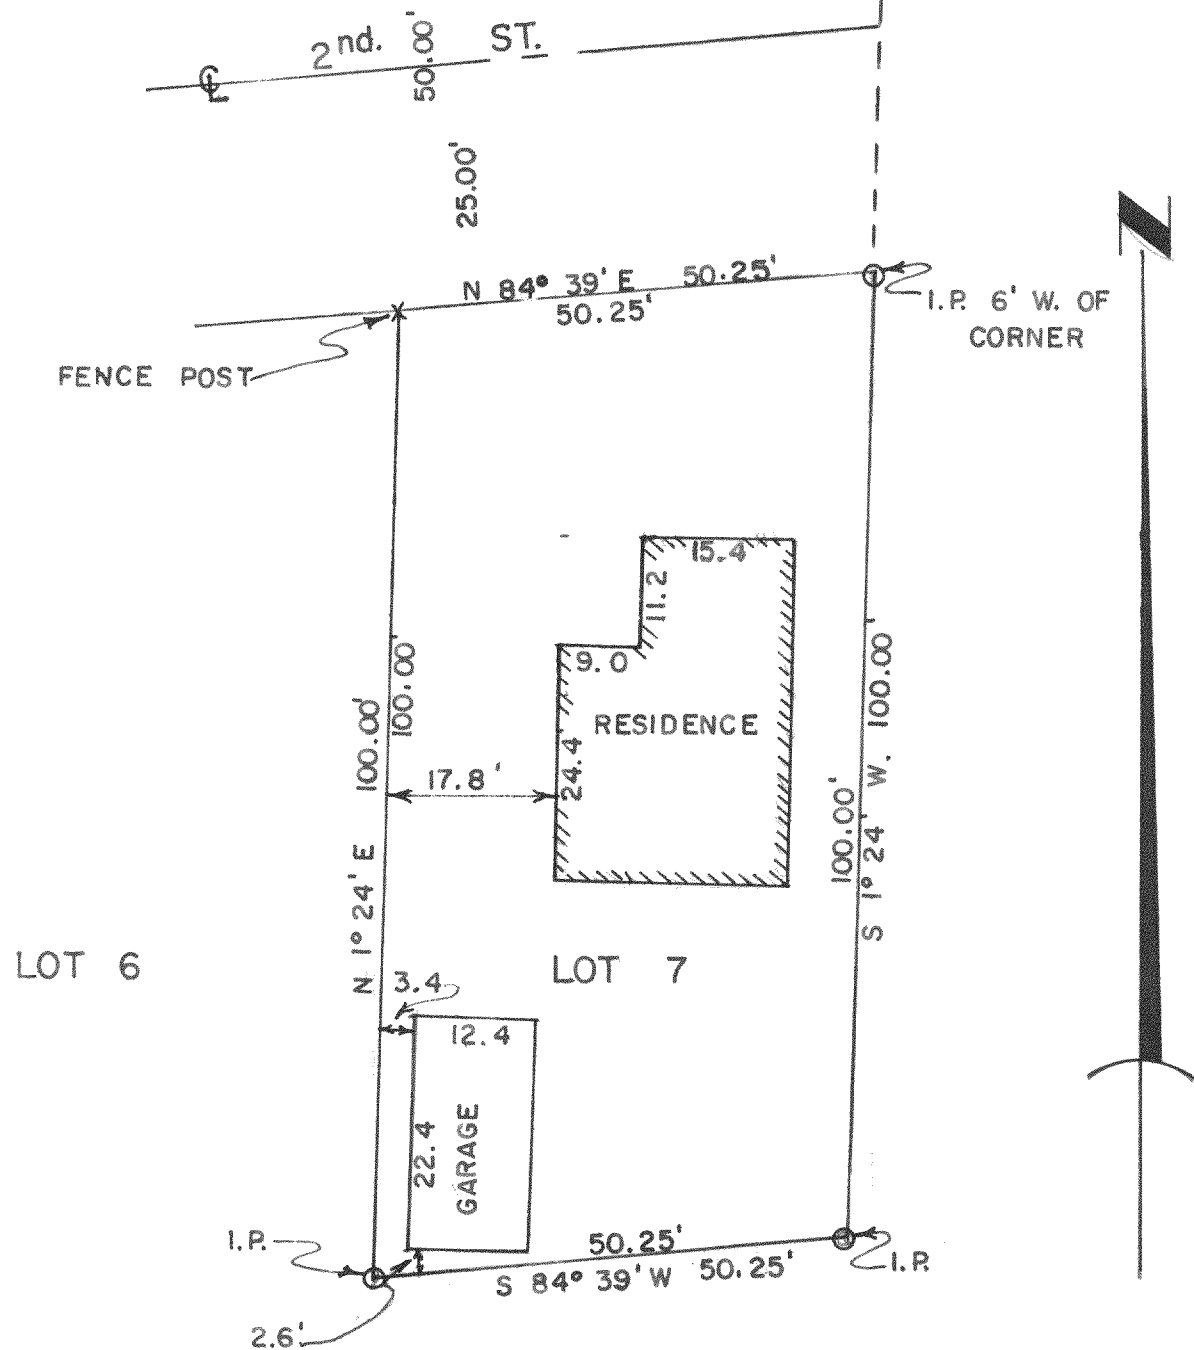

DESCRIPTION: Lot 7 of Hart's Beulah View Subdivision located in the NE $\frac{1}{4}$ of Section 9, T. 4 N., R. 18 E., Walworth County, Wisconsin

CERTIFICATE: I, James F. Biagi hereby certify that I have surveyed the above mentioned property and that the hereon portrayed is an accurate survey and a true representation thereof and correctly shows the exterior boundary lines and the location of the buildings and other improvements thereof.

Dated: Oct. 10, 1966

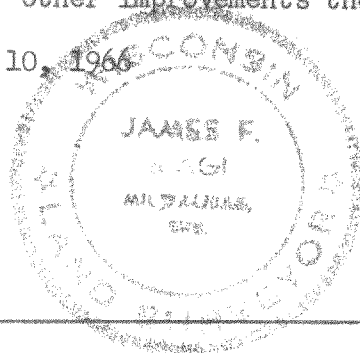

James F. Biagi R.L.S. #272
Elkhorn, Wis.