


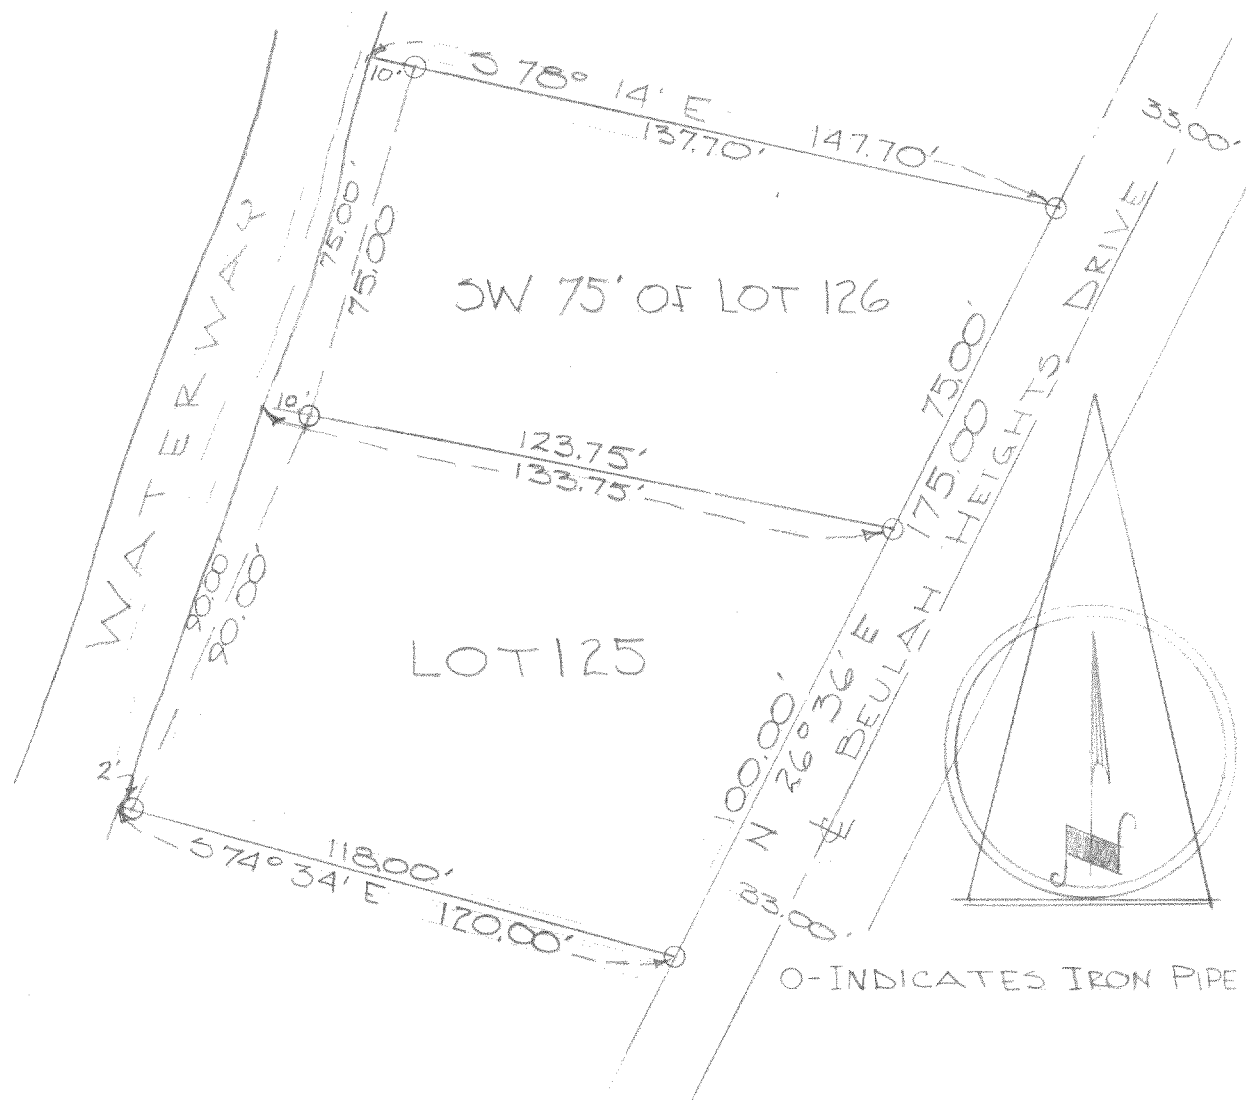

DESCRIPTION: Lot 125 and the Southwesterly 75.00 feet of Lot 126 of Beulah Heights Subdivision located in Section 8 Town 4 North, Range 18 East, Walworth County, Wisconsin.

CERTIFICATE: I, James F. Biagi, surveyor, do hereby certify that I have surveyed the property hereon described.

September 3, 1963.

James F. Biagi
James F. Biagi RLS 272

