

Plat of Survey



Survey For: Karen Wanta

Location: W870 Shorewood Drive

Being a retracement survey of:

Description: LOT 20 in SHOREWOOD, being a subdivision of the S.E. 1/4 of Section 10, the S.W. 1/4 of Section 11, the N.W. 1/4 of Section 14, and the N.E. 1/4 of Section 15, all in Township 4 North, Range 18 East, in the Town of East Troy, Walworth County, Wisconsin.

POTTERS LAKE

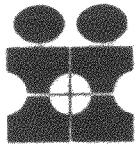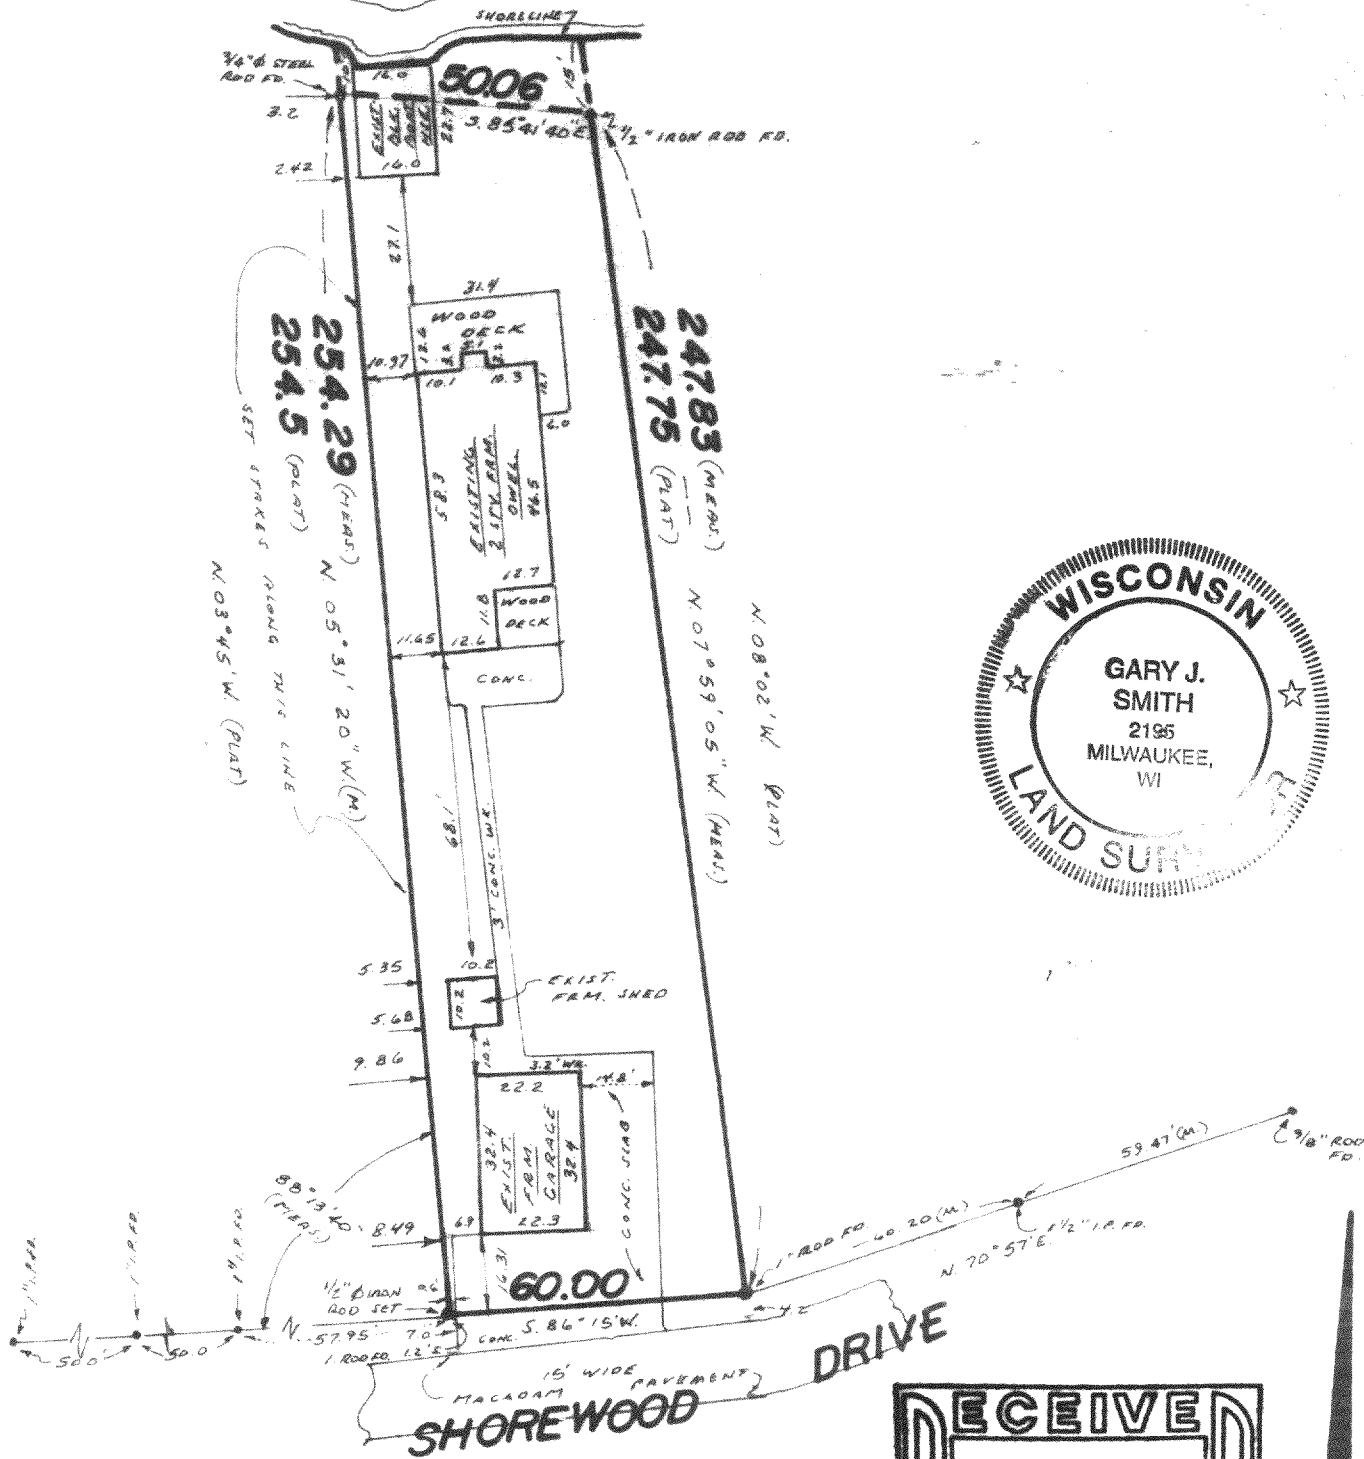

**INTERLINE SURVEY
SERVICES, INC.**
11221 W. FOREST HOME AVE
HALES CORNERS, WISCONSIN 53130
PHONE 425-2060

SURVEY CERTIFICATE

Scale: 1" = 40'

State of Wisconsin) ss
Milwaukee County

We, Interline Survey Services, Inc., certify that we have surveyed the above described property and the above map is a true representation thereof, and shows the size and location of the property, its exterior boundaries, the location and dimensions of all visible structures thereon, fences, apparent easements and roadways and visible encroachments, if any.

This survey is made for the exclusive use of the present owners of the Property, and also those who purchase, mortgage, or guarantee the title thereto, within one (1) year from date hereof.

Wisconsin Registered Land Surveyor

Date: 8/26/96
Job No.: 124815