PLAT OF SURVEY




DESCRIPTION:

LOT 28 OF DAKWOOD PARK, BEING A SUBDIVISION OF PART
OF GOVERNMENT LOT 2 LOCATED IN THE NE' 4 OF SECTION 8,
TOWN 4 NORTH, RANGE 18 EAST, TOWN OF EAST TROY, WALWORTH
COUNTY, WISCONSIN, BEING MORE COMPLETELY DESCRIBED AS
FOLLOWS: BEGINNING AT THE NORTHWEST CORNER OF SAID LOT 28;
THENCE S49°17′00″E ALONG NORTHERLY RIGHT-OF-WAY OF LAKE
DRIVE A DISTANCE OF 45.00′ TO A POINT; THENCE N61°05′54″E
170.40′ TO AN IRON PIPE MARKING THE MEANDER LINE; THENCE
CONTINUING ALONG SAME LINE N61°05′54″E A DISTANCE OF 5.6′
MORE OR LESS, TO THE SHORELINE OF LAKE BUELAH; THENCE
NORTHERLY, ALONG SAID SHORELINE TO A POINT BEING N61°05′54″E
OF AN IRON PIPE; THENCE S61°05′54″W, A DISTANCE OF 12.3′, MORE
OR LESS, TO SAID PIPE WHICH MARKS THE MEANDER LINE, BEING
N25°44′53″W, 42.25′ FROM PREVIOUS IRON PIPE; THENCE CONTINUING
ALONG SAME LINE S61°05′54″W, 188.40′ TO THE POINT OF BEGINNING.

SCALE: 1"= 30'

FOR: DAVE SCHMIDT REALTY

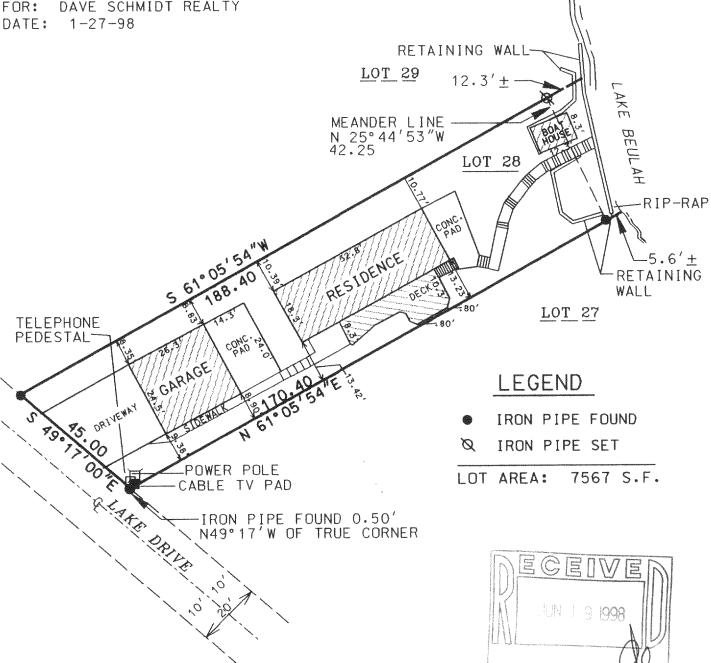

THE ABOVE MAP IS A TRUE REPRESENTATION THEREOF AND SHOWS THE SIZE AND LOCATION OF ALL THE PROPERTY, EXTERIOR BOUNDARIES, THE LOCATION OF ALL VISIBLE BOUNDARY FENCES, APPARENT EASEMENTS, ROADWAYS AND VISIBLE ENCROACHMENTS, IF ANY.

THIS SURVEY IS MADE FOR THE USE OF THE PRESENT
OWNERS OF THE PROPERTY, AND ALSO THOSE WHO
PURCHASE, MORTGAGE OR GUARANTEE TITLE THERETOTING IS ORIGINAL
WITHIN ONE (1) FAR FROM DATE HERETO.
SEAL IS IMPRINTED. SEAL IS IMPRINTED IN RED

BRADFORD L. SPENCER, R.L.S. 2069 RSV#98011 418-1205

