


NE CORNER OF BLK. 21
MIRAMAR ADD #1

LOT 10 BLK 21

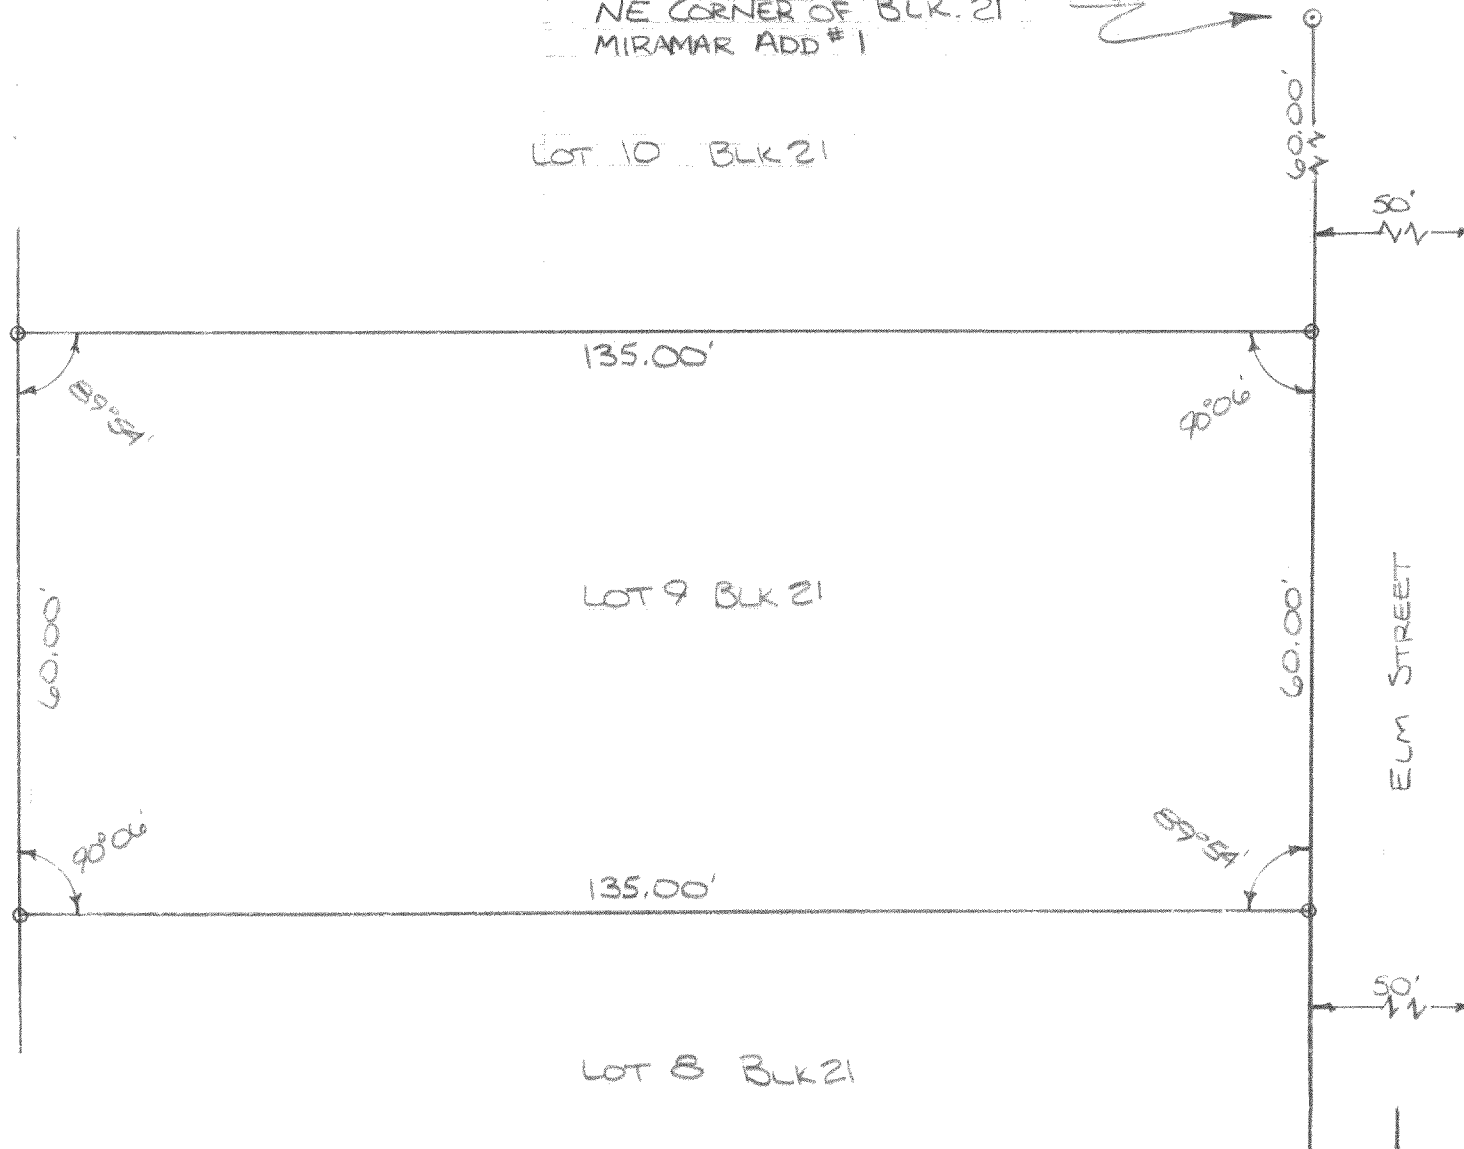

DESCRIPTION: Lot 9, Block 21, of Miramar Add. No. 1,
located in the NE $\frac{1}{4}$ of Section 10, East Troy Twp.,
Walworth County, Wisconsin.

CERTIFICATE: I, James F. Biagi, surveyor, do hereby certify that I have surveyed the lands hereon described.

DATE: May 22, 1972

James F. Biagi

R.L.S. 272



○-INDICATES IRON PIPE