


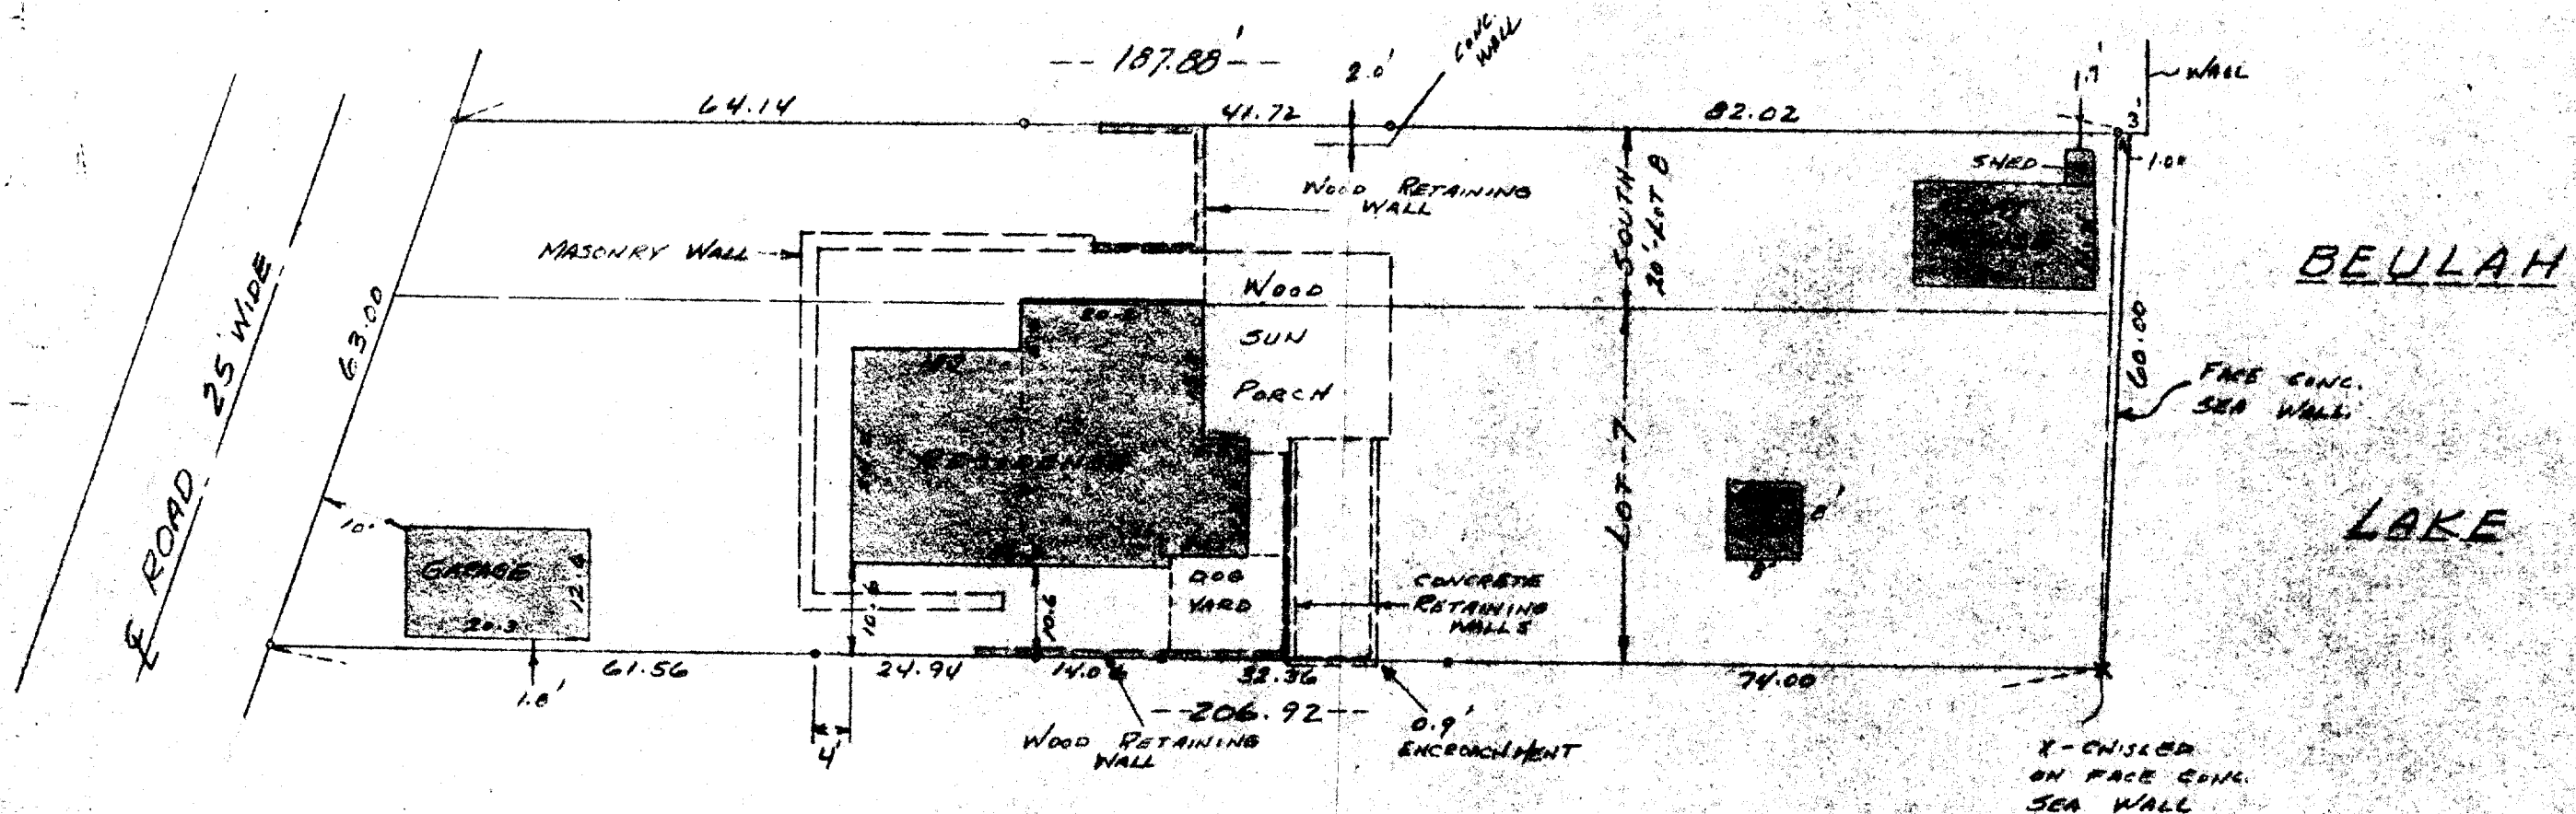

DESCRIPTION OF LAND

Lot 7 and the South 20 feet of Lot 8 in Block 1 in Wilmer Grove Beach lying and being in the East 1/2 of Section 18, Town 4 North, Range 18 East in the Town of East Troy in said County of Walworth.

I hereby certify that on the 9th day of June, 1967 that I have surveyed the above described property and that the plat is a correct representation of the exterior boundary lines thereof and the principal lines of the buildings thereon.

Date JUNE 9, 1967

Lloyd L. Jensen
Lloyd L. Jensen, Surveyor

LEGEND

○ - IRON STAKE



PLAT OF SURVEY OF

LOT 7 AND THE SOUTH 20 FEET
LOT 8 - BLOCK 1 - WILMER GROVE
BEACH SUBDIVISION E 1/2 SECTION 18,
T 4 N - R 18 E, WALWORTH COUNTY
WISCONSIN.

Lloyd L. Jensen

SCALE 1" = 20'

DATE JUNE 9, 1967

418-126 J