


RSV ENGINEERING, INC
ENGINEERS, PLANNERS, SURVEYORS
CONSTRUCTION MANAGERS,
ENVIRONMENTAL SCIENTISTS

801 MAIN STREET, MUKWONAGO, WISCONSIN 53149 (262) 363-2004



1" IP ● FOUND IRON ROD
1/2"R OR IRON PIPE
Ø 1"x24" IRON PIPE SET
A ○ ANTENNA
ST ○ SEPTIC TANK
SV ○ SEPTIC VENT
PK ▲ PK NAIL FOUND
() RECORDED AS
~~EDP~~ EDGE OF PAVEMENT

LOT 12 OF ISLAND CLUB,
LOCATED IN PART OF
SECTION 4, TOWN 4 NORTH,
RANGE 18 EAST, TOWN OF
EAST TROY, WALWORTH
COUNTY, WISCONSIN.

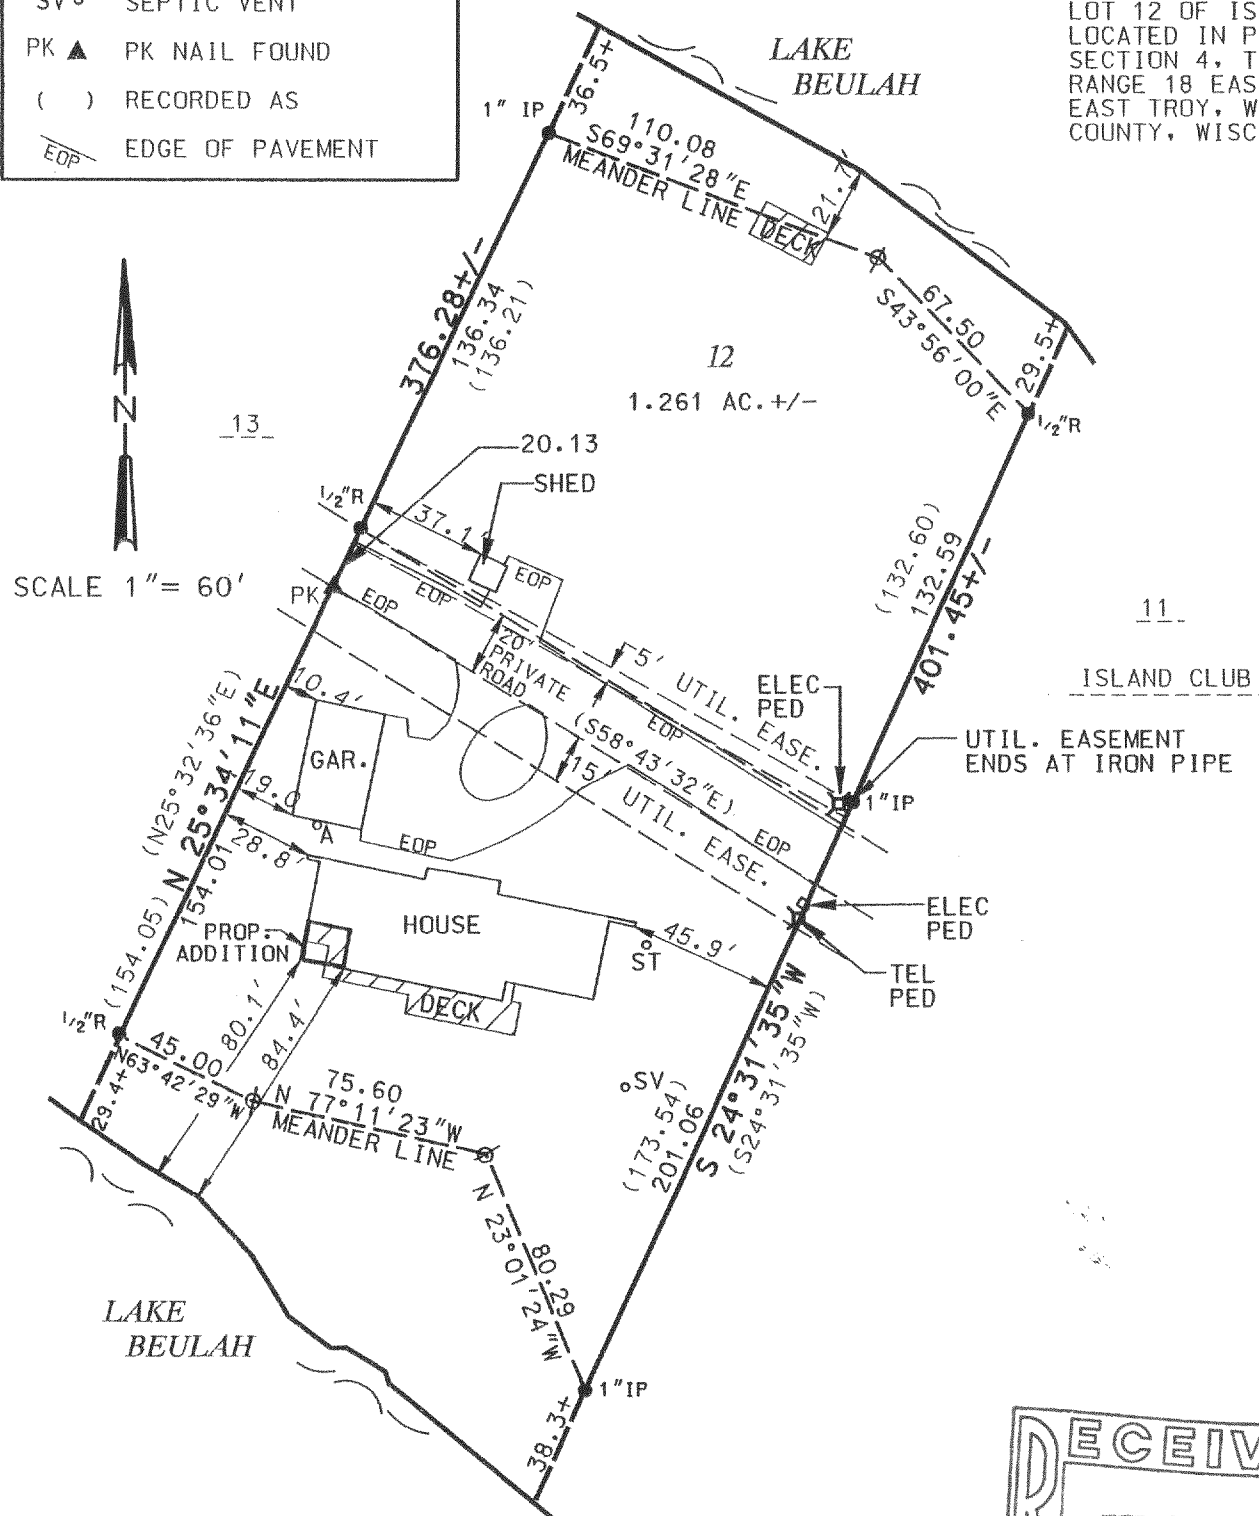

THIS IS ORIGINAL
PRINT ONLY IF
SEAL IS IMPRINTED
IN RED

BRADFORD L. SPENCER, R.L.S. 2069
RSV#00224

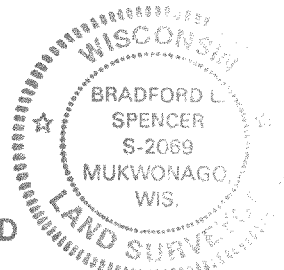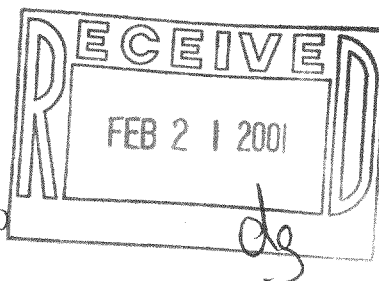

418-1441

PI-12