

PLAT OF SURVEY

ORDERED BY:


MILL VALLEY HOMES
P.O. BOX 114
EAST TROY, WI
53120

PATHFINDER SURVEYING
FORMERLY KOLB LAND CONSULTING
929 WILLIAMS STREET LAKE GENEVA, WI. 53147
(262)-248-3697

DATE: 6 / 09 / 2000
DATE OF LAST REVISION: 11 / 06 / 2000

DESCRIPTION

LOT 1 BLOCK 1 OF CLEARVIEW SUBDIVISION LOCATED IN SECTION
18 , TOWN 4 NORTH , RANGE 18 EAST , WALWORTH COUNTY, WISCONSIN

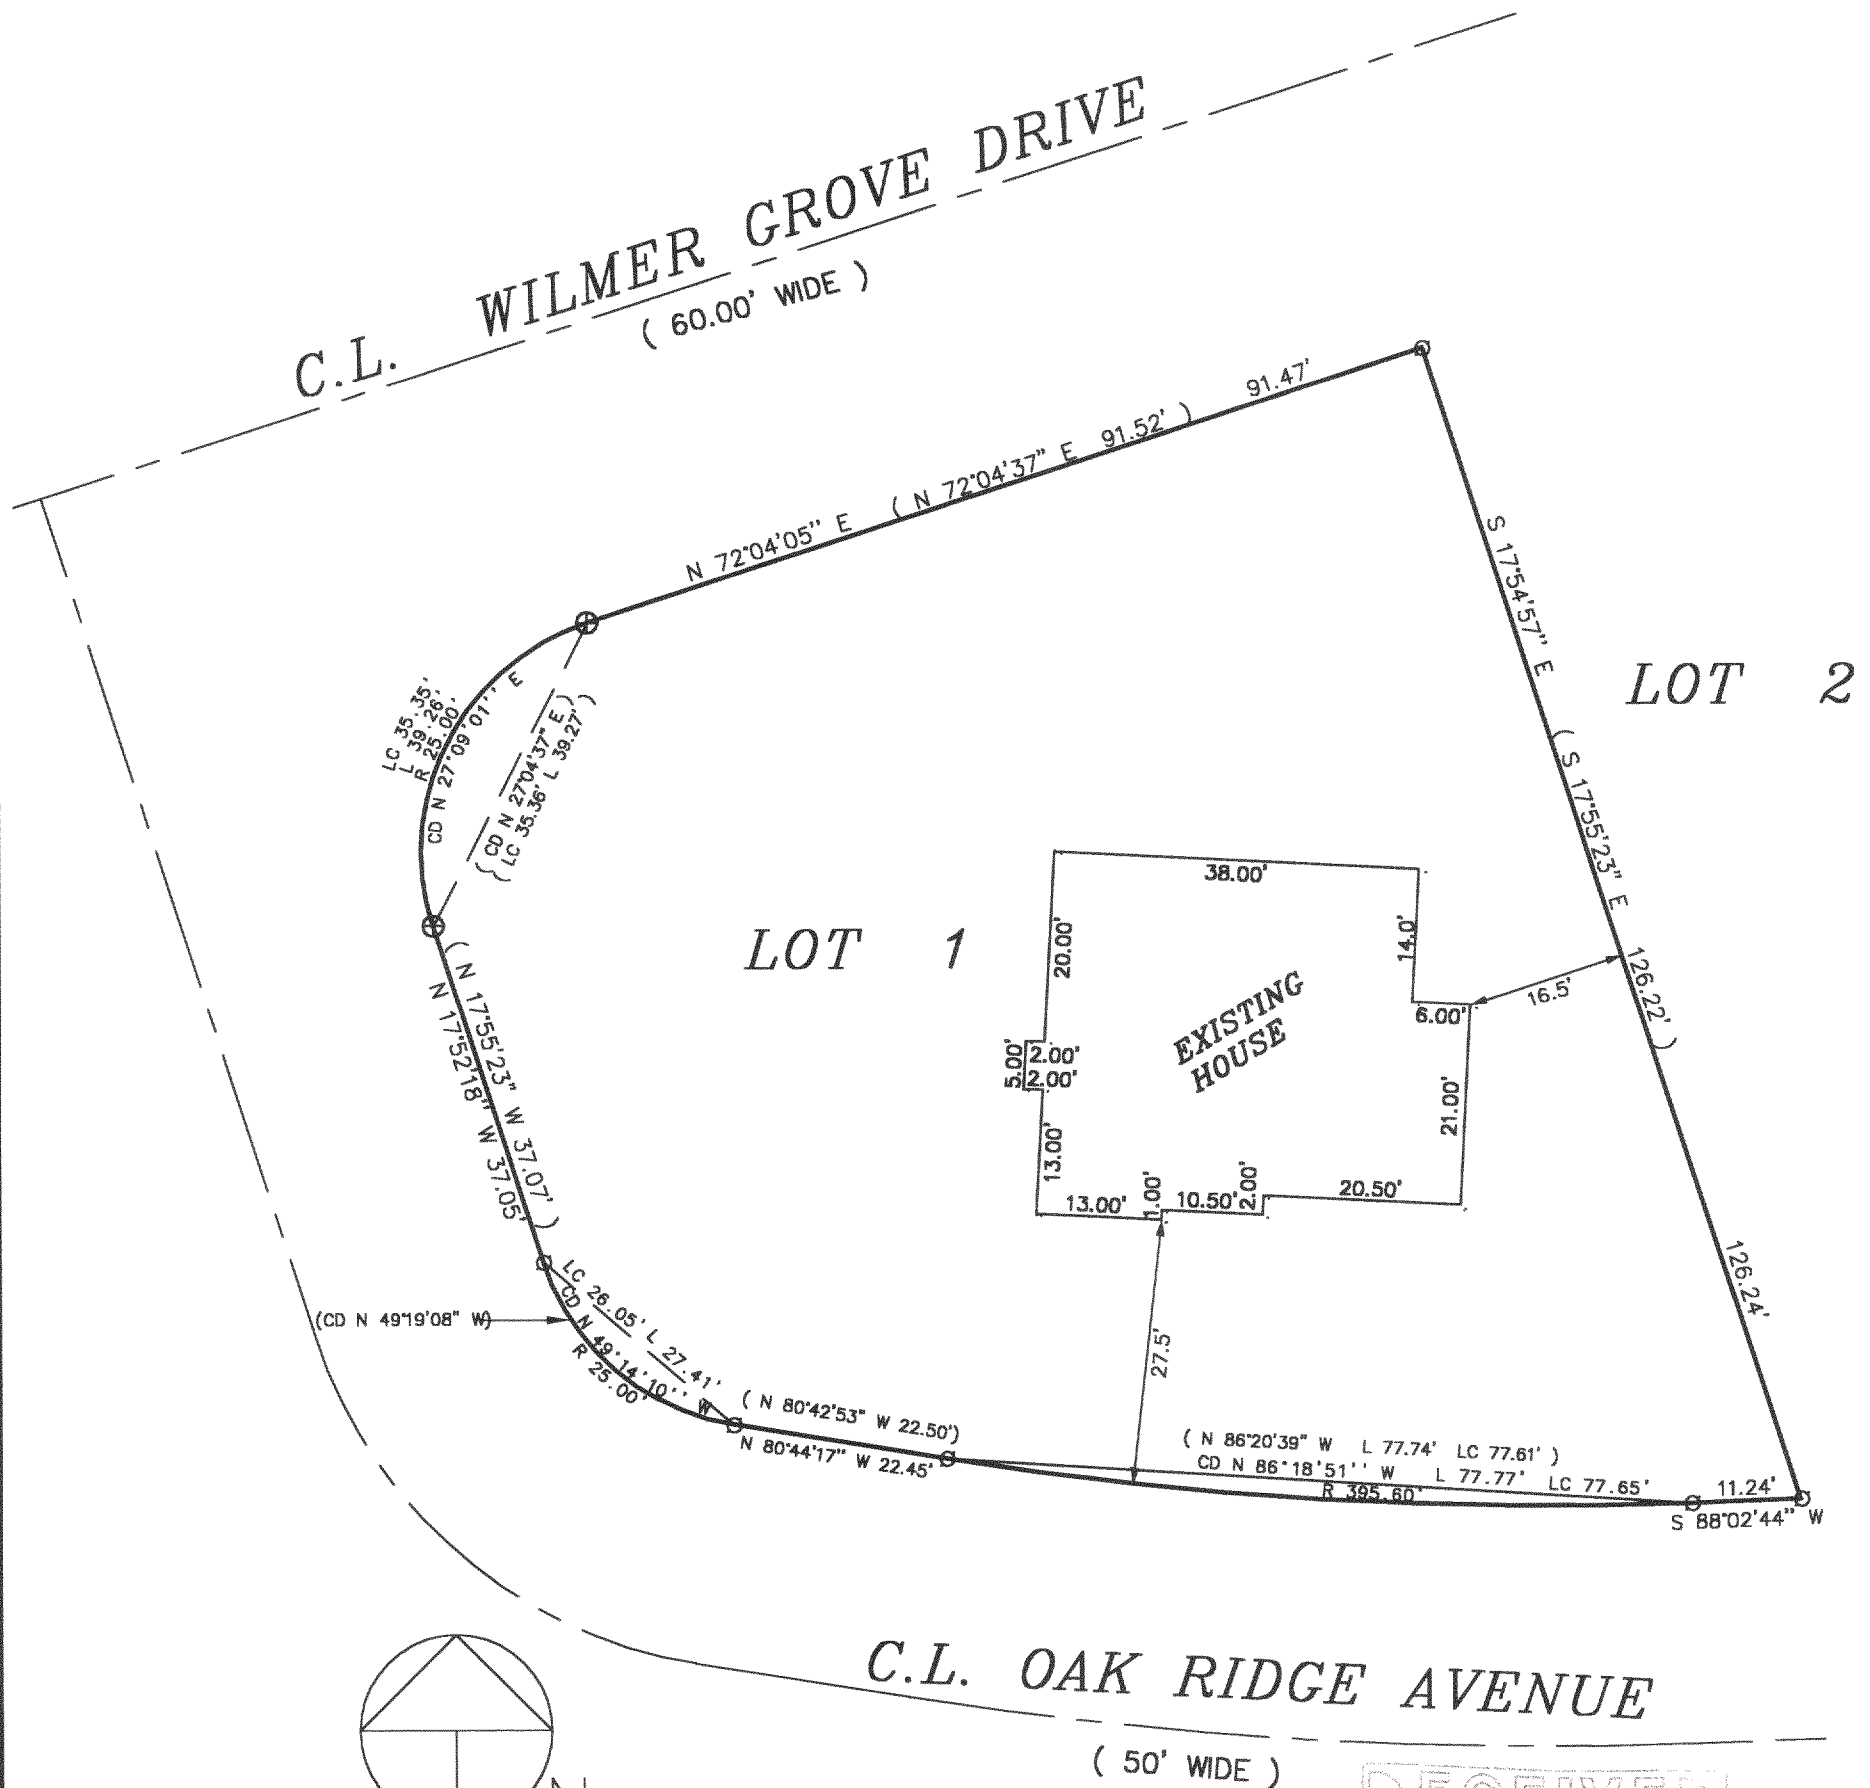


THE ABOVE MAP IS A TRUE REPRESENTATION THEREOF AND
SHOWS THE SIZE AND LOCATION OF ALL THE PROPERTY,
EXTERIOR BOUNDARIES, THE LOCATION OF ALL VISIBLE
BOUNDARY FENCES , APPARENT EASEMENTS , ROADWAYS
AND VISIBLE ENCROACHMENTS , IF ANY

THIS SURVEY IS MADE FOR THE USE OF THE PRESENT
OWNERS OF THE PROPERTY , AND ALSO THOSE WHO
PURCHASE , MORTGAGE OR GURANTEE TITLE THERETO
WITHIN ONE (1) YEAR FROM DATE HERETO.

○ FOUND IRON PIPE
⊕ FOUND 5" CONCRETE MONUMENT
(XXXX) RECORDED AS

LEGEND

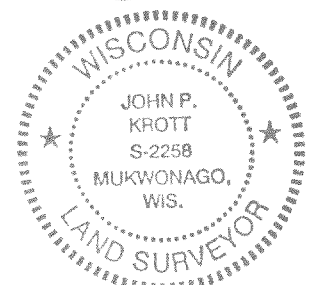

John P. Krott
JOHN P. KROTT , R.L.S. 2258

NOTE: THIS IS NOT A CERTIFIED COPY
UNLESS SEAL IS IN RED.
JOB NUMBER: 00110 4-18- PCV00001

PCV-1 418-1466