



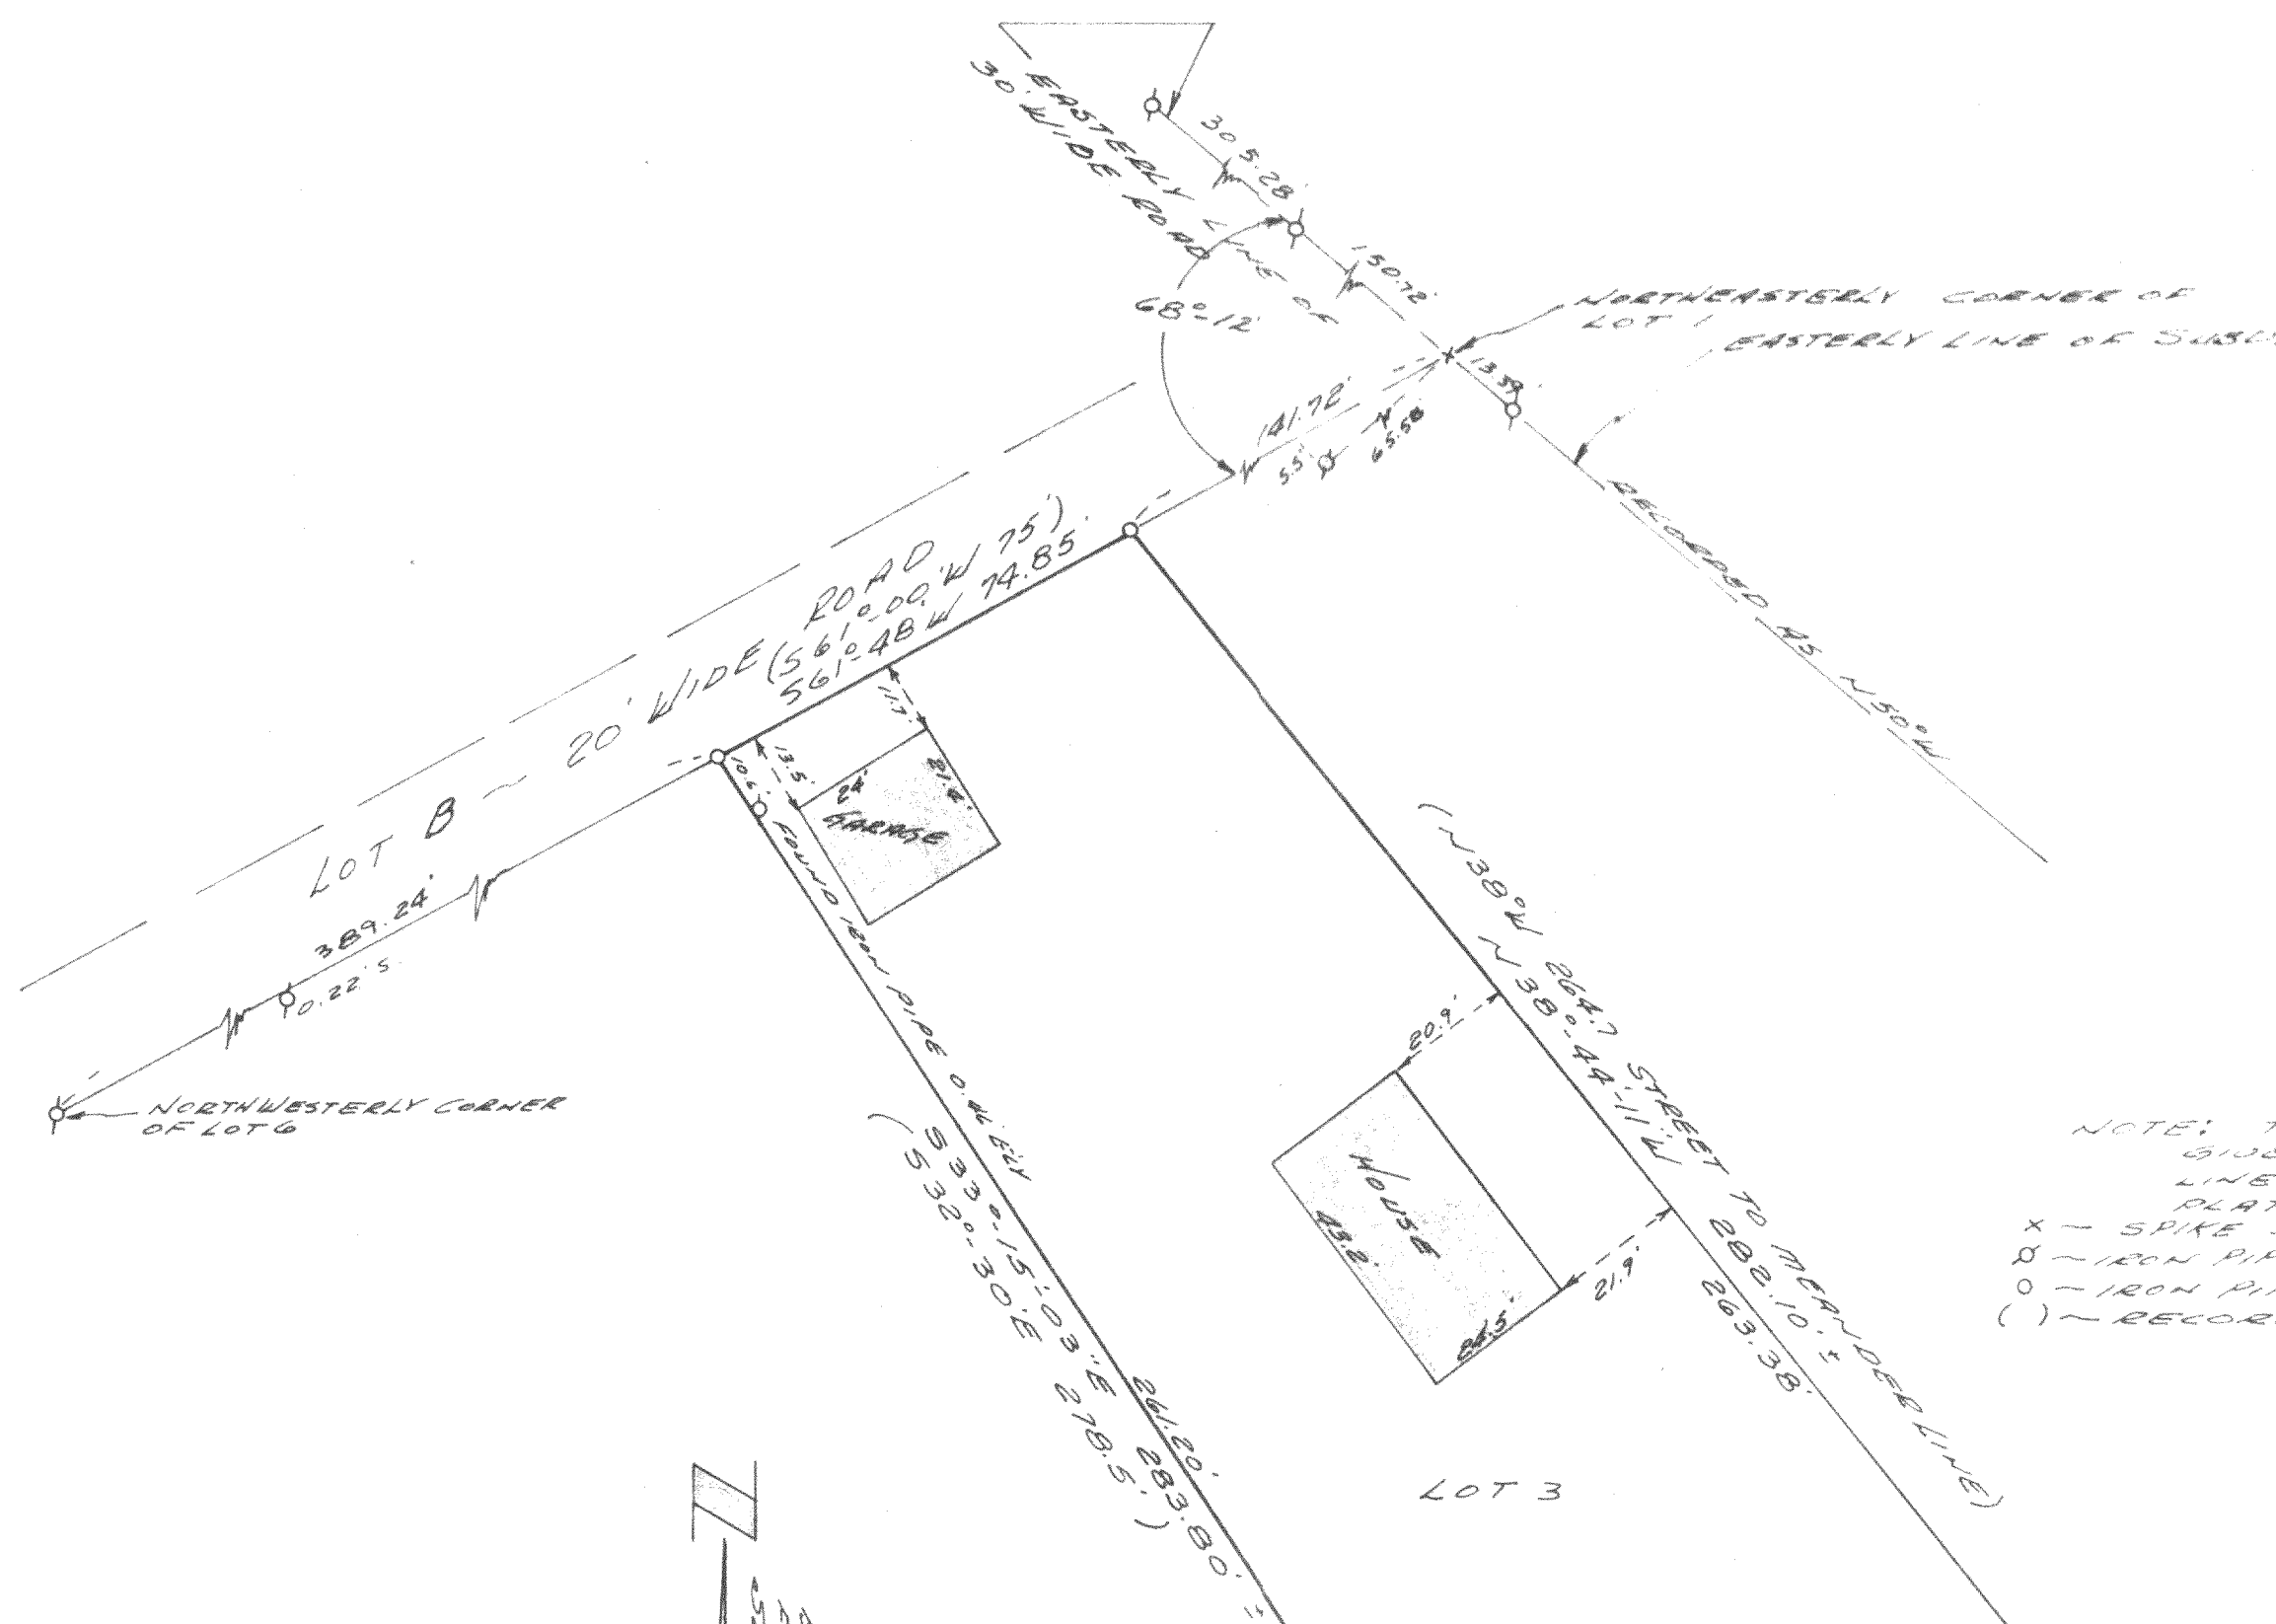

I CERTIFY: THAT I HAVE SURVEYED LOT 3, LAKE BEULAH COUNTRY CLUB SUBDIVISION AND THAT THE PLAT SHOWN HEREON IS AN ACCURATE SURVEY AND A TRUE REPRESENTATION THEREOF AND CORRECTLY SHOWS THE EXTERIOR BOUNDARY LINES OF SAID PROPERTY, AND BUILDINGS THEREON.

OCT. 10, 1992

THOMAS P. A. JENSEN
THOMAS P. A. JENSEN
WIS. REGISTERED
LAND SURVEYOR,
NO. 5-1084

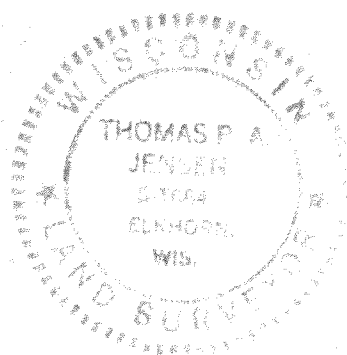

SOUTHWESTERLY CORNER OF LOT 6 ON MEANDER LINE

NOTE: SET IRON PIPE FALLS ON FENCE LINE

PLAT OF SURVEY OF

LOT 3, LAKE BEULAH COUNTRY CLUB SUBDIVISION, LOCATED IN SECTION 18, T4N, R18E, WALWORTH COUNTY, WISCONSIN.

THOMAS P. A. JENSEN
SURVEYOR

SCALE 1" = 30'

DATE OCT. 1992

418-147-J

418-147 J