

AMERICAN SURVEYING COMPANY, INC.

LAND SURVEYORS
12207 C.T.H. "K" FRANKSVILLE, WISCONSIN 53126
TEL. (262) 835-4774 FAX: (262) 835-2379


PLAT OF SURVEY

PREPARED FOR: BADGER HOME BUILDERS, INC.


OWNERS: MICHAEL & MONICA RICE

DESCRIPTION:


LOT 13, BLOCK 2 OF "CLEARVIEW" BEING A PART OF THE SOUTHEAST 1/4 OF THE SOUTHEAST 1/4 OF SECTION 18, TOWN 4 NORTH, RANGE 18 EAST, IN THE TOWN OF EAST TROY, COUNTY OF WALWORTH, STATE OF WISCONSIN.

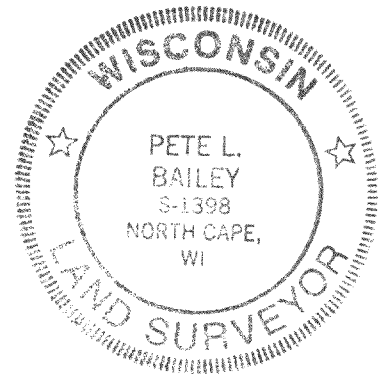

**OAK RIDGE
DRIVE**

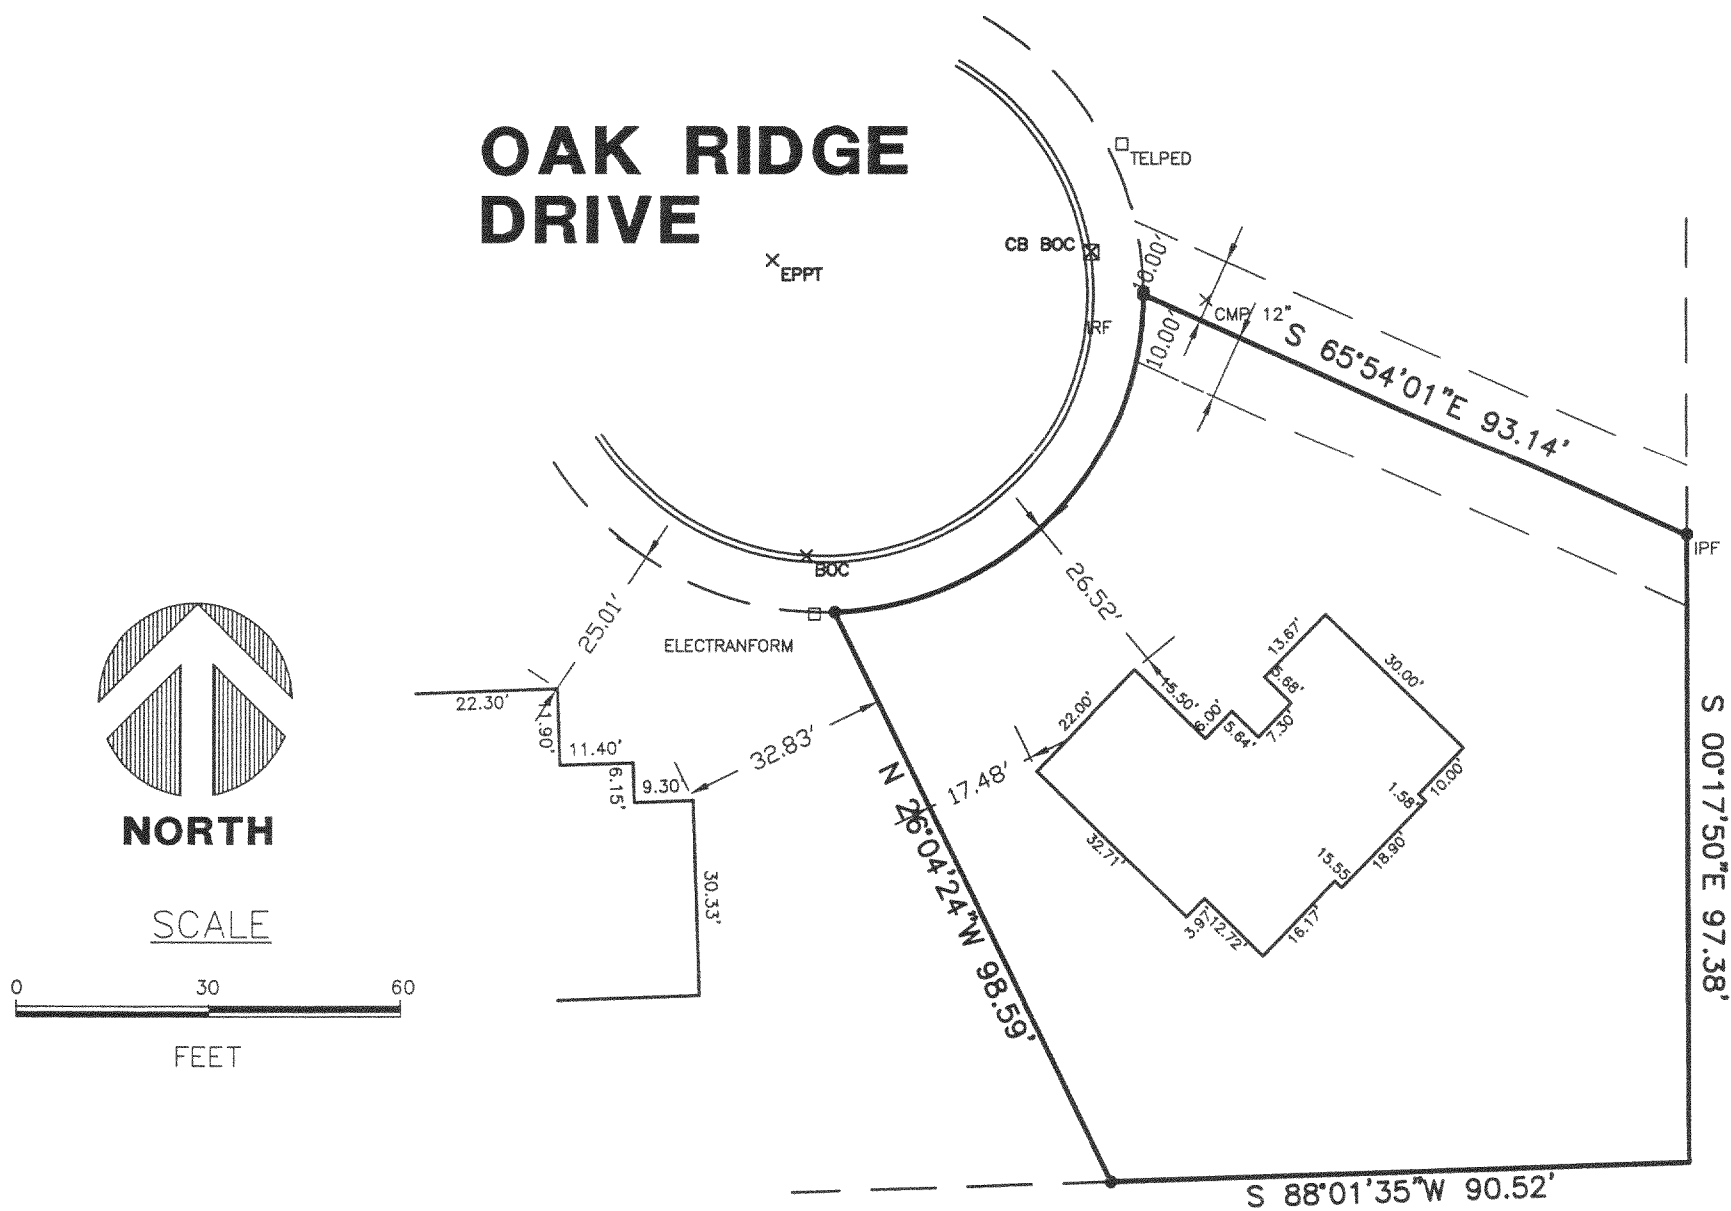

-DWELLING UNDER CONSTRUCTION
-TOP OF WALL: 868.30

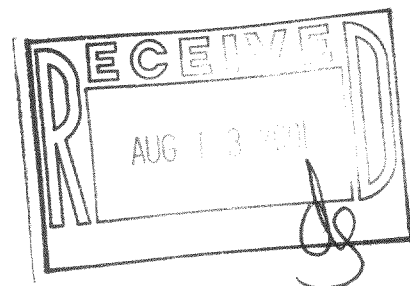

STATE OF WISCONSIN
COUNTY OF RACINE

I hereby certify that I have surveyed the above described property and the above map is a true representation thereof and shows the size and location of the property, its exterior boundaries, the location of all visible structures and dimensions of all principle buildings thereon, boundary fences, apparent easements, roadways and visible encroachments, if any.

This survey is made for the present owners of the property, and also those who purchase, mortgage, or guarantee the title thereto within one (1) year from the date thereof.

Dated at NORTH CAPE, WISCONSIN, this 2 ND day of FEBRUARY, 2001.

Recertified JULY 10TH, 20001

Registered Land Surveyor

JOB NO. 01.012

DRAWING NAME: JN201033

DRAWN BY: PLB
CHECKED BY: PLB

PCV-24

Pete L. Bailey