

PLAT OF SURVEY

RSV ENGINEERING, INC
ENGINEERS, PLANNERS, SURVEYORS
CONSTRUCTION MANAGERS
ENVIRONMENTAL SCIENTISTS
801 MAIN STREET, MUKWONAGO, WISCONSIN 53149 (262) 363-2004

FOR: JUDY SKOTARZAK

DATE: 01-17-02


DESCRIPTION: LOT 4 OF CHAMBERLAIN SUBDIVISION, LOCATED IN THE NW¹/₄ OF SECTION 9, TOWN 4 NORTH, RANGE 18 EAST, TOWN OF EAST TROY, WALWORTH COUNTY, WISCONSIN.

LEGEND

	CONCRETE AREA
CO	CLEAN OUT
ST	SEPTIC TANK COVER
SV	SEPTIC VENT
	MONUMENT FOUND
IP	SET 1.25" IRON PIPE
	FOUND 1/2" IRON PIPE
PK	FOUND PK NAIL
P	PILLAR
	POWER POLE



SCALE: 1" = 40'

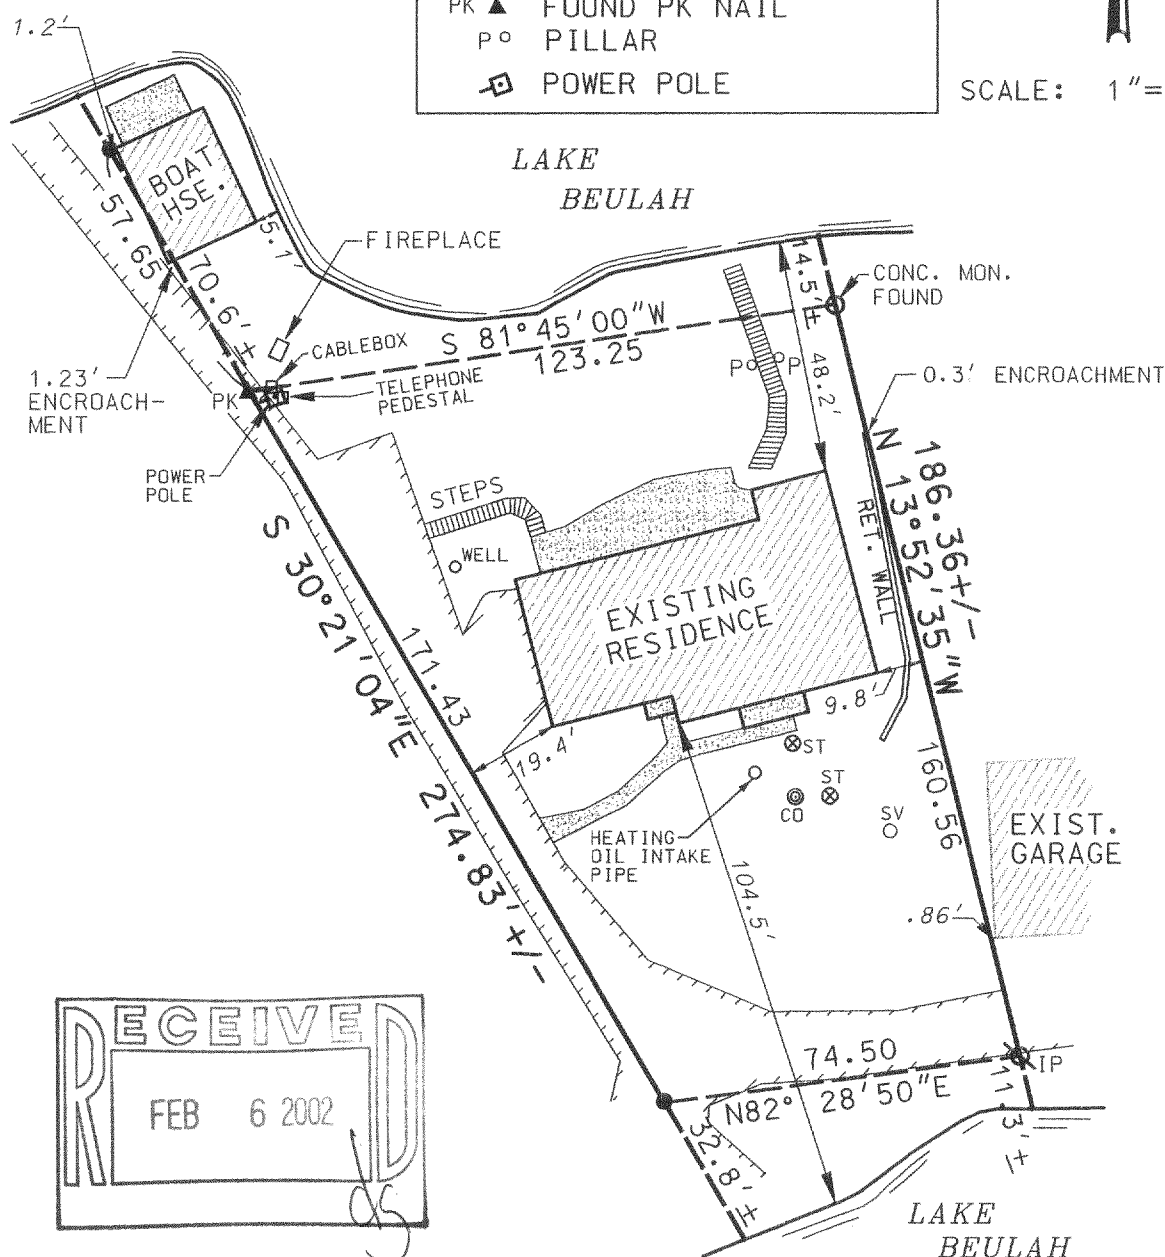


THE ABOVE MAP IS A TRUE REPRESENTATION THEREOF AND SHOWS THE SIZE AND LOCATION OF ALL THE PROPERTY, EXTERIOR BOUNDARIES, THE LOCATION OF ALL VISIBLE BOUNDARY FENCES, APPARENT EASEMENTS, ROADWAYS AND VISIBLE ENCROACHMENTS, IF ANY.

THIS SURVEY IS MADE FOR THE USE OF THE PRESENT OWNERS OF THE PROPERTY, AND ALSO THOSE WHO PURCHASE, MORTGAGE OR GUARANTEE TITLE THERETO WITHIN ONE (1) YEAR FROM DATE HERETO.

BRADFORD L. SPENCER, R.L.S. 2069
RSV#02-011

THIS IS ORIGINAL
PRINT ONLY IF
SEAL IS IMPRINTED
IN RED

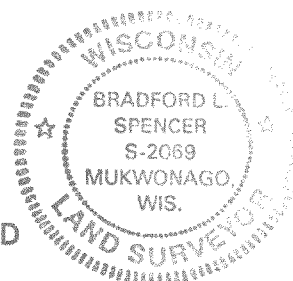

PCT-4 ✓ 418-1524