

PLAT OF SURVEY

RSV
ENGINEERING, INC.

Engineers • Land Surveyors • Environmental Scientists
801 MAIN STREET MUKWONAGO, WISCONSIN 53149 (262)363-2004

FOR: JOHN & CHRISTI CLANCY

DATE: 1/14/02



DESCRIPTION: THE NORTH $\frac{1}{2}$ OF LOT 8, THE SUBDIVISION OF LOT 10 OF BEULAH LAKE PARK, BEING IN SECTION 4, TOWN 4 NORTH, RANGE 18 EAST, TOWN OF EAST TROY, WALWORTH COUNTY, WISCONSIN.

LEGEND

●	SET 1" IRON PIPE
— x —	FENCE
SVO	SEPTIC VENT
▨	CONCRETE WALK
////	EDGE OF PAVEMENT
P/L	PROPERTY LINE

SET SPIKE IN
30" STUMP 4' +/-
ABOVE GROUND

SCALE 1" = 40'

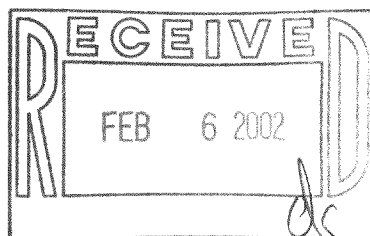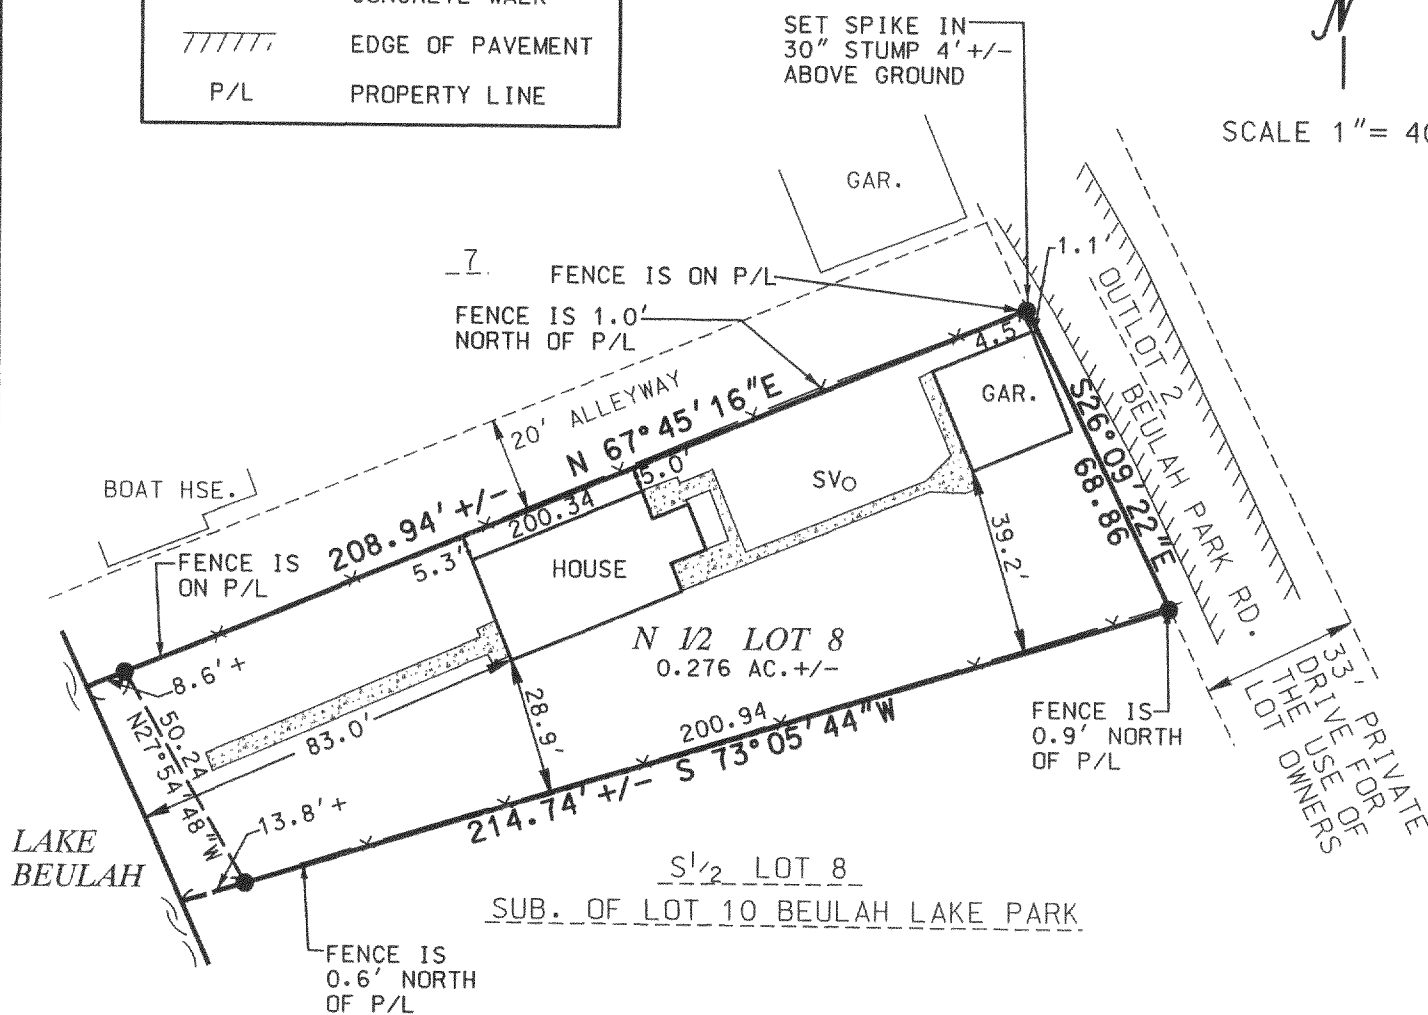


THE ABOVE MAP IS A TRUE REPRESENTATION THEREOF AND SHOWS THE SIZE AND LOCATION OF ALL THE PROPERTY, EXTERIOR BOUNDARIES, THE LOCATION OF ALL VISIBLE BOUNDARY FENCES, APPARENT EASEMENTS, ROADWAYS AND VISIBLE ENCROACHMENTS, IF ANY.

THIS SURVEY IS MADE FOR THE USE OF THE PRESENT OWNERS OF THE PROPERTY, AND ALSO THOSE WHO PURCHASE, MORTGAGE OR GUARANTEE TITLE THERETO WITHIN ONE (1) YEAR FROM DATE HERETO.

BRADFORD L. SPENCER, R.L.S. 2069
RSV#02002

THIS IS ORIGINAL
PRINT ONLY IF
SEAL IS IMPRINTED
IN RED

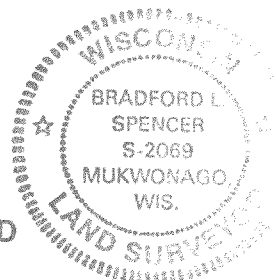

PBLA-8 ✓ 418-1525