




026227
026227S1.DWG

PLAT OF SURVEY

PREPARED FOR: COUNTRY VIEW HOMES
8277 POINT DRIVE
WIND LAKE, WI 53185

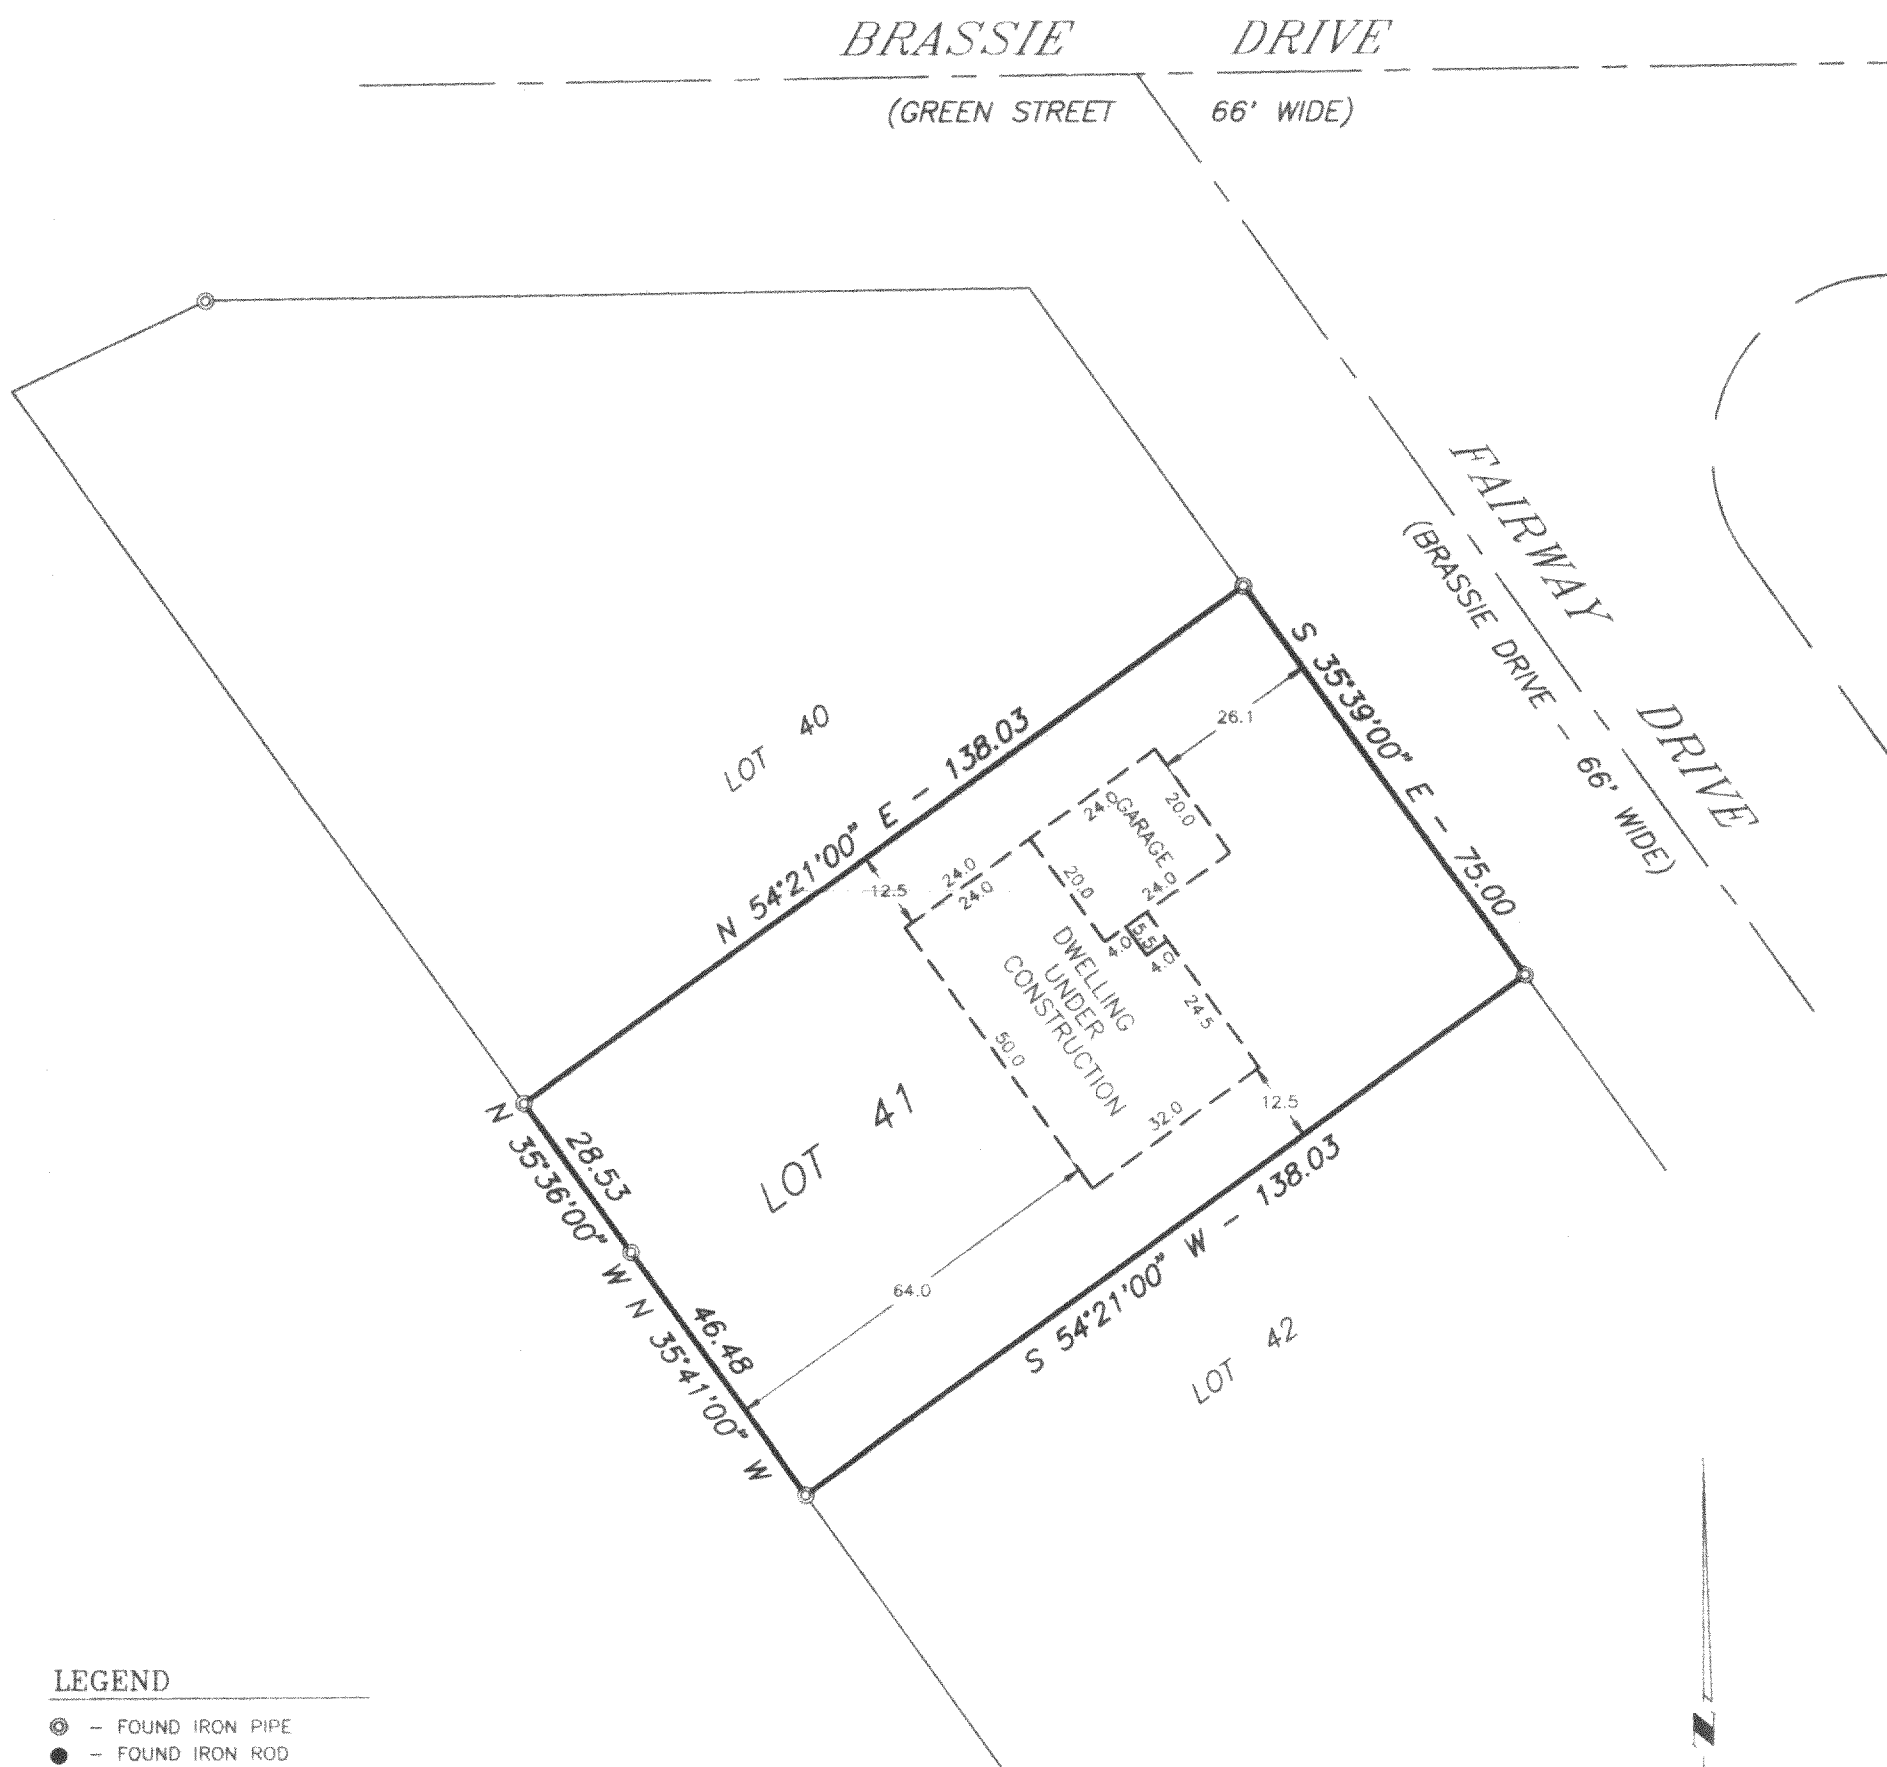

⊙ — FOUND IRON PIPE
 ● — FOUND IRON ROD
 ○ — SET IRON PIPE
 —x—x— — FENCE
 () — RECORDED AS
 ♦ — SOIL BORING

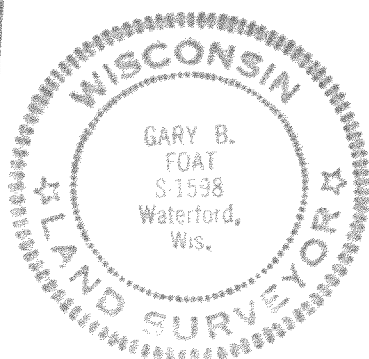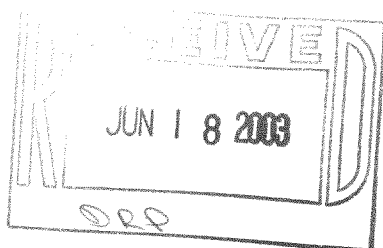

I HEREBY CERTIFY THAT I HAVE SURVEYED THE ABOVE DESCRIBED PROPERTY AND THE ABOVE MAP IS A TRUE REPRESENTATION THEREOF AND SHOWS THE SIZE AND LOCATION OF THE PROPERTY, THE LOCATION OF ALL VISIBLE STRUCTURES AND DIMENSIONS OF ALL PRINCIPAL BUILDINGS THEREON, BOUNDARY FENCES, APPARENT EASEMENTS, ROADWAY AND VISIBLE ENCROACHMENTS, IF ANY.

THIS SURVEY IS MADE FOR THE PRESENT OWNERS OF THE PROPERTY, AND ALSO THOSE WHO PURCHASE, OR GUARANTEE THE TITLE THERETO WITHIN (1) YEAR FROM THE DATE HEREOF.

DATED AT WATERFORD THIS 22ND DAY OF JULY 2002

RECERTIFIED SEPTEMBER 20, 2002

SCALE: 1" = 30'

PF-41

418-1674