PREPARED FOR: BRIAN CRAITE N 82 W16060 VALLEY VIEW DR. MENOMONEE FALLS, WI.


PLAT OF SURVEY

-OF-

LOTS 63 AND 64, IN BLOCK ONE, IN WILMER GROVE BEACH, LYING AND BEING IN THE EAST1/2 OF SECTION 18, IN T4N, R18E, IN THE TOWN OF EAST TROY, WALWORTH COUNTY, WISCONSIN.

J.K. SURVEYING INC. N3705 WILLOWBEND LANE LAKE GENEVA, WI, 53147 262-248-3697



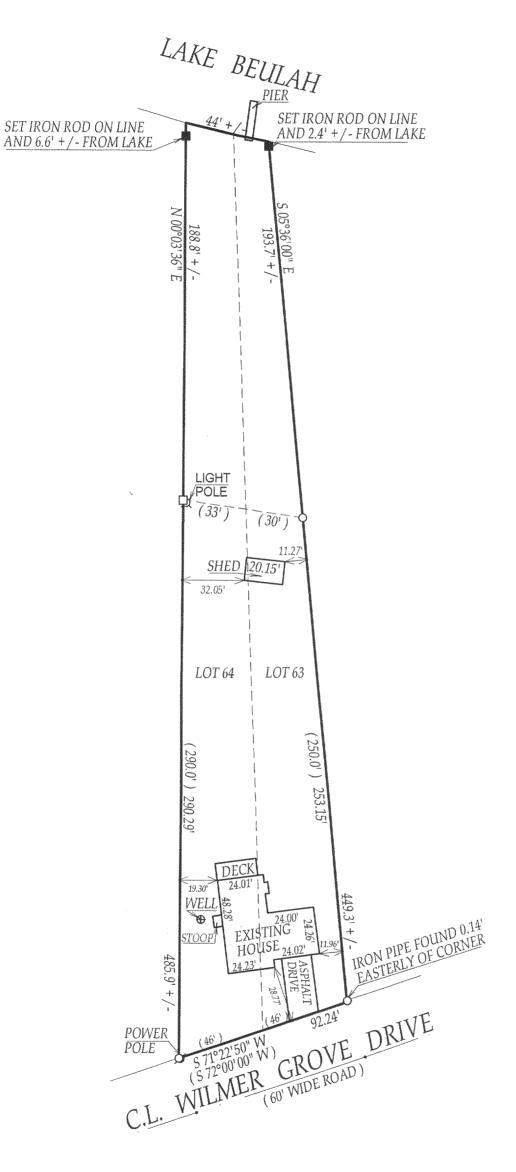



DOD

☐ = found iron bar

= found iron pipe

= set iron pipe

= set iron bar

SCALE 1" = 50'

JOB # 03-380


TAX ID # PWW 00031

COMPARE LEGAL DESCRIPTION ABOVE AND DRAWING WITH DEED. FOR BUILDING RESTRICTIONS AND EASEMENTS NOT SHOWN, REFER TO DEED, ABSTRACT SOURCES AND LOCAL MUNICIPAL CODES. NOTIFY THE SURVEYOR IMMEDIATELY OF ANY DISCREPANCY.

"I hereby certify that the above described property was surveyed under my supervision and that the above map is a true representation thereof and shows the size and location of all visible structures, apparent easements and encroachments if any."

This survey is made for the present owners of the property, and those who purchase, mortgage, or guarentee the title thereto, within one year from the date hereof.

DATED THE 29 TH, DAY OF JULY 2003

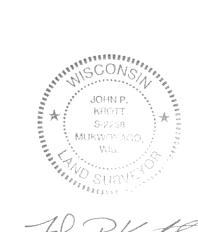

JOHN KROTT S - 2258 Wisconsin Registered Land Surveyor (original if signed in red)