


"RECERTIFICATION"

SURVEY FOR: WOLTER BROS. BUILDERS

REID

DESCRIPTION: LOT 1 CERTIFIED SURVEY MAP NO. 3120, being part of the Northwest 1/4 of the Southeast 1/4 and the Southwest 1/4 of the Northeast 1/4 of Section 34, Township 4 North, Range 18 East, of the Fourth Principal Meridian, in the Township of East Troy, Walworth County, Wisconsin.

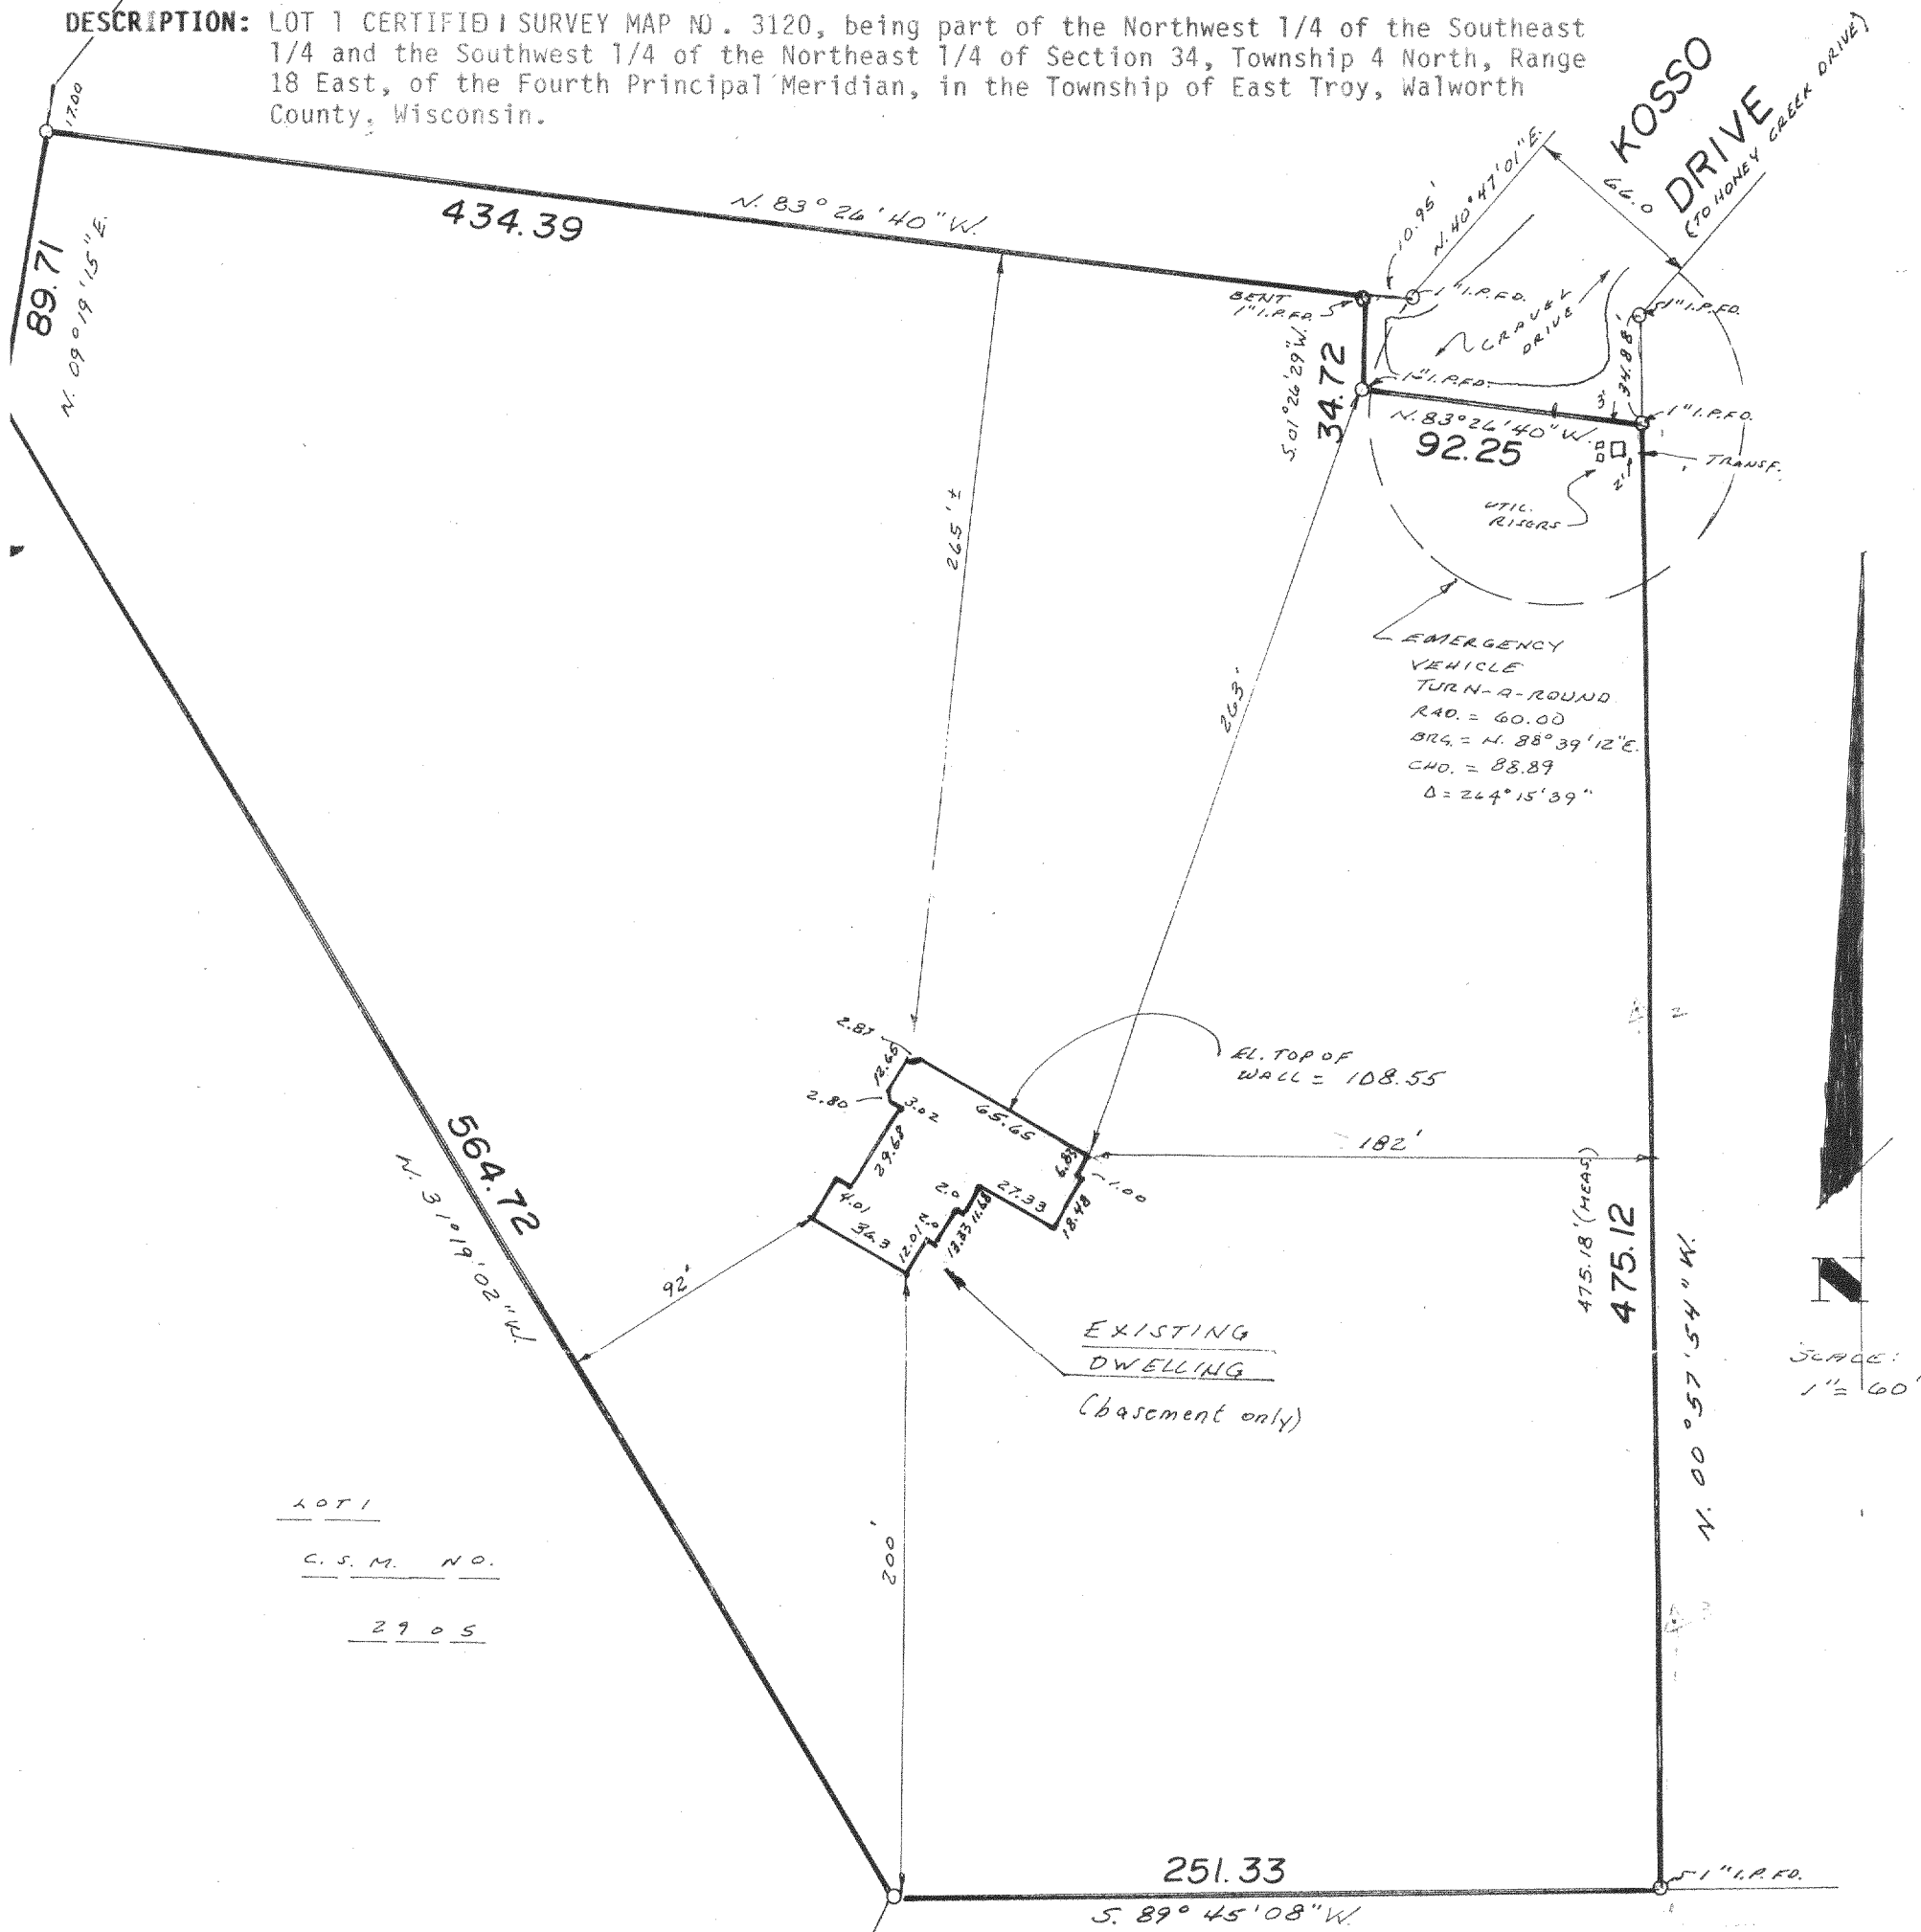

SURVEY CERTIFICATE

State of Wisconsin)
Milwaukee County)ss



We, Interline Survey Services, Inc., certify that we have surveyed the above described property and the above map is a true representation thereof, and shows the size and location of the property, its exterior boundaries, the location and dimensions of all visible structures thereon, fences, apparent easements and roadways and visible encroachments, if any.

This survey is made for the exclusive use of the present owners of the Property, and also those who purchase, mortgage, or guarantee the title thereto, within one (1) year from date hereof.

Wisconsin Registered Land Surveyor

NOTE:
PROPOSED DWELLING IS ROUGH STAKED
FOR CLEARING.

DATED: 7/11/03
JOB NO. 29482

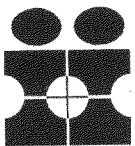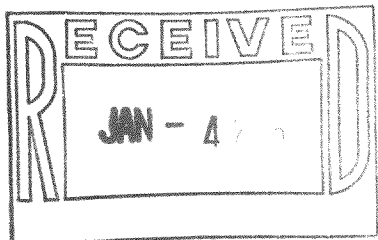

**INTERLINE SURVEY
SERVICES, INC.**

10521 W. FOREST HOME AVE. STE. 201
HALES CORNERS, WI 53130
PHONE 425-2060

PA3120-1

418-1823