

PLAT OF SURVEY
OF

LOTS 26, 27 & 28, BLOCK 5, WILMER GROVE BEACH, LOCATED IN THE EAST HALF OF SECTION 18,
T. 4 N., R. 18 E. OF THE 4TH P.M., TOWNSHIP OF EAST TROY, WALWORTH COUNTY, WISCONSIN.



I HEREBY CERTIFY THAT I HAVE SURVEYED THE LAND DESCRIBED ABOVE AND THAT THE PLAT
DRAWN HEREON IS A CORRECT REPRESENTATION OF SAID SURVEY.

John F. Degen
JOHN F. DEGEN, LAND SURVEYOR # 242
589 N. PINE ST., BURLINGTON, WISCONSIN.

5-7-73

SCALE 1" = 30'

o = IRON PIPE STAKE

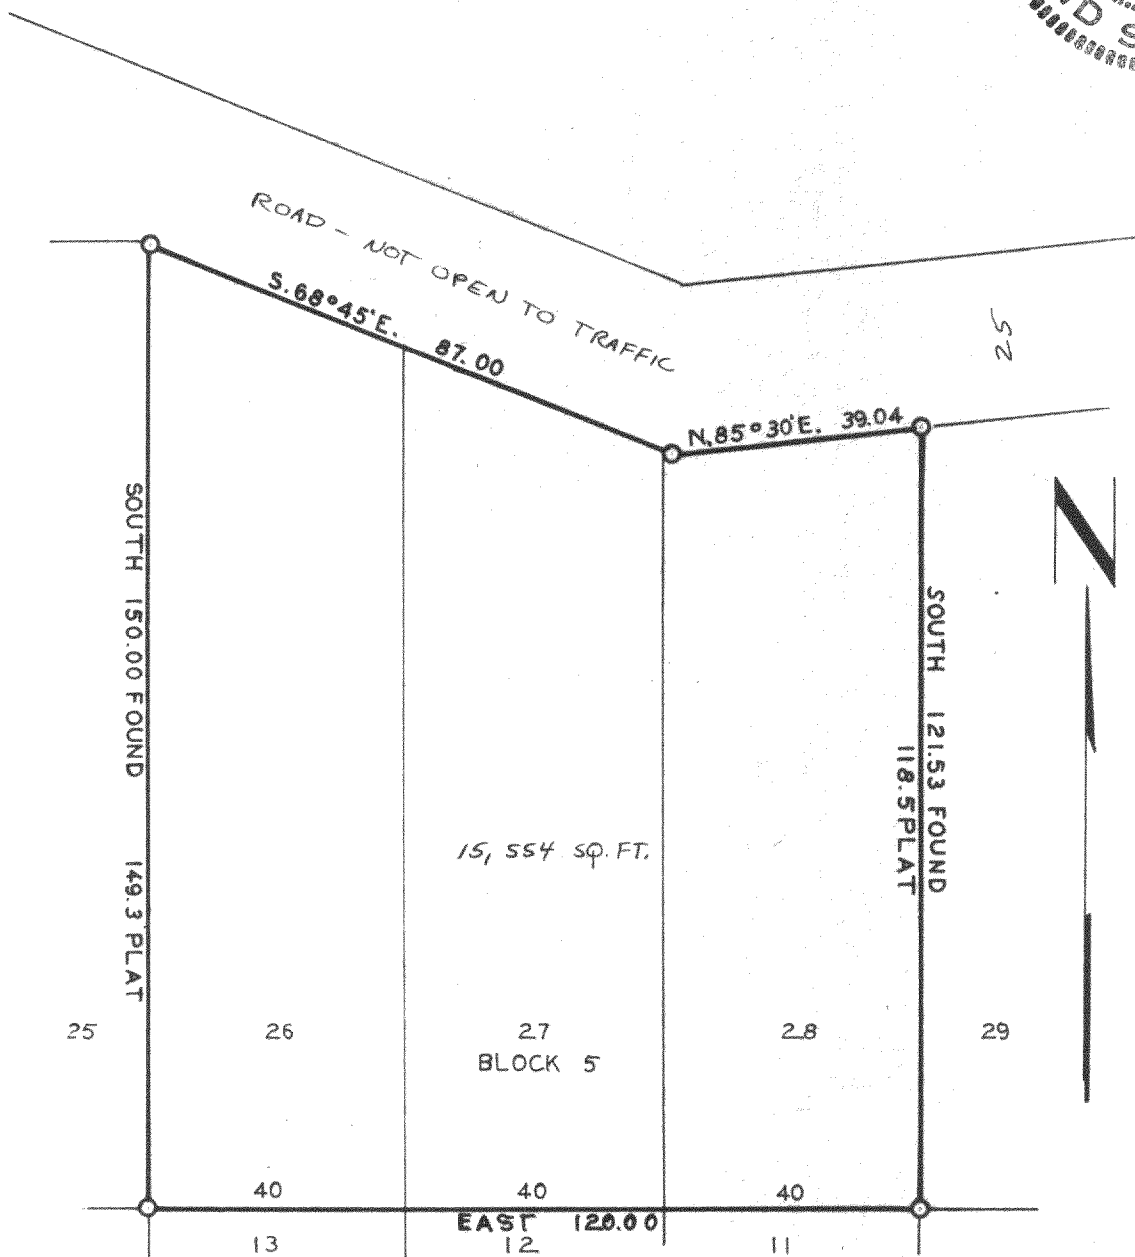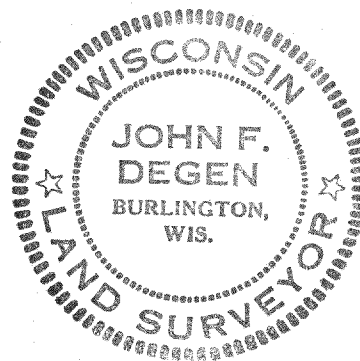

6-7-73

DRAWER 1-C-4

418-183
29