"RECERTIFICATION"

I lat of Survey

Survey For:


WOLTER BROS. BUILDER

Location:

HARMONY LANE

PATTERSON

Description: LOT 6 MIRAMAR ADDITION NO. 2, being a subdivision of the N.E.1/4 of Section 10 and the N.W. 1/4 of Section 11, Town 4 North, Range 18 East, in the Town of East Troy, Walworth County, Wisconsin.

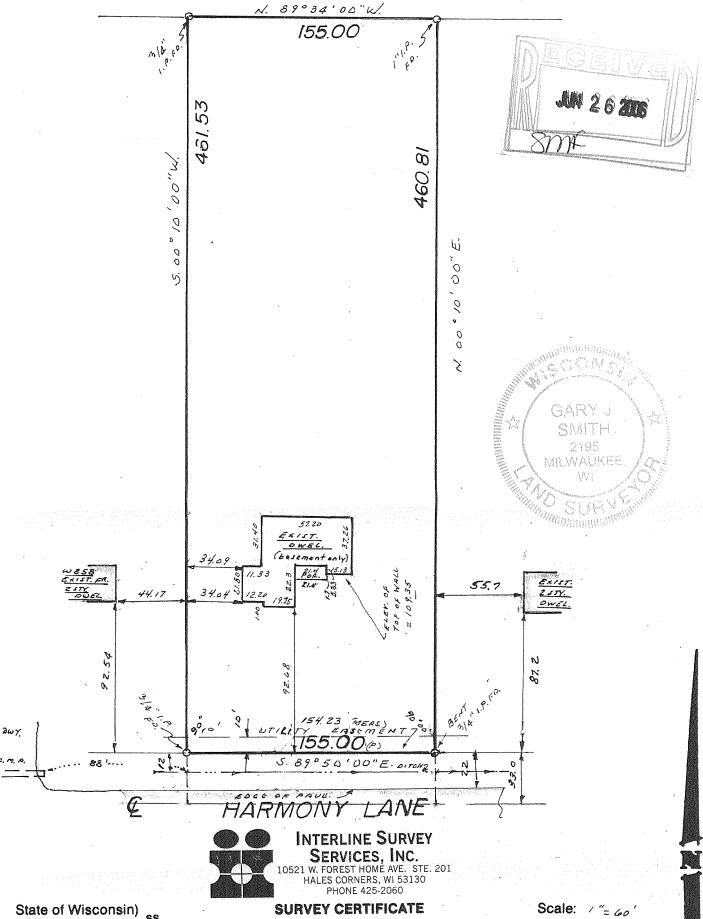

Milwaukee County

We, Interline Survey Services, Inc., certify that we have surveyed the above described property and the above map is a true representation thereof, and shows the size and location of the property, its exterior boundaries, the location and dimensions of all visible structures thereon, fences, apparent easements and roadways and visible encroachments, if any.

This survey is made for the exclusive use of the present owners of the Property, and also those who purchase, mortgage, or guarantee the title thereto, within one (1) year from date hereof.

Wisconsin Registered Land Surveyor

Date: 2/22/05 30345 Job No.:

N135207